



19+440.0

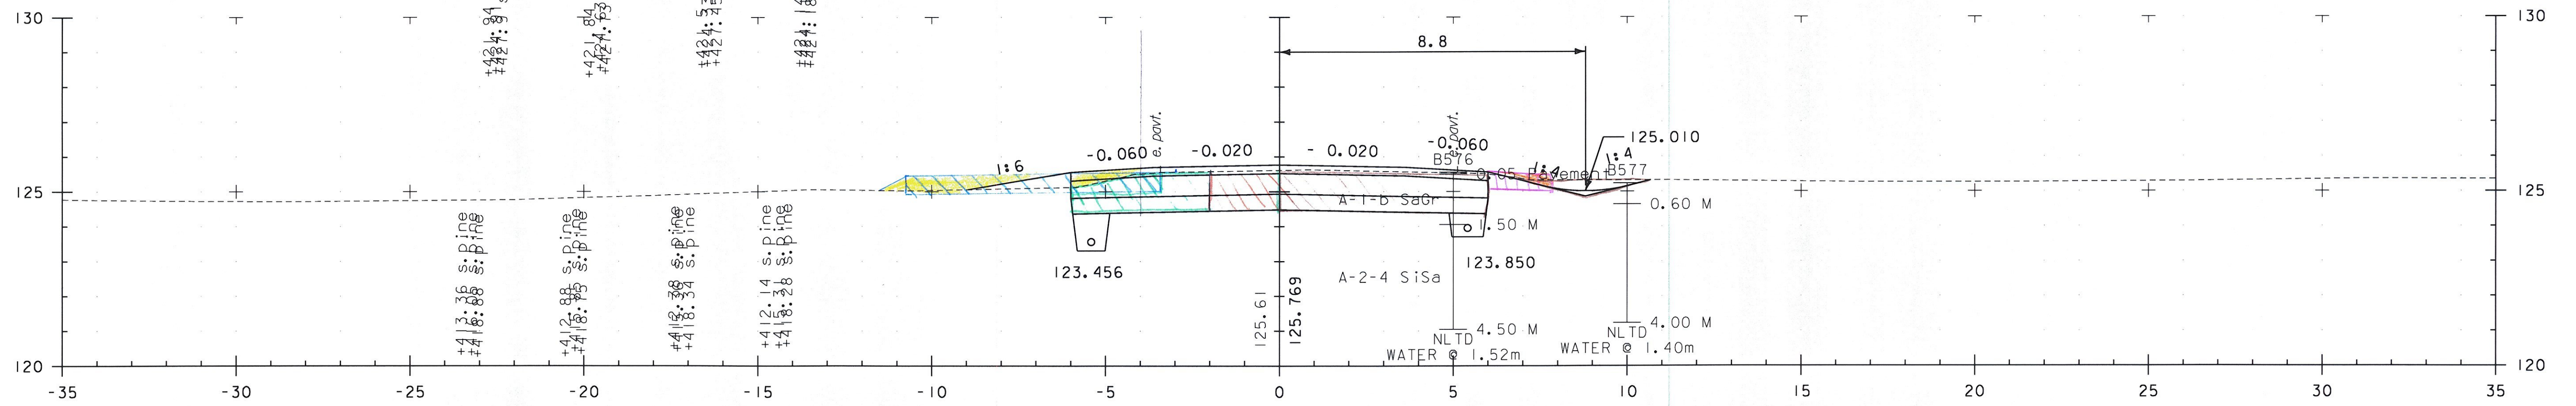


19+420.0

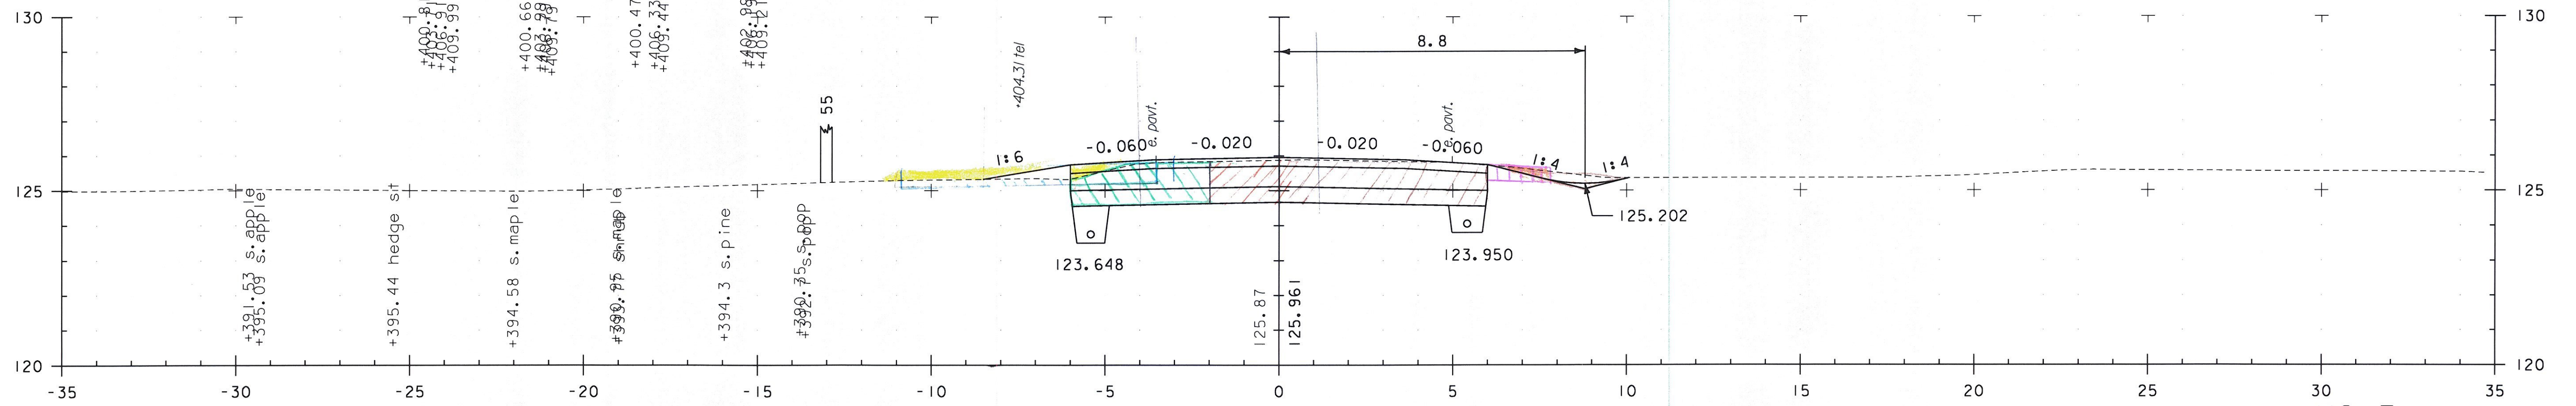

19+400.0

US 7

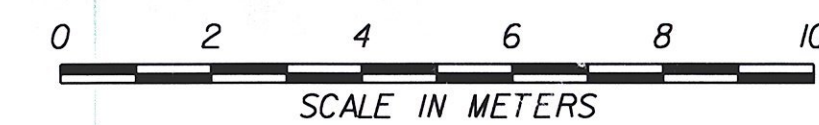

PROJECT NAME: BRANDON  
PROJECT NUMBER: NH 019-3(495)

FILE NAME: zb008s5-xs208.dgn  
PROJECT LEADER: CRB  
DESIGNED BY: PTS  
CLD 02-0149

PLOT DATE: 9/3/2009  
DRAWN BY: NLL  
CHECKED BY: DAM  
SHEET 479 OF 546