


19+740.0

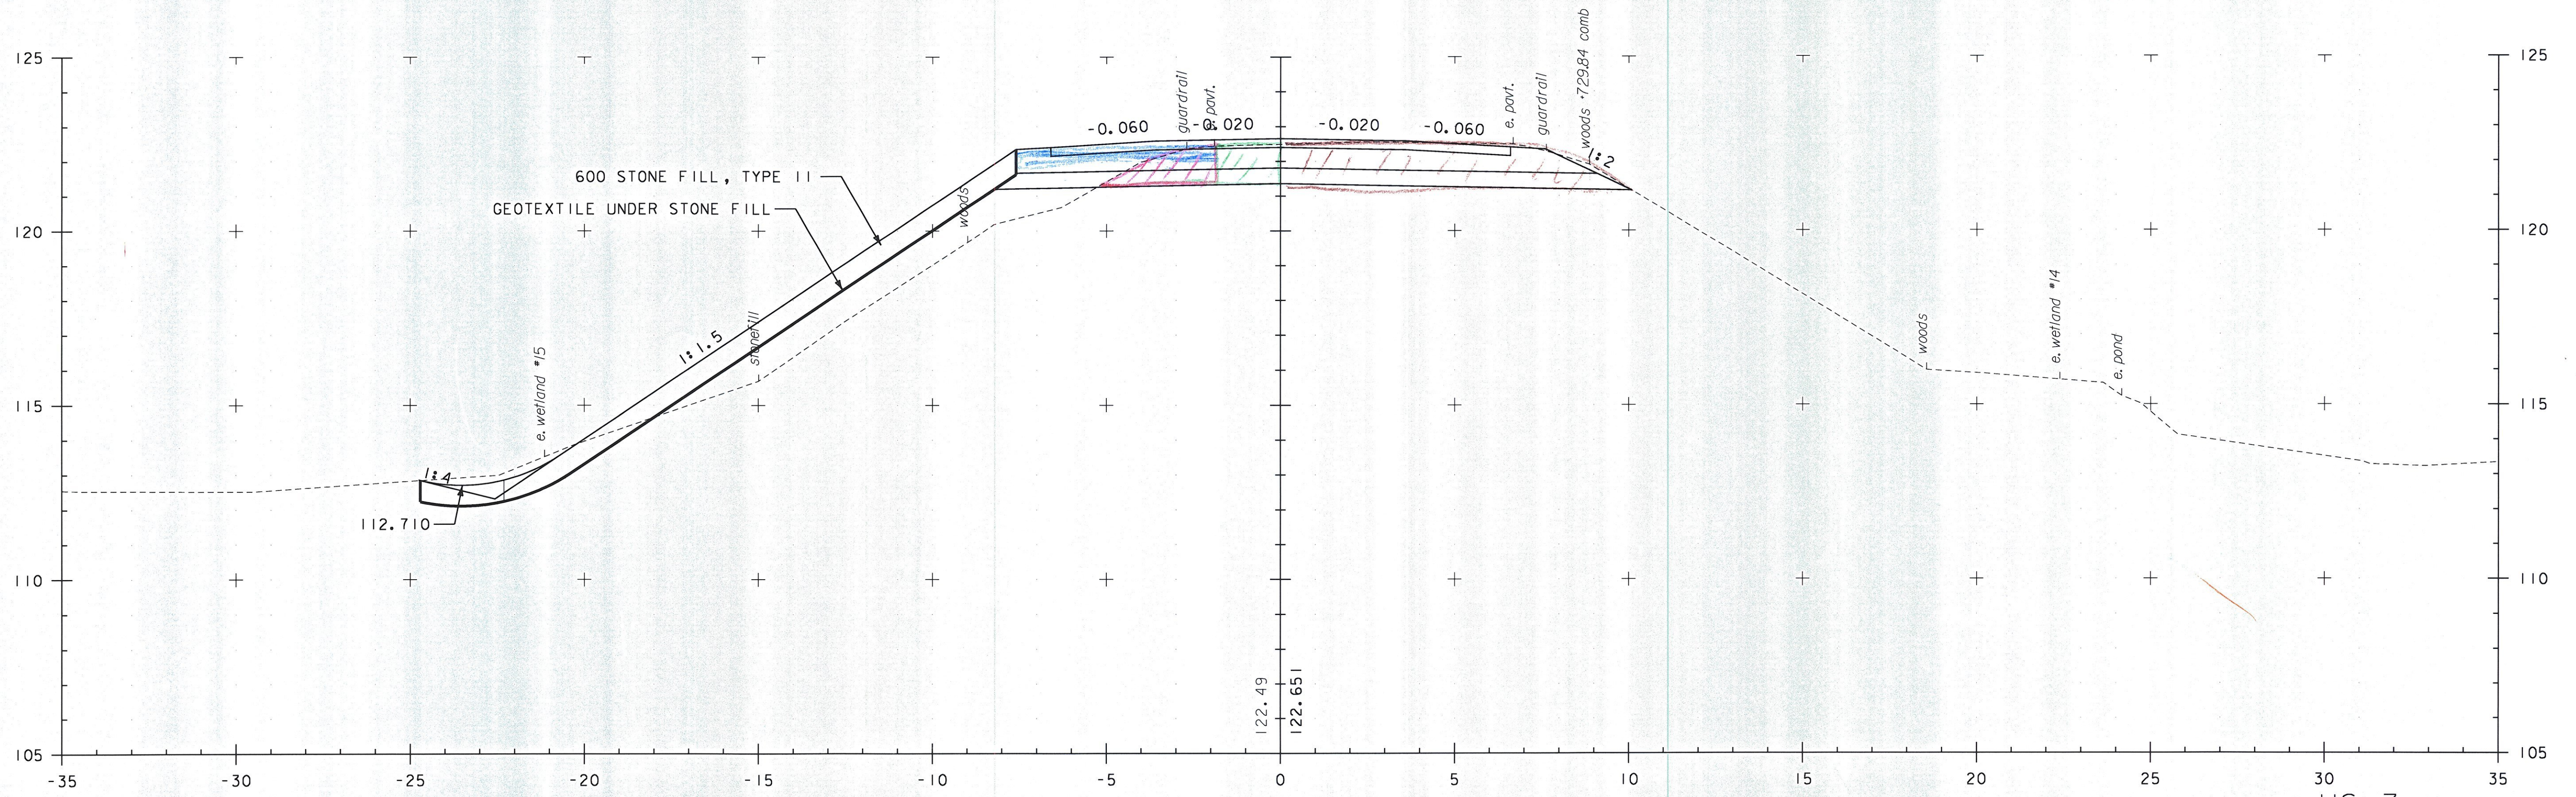

19+720.0

600 STONE FILL, TYPE II
GEOTEXTILE UNDER STONE FILL

US 7



PROJECT NAME: BRANDON	PLOT DATE: 9/3/2009
PROJECT NUMBER: NH 019-3(495)	DRAWN BY: NLL
FILE NAME: zb008s5-xs217.dgn	CHECKED BY: DAM
DESIGNED BY: PTS	SHEET 488 OF 546
CLD 02-0149	