


19+760.0

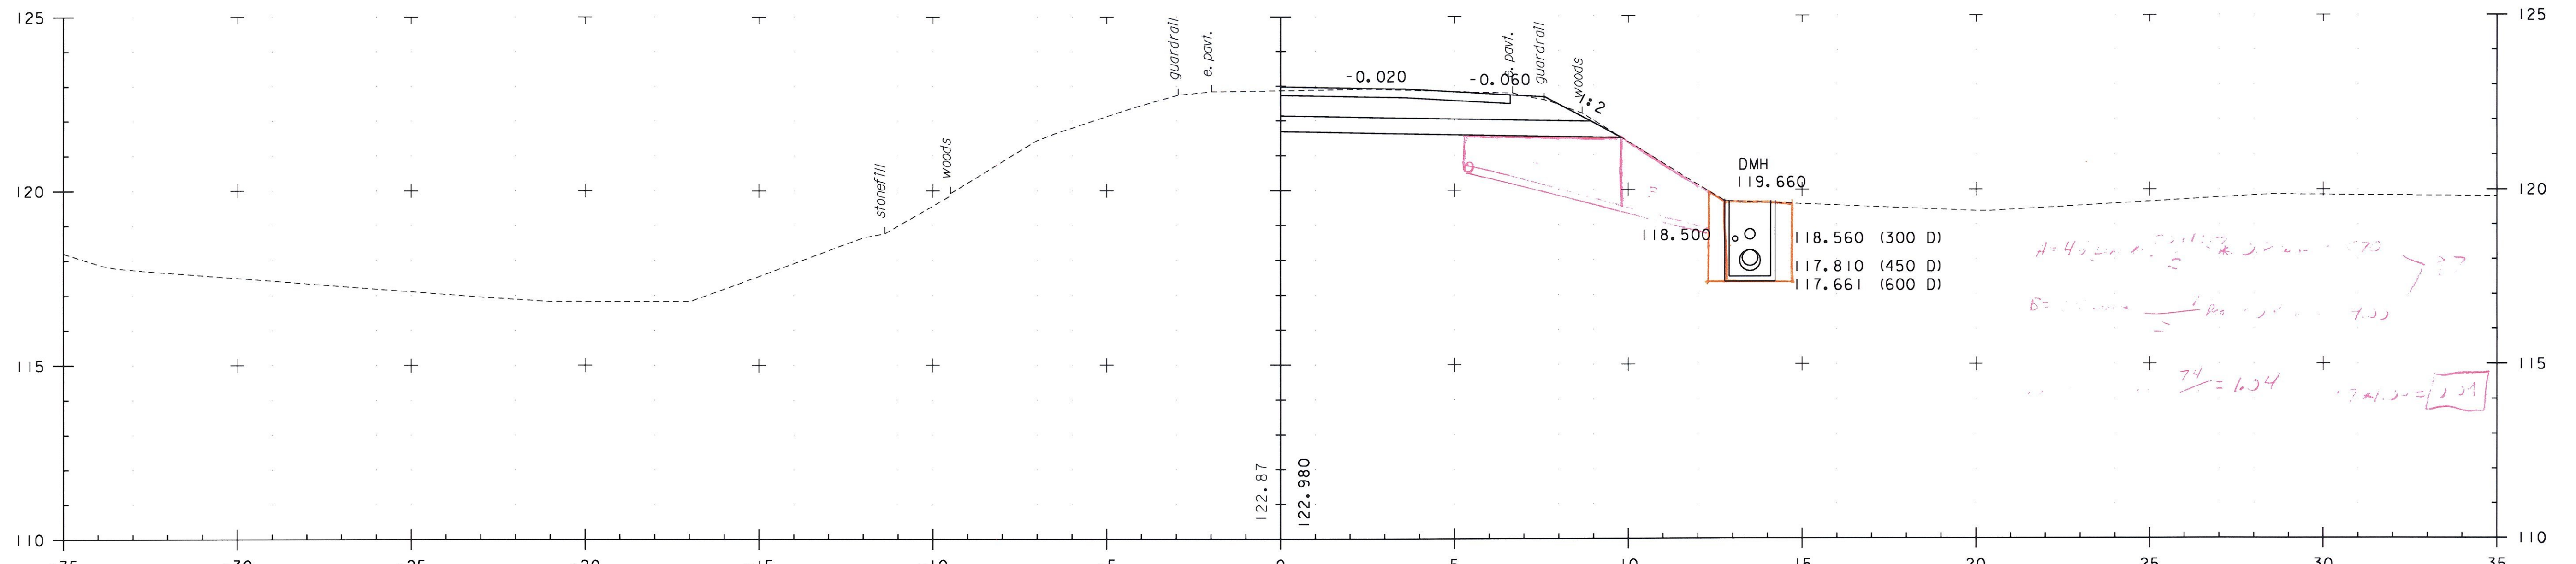

19+745.0

*A = 4.0 m*  
*B = 1.5 m*  
*74 = 1.24*  
*1.24 x 2 = 2.48*

US 7



PROJECT NAME:	BRANDON	PLOT DATE:	9/3/2009
PROJECT NUMBER:	NH 019-3(495)	DRAWN BY:	NLL
FILE NAME:	zb008s5-xs218.dgn	CHECKED BY:	DAM
PROJECT LEADER:	CRB	SHEET	489 OF 546
DESIGNED BY:	PTS		
CLD 02-0149			