



19+808.0
DRIVE LT

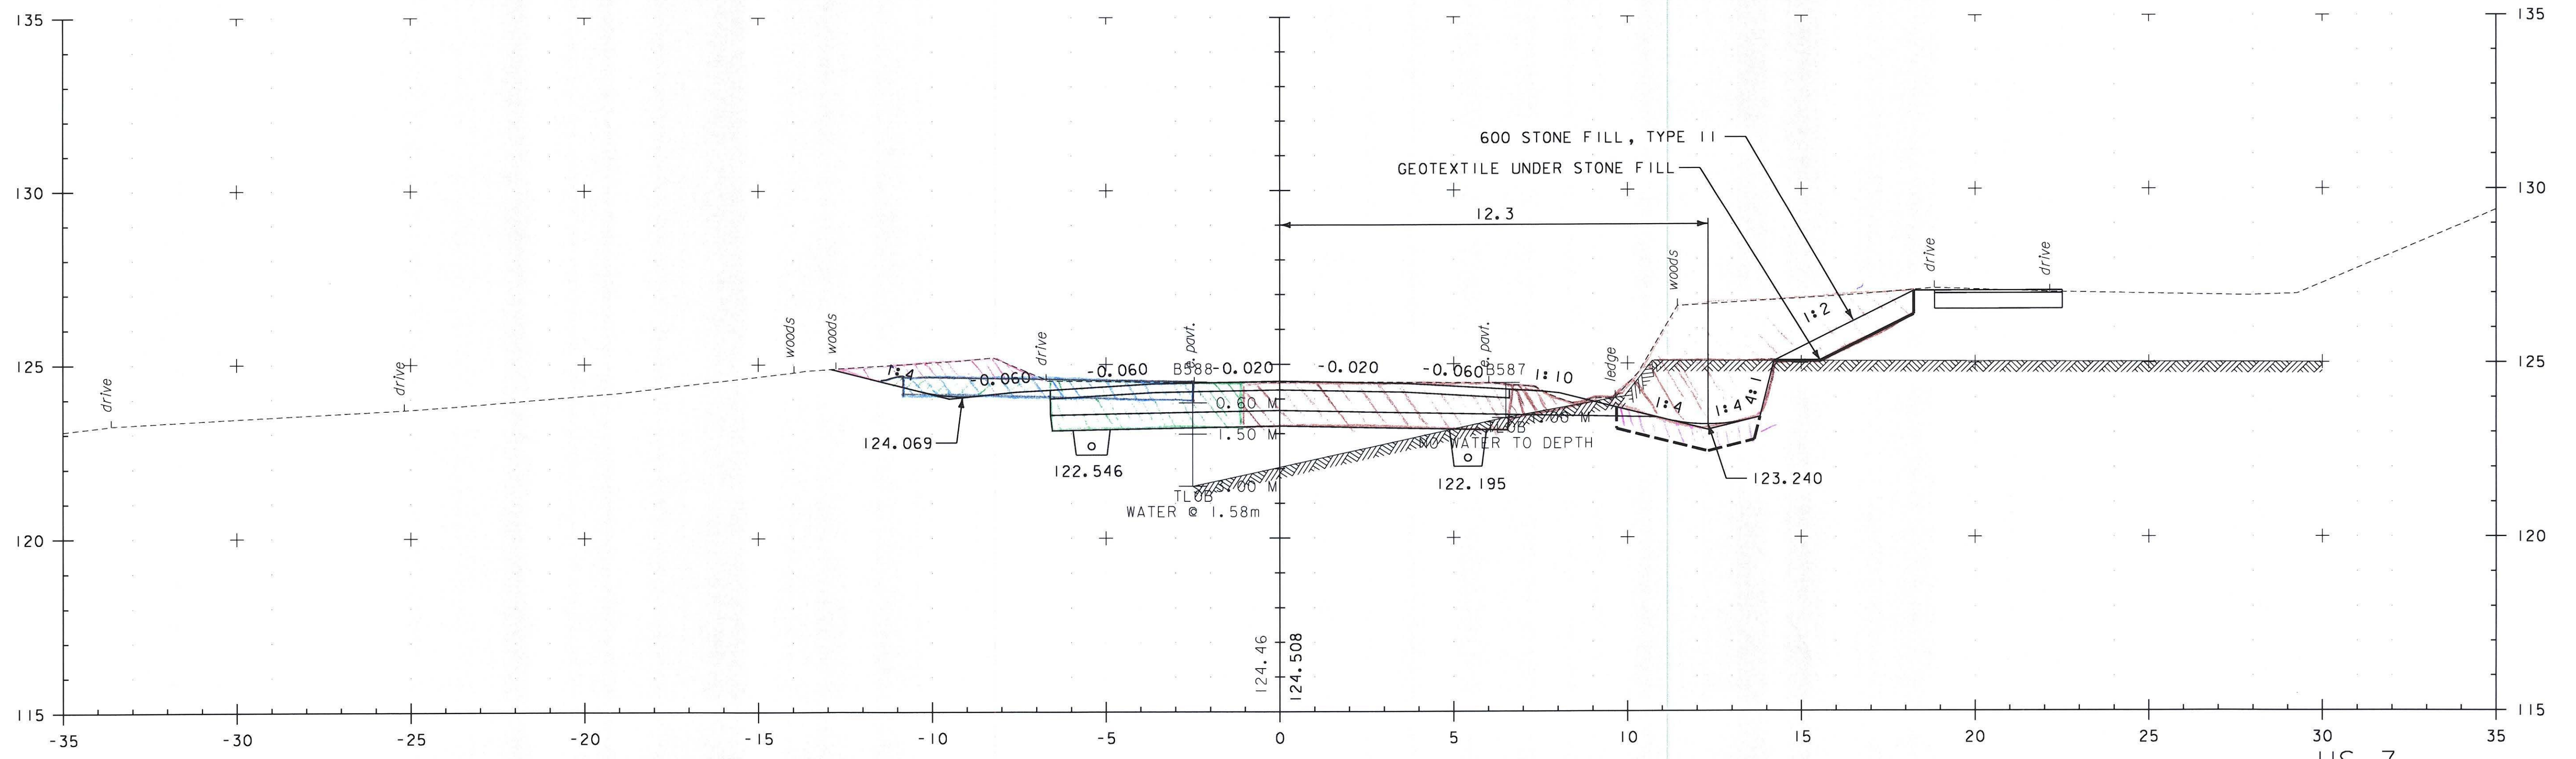

19+800.0

US 7

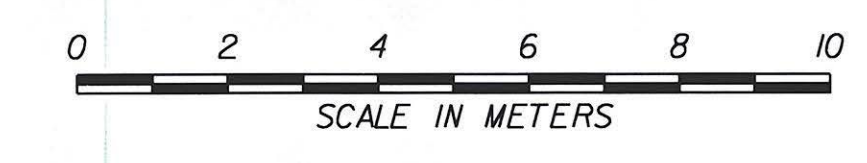

PROJECT NAME: BRANDON	PLOT DATE: 9/3/2009
PROJECT NUMBER: NH_019-3(495)	DRAWN BY: NLL
FILE NAME: zb008s5-xs220.dgn	CHECKED BY: DAM
PROJECT LEADER: CRB	SHEET 491 OF 546
DESIGNED BY: PTS	
CLD 02-0149	