


19+826.9
DETAIL "A"

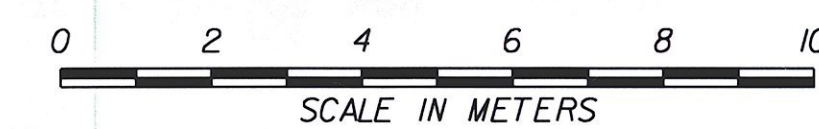

PROJECT NAME: BRANDON		PLOT DATE: 9/3/2009	
PROJECT NUMBER: NH 019-3(495)		DRAWN BY: NLL	
FILE NAME: zb008s5-xs222.dgn	DESIGNED BY: PTS	CHECKED BY: DAM	SHEET 493 OF 546
CLD 02-0149			

US 7