


20+260.0

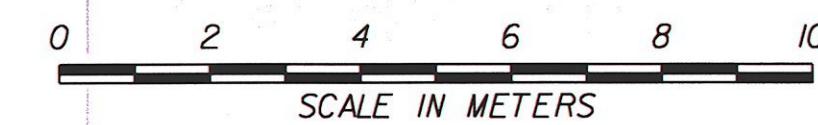

PROJECT NAME: BRANDON  
PROJECT NUMBER: NH 019-3(495)

FILE NAME: zb008s5-xs242.dgn  
PROJECT LEADER: CRB  
DESIGNED BY: PTS  
CLD 02-0149

PLOT DATE: 9/3/2009  
DRAWN BY: NLL  
CHECKED BY: DAM  
SHEET 513 OF 546