


20+460.0

US 7

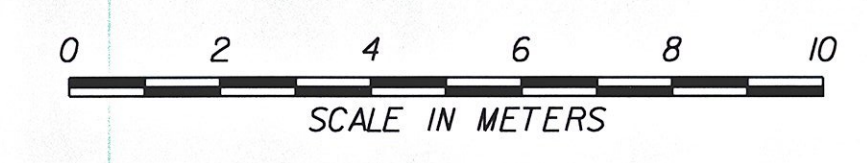

PROJECT NAME: BRANDON	PLOT DATE: 9/3/2009
PROJECT NUMBER: NH 019-3(495)	DRAWN BY: NULL
FILE NAME: zb008s5-xs257.dgn	CHECKED BY: DAM
PROJECT LEADER: CRB	SHEET 528 OF 546
DESIGNED BY: PTS	
CLD 02-0149	