


ADDITIONAL EXCAVATION DUE TO MAINTENANCE OF TRAFFIC
 MAINTENANCE OF TRAFFIC FINISH GRADE
 BACKFILL MAINTENANCE OF TRAFFIC DITCH AS SHOWN UPON COMPLETION OF PHASE 2 CONSTRUCTION

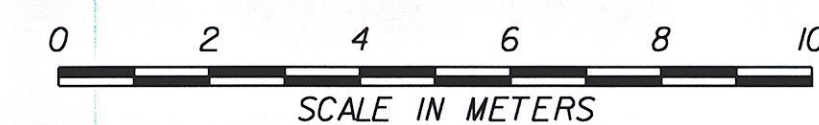

PROJECT NAME: BRANDON
 PROJECT NUMBER: NH 019-3(495)

FILE NAME: zb008s5-xs265.dgn
 PROJECT LEADER: CRB
 DESIGNED BY: PTS
 CLD 02-0149

PLOT DATE: 9/3/2009
 DRAWN BY: NLL
 CHECKED BY: DAM
 SHEET 536 OF 546