




2+032.0
DRIVE RT

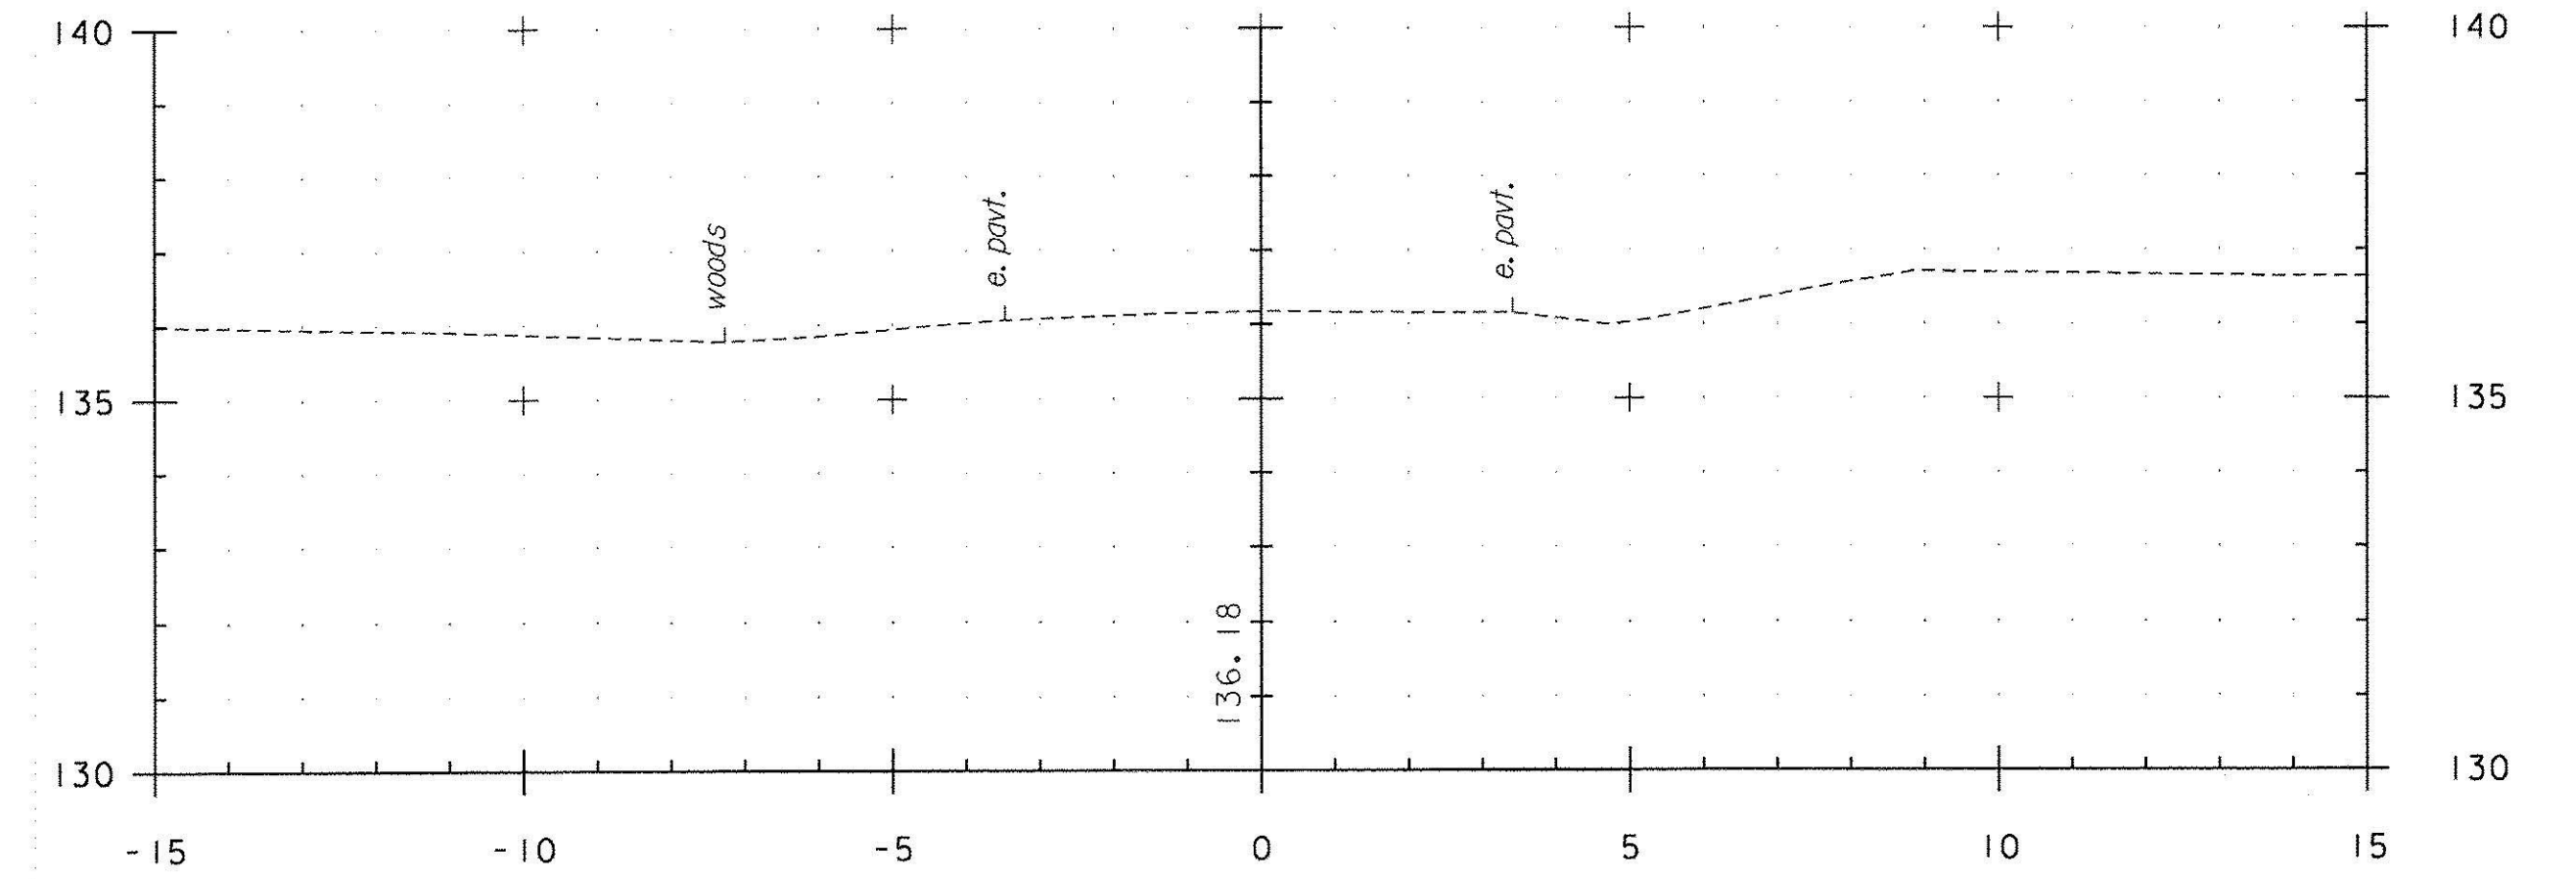


2+060.0

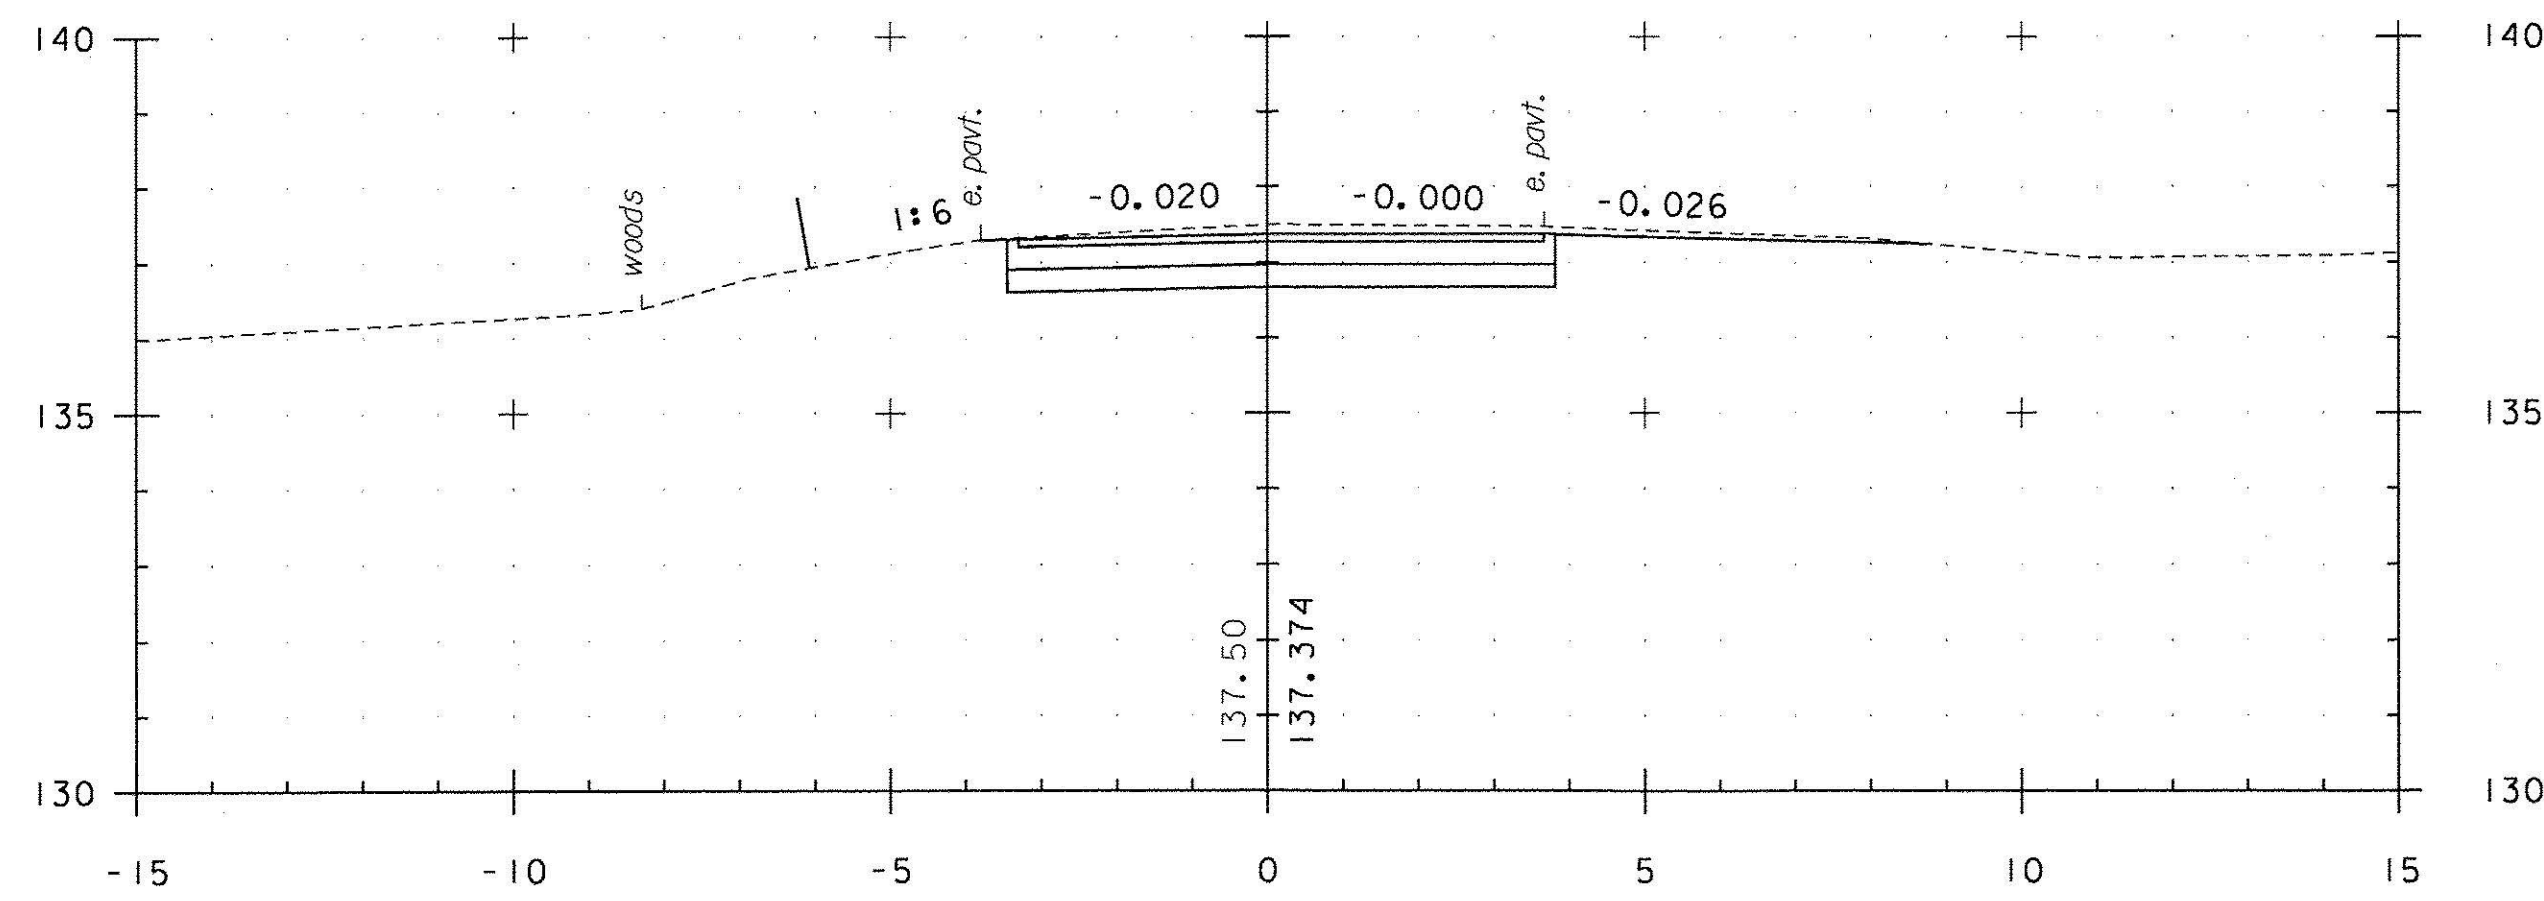


2+020.0

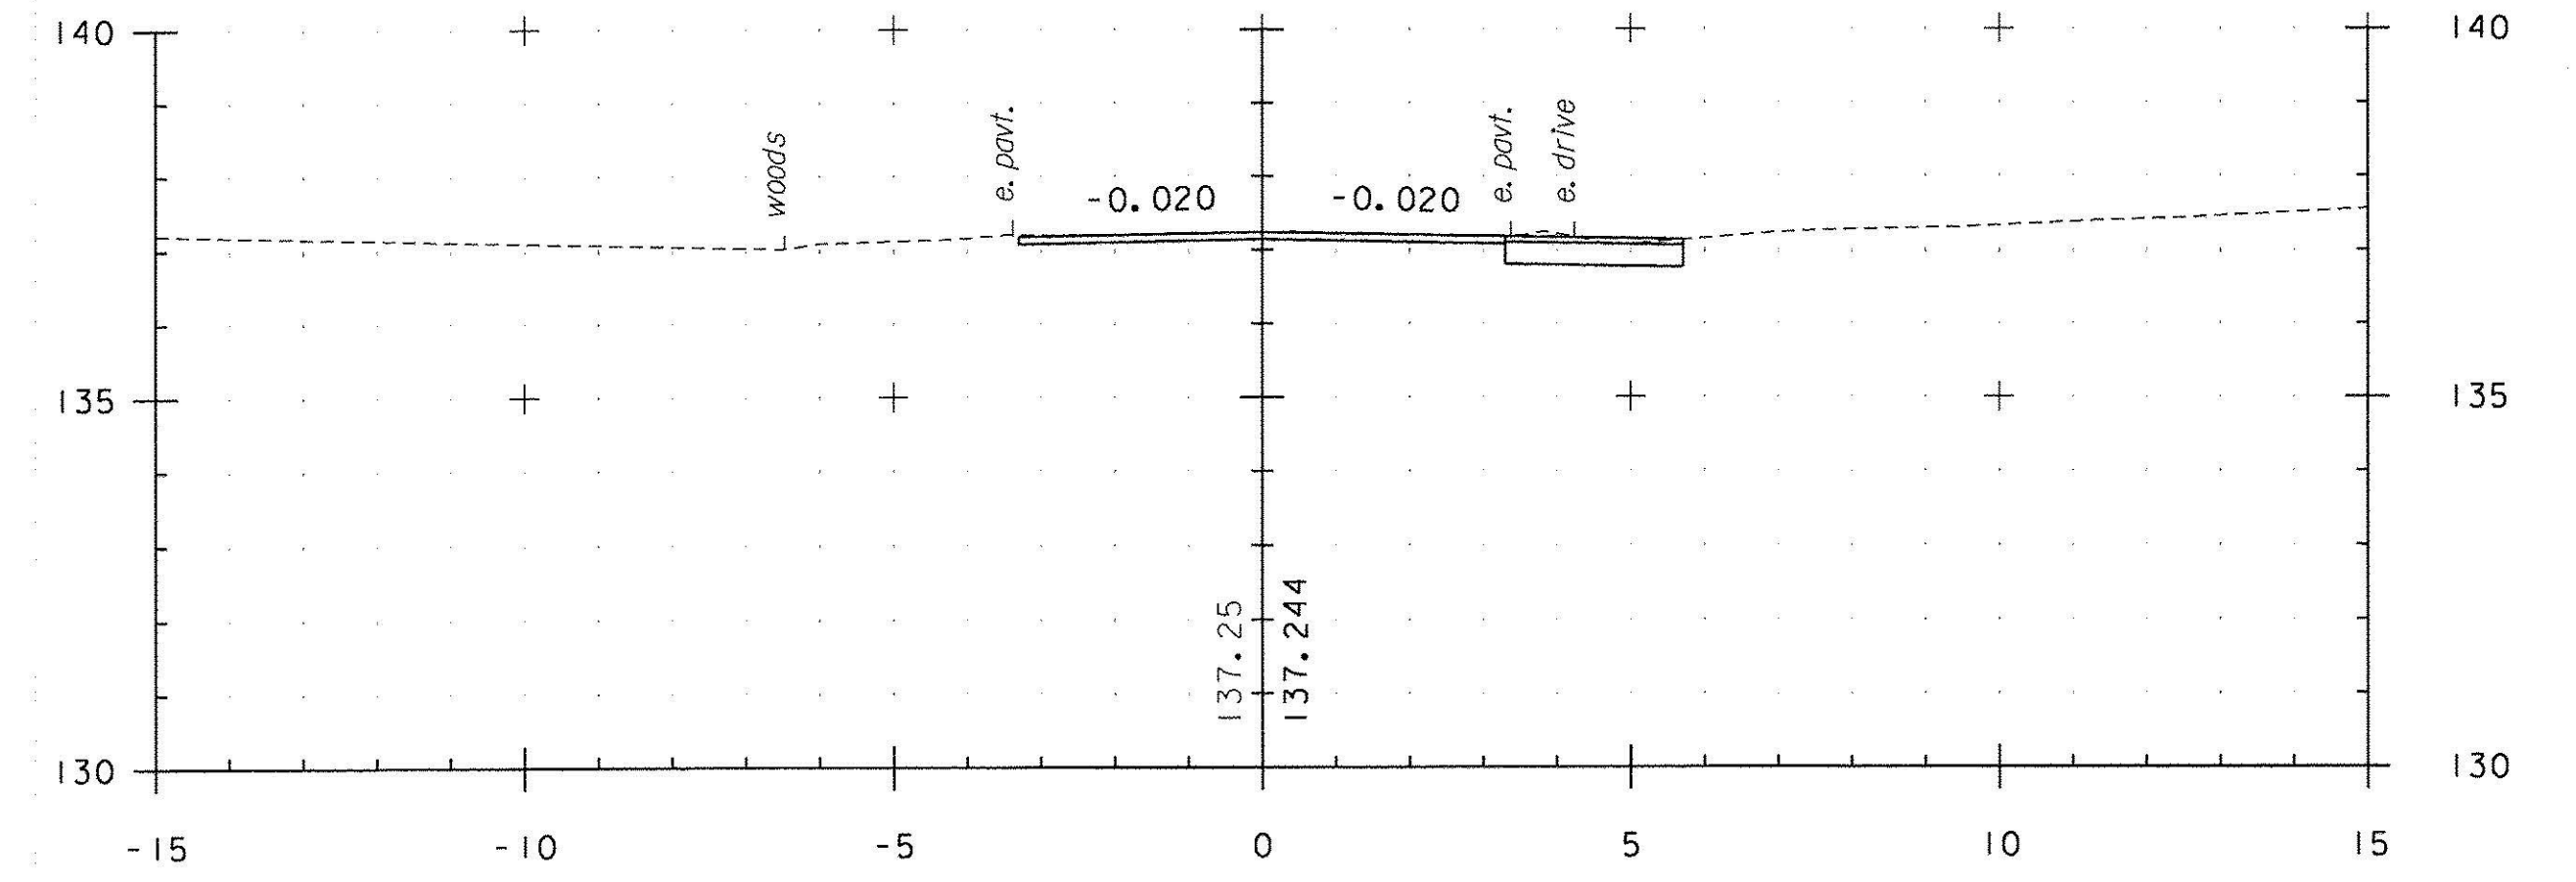

2+040.0

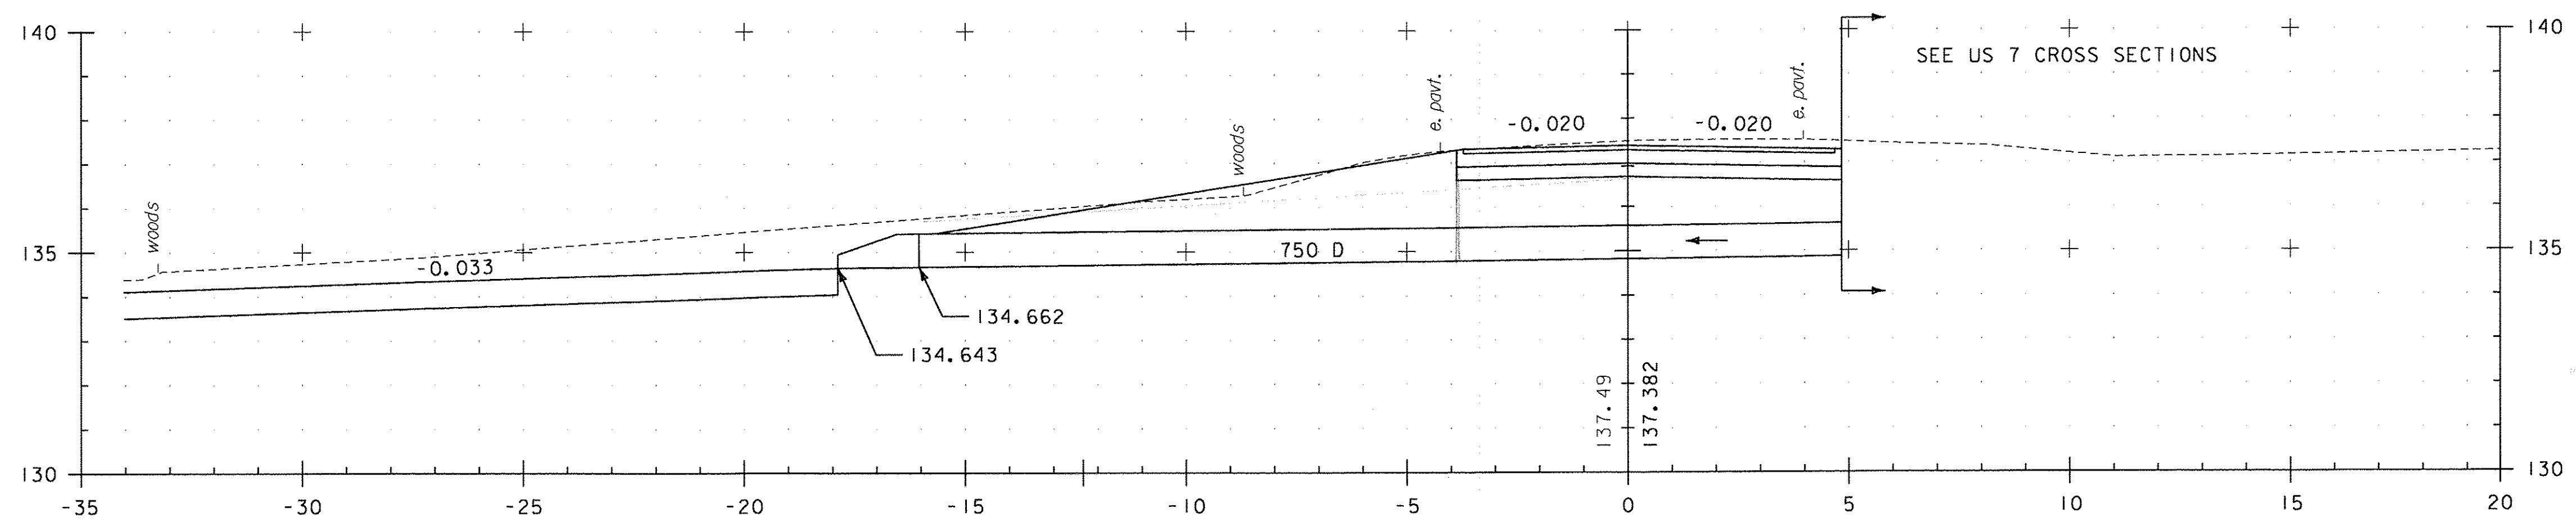

2+016.9 ASKEW 83°

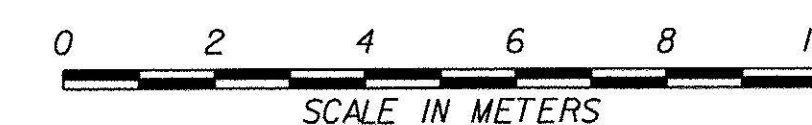

NICKERSON ROAD

PROJECT NAME: BRANDON
PROJECT NUMBER: NH 019-3(495)

FILE NAME: zb008s5-xs400.dgn	PLOT DATE: 9/3/2009
PROJECT LEADER: CRB	DRAWN BY: NLL
DESIGNED BY: PTS	CHECKED BY: DAM
CLD 02-0149	SHEET 546 OF 546