

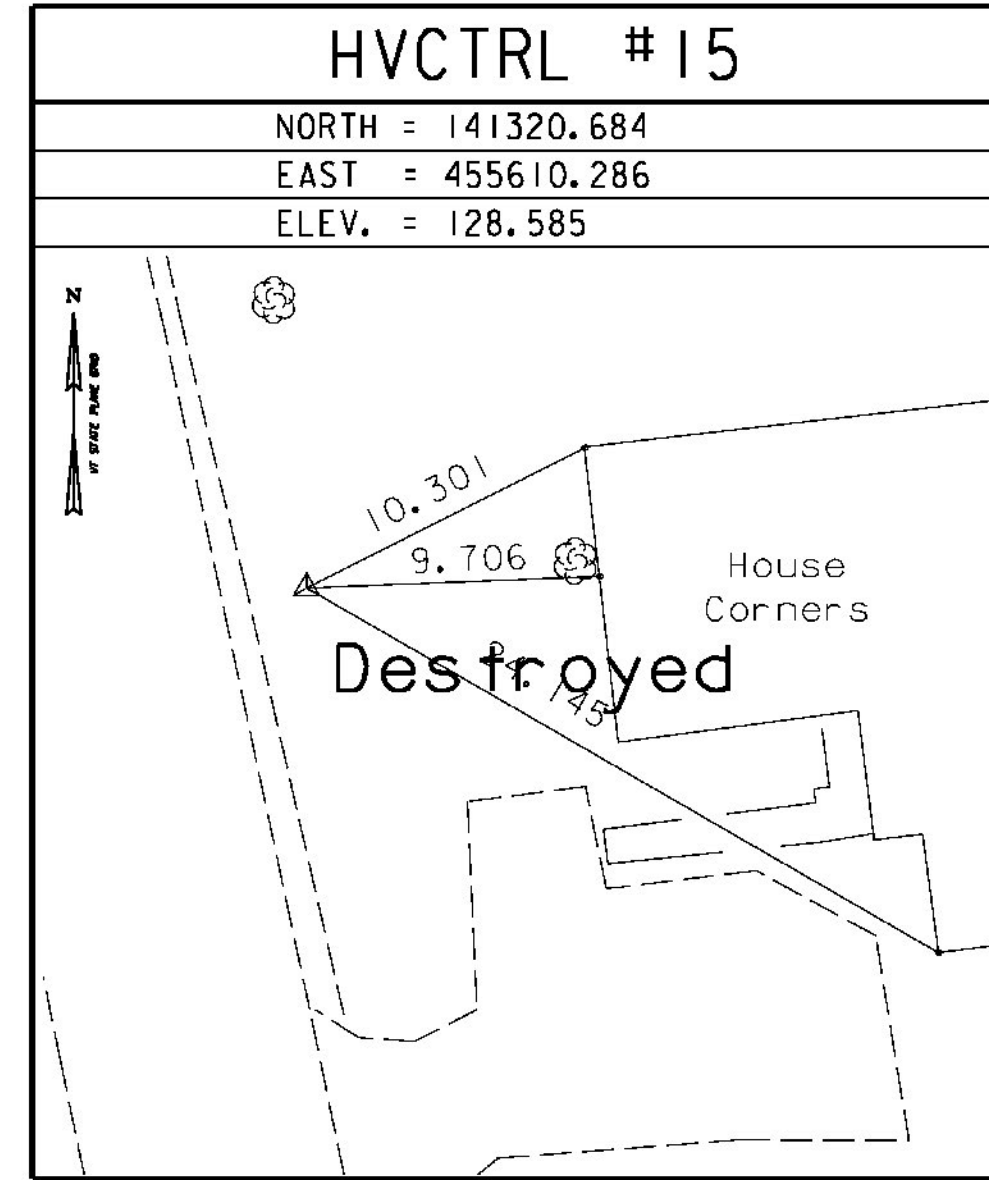
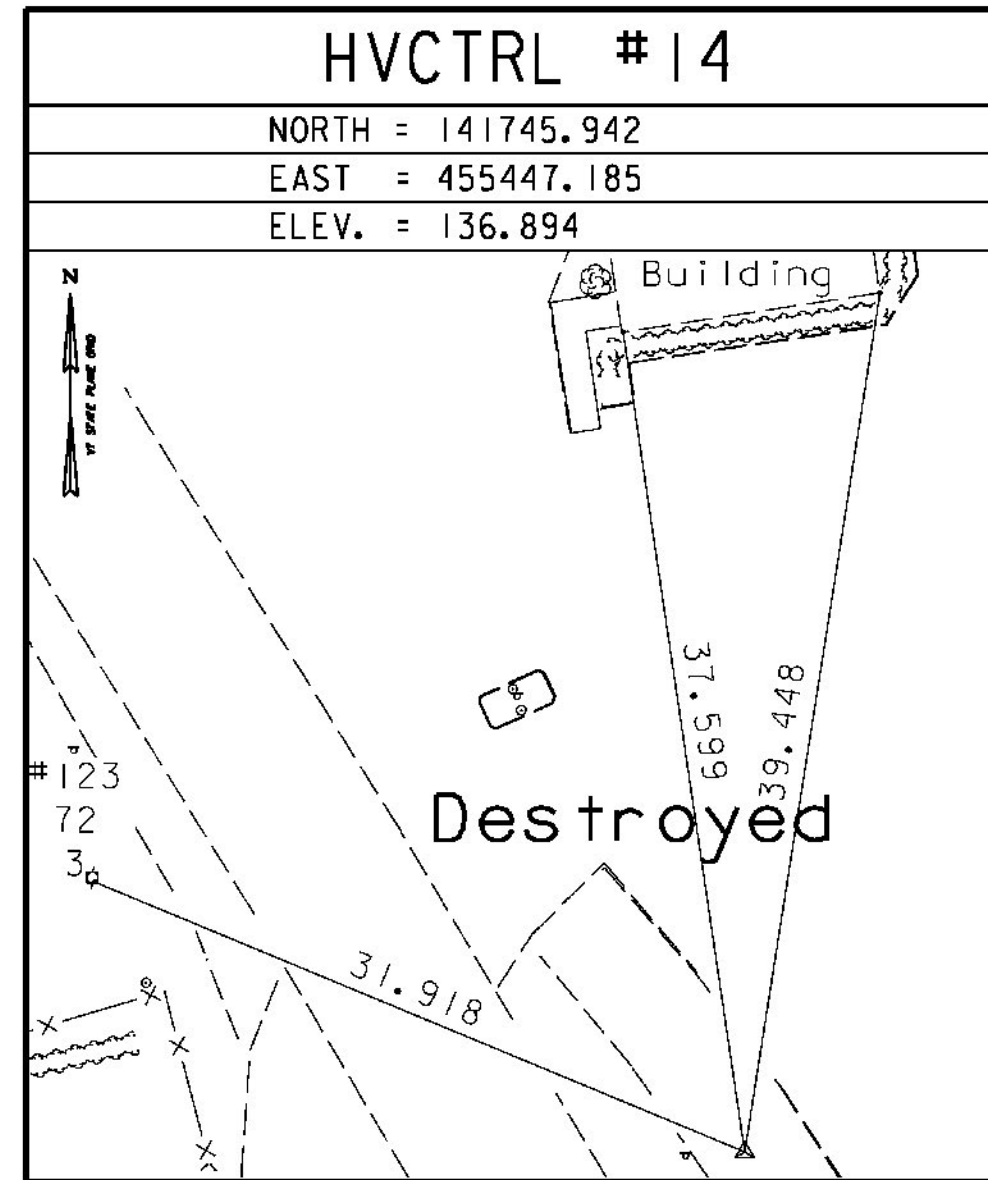







TRAVERSE TIES

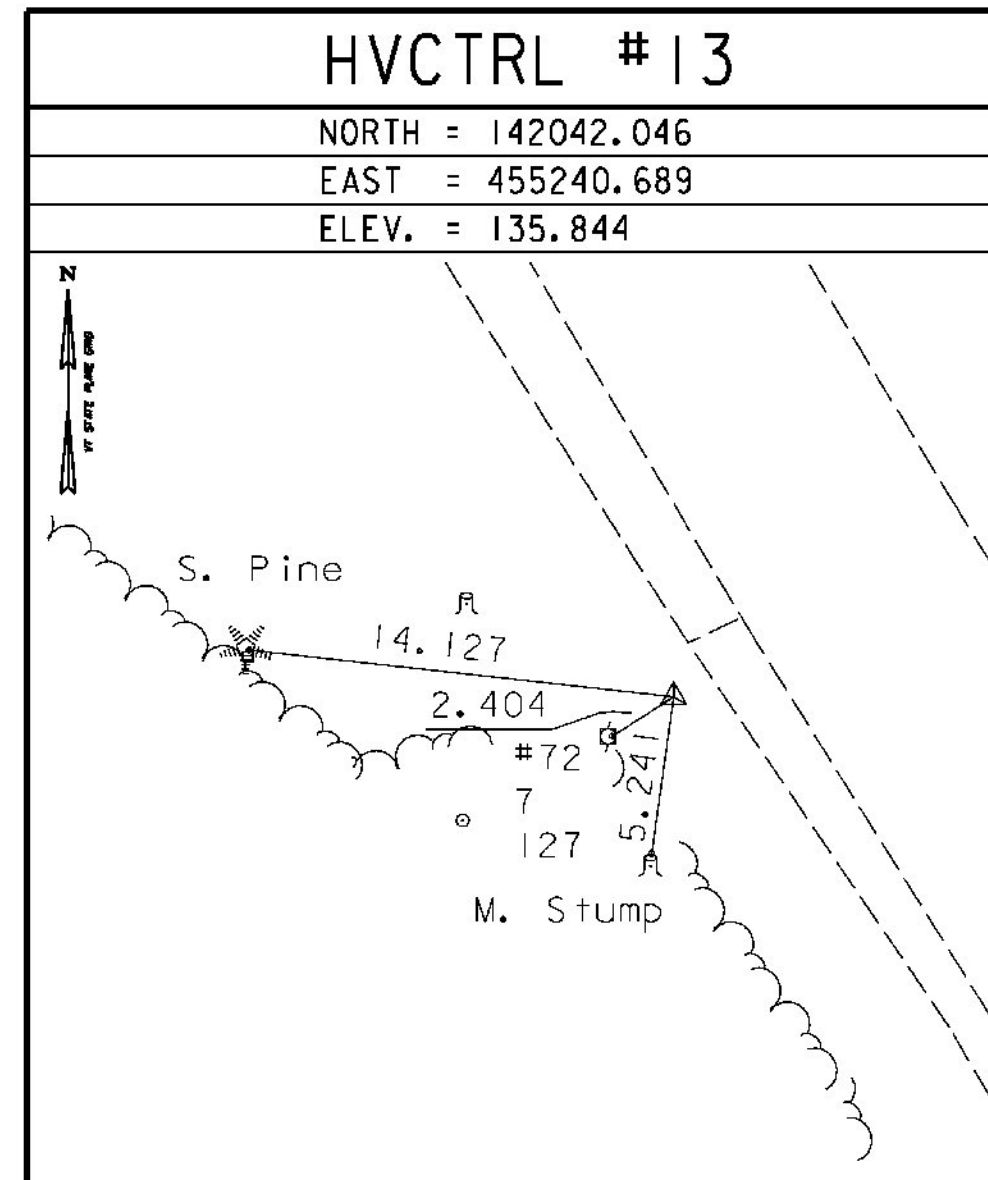

ALIGNMENT TIES





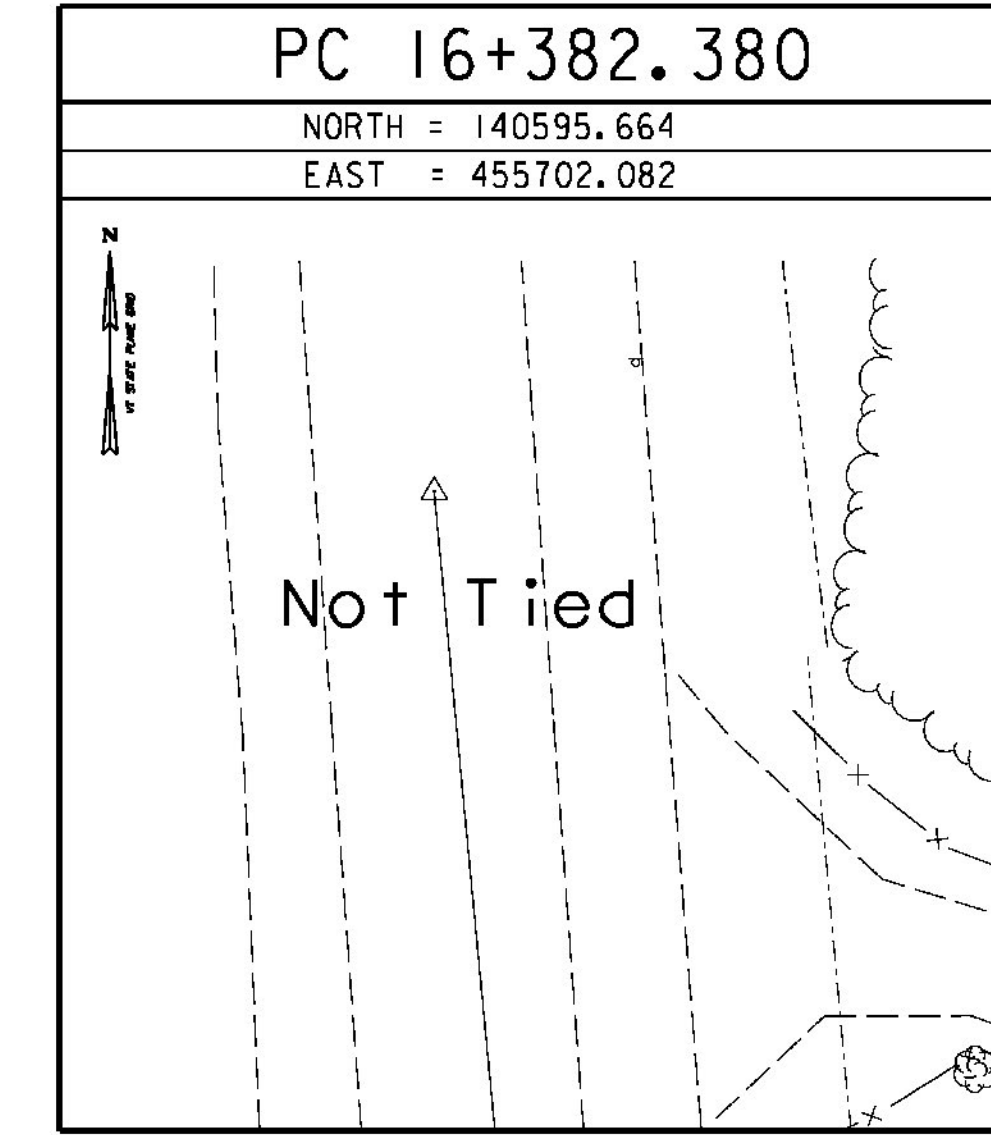


ALIGNMENT TIES

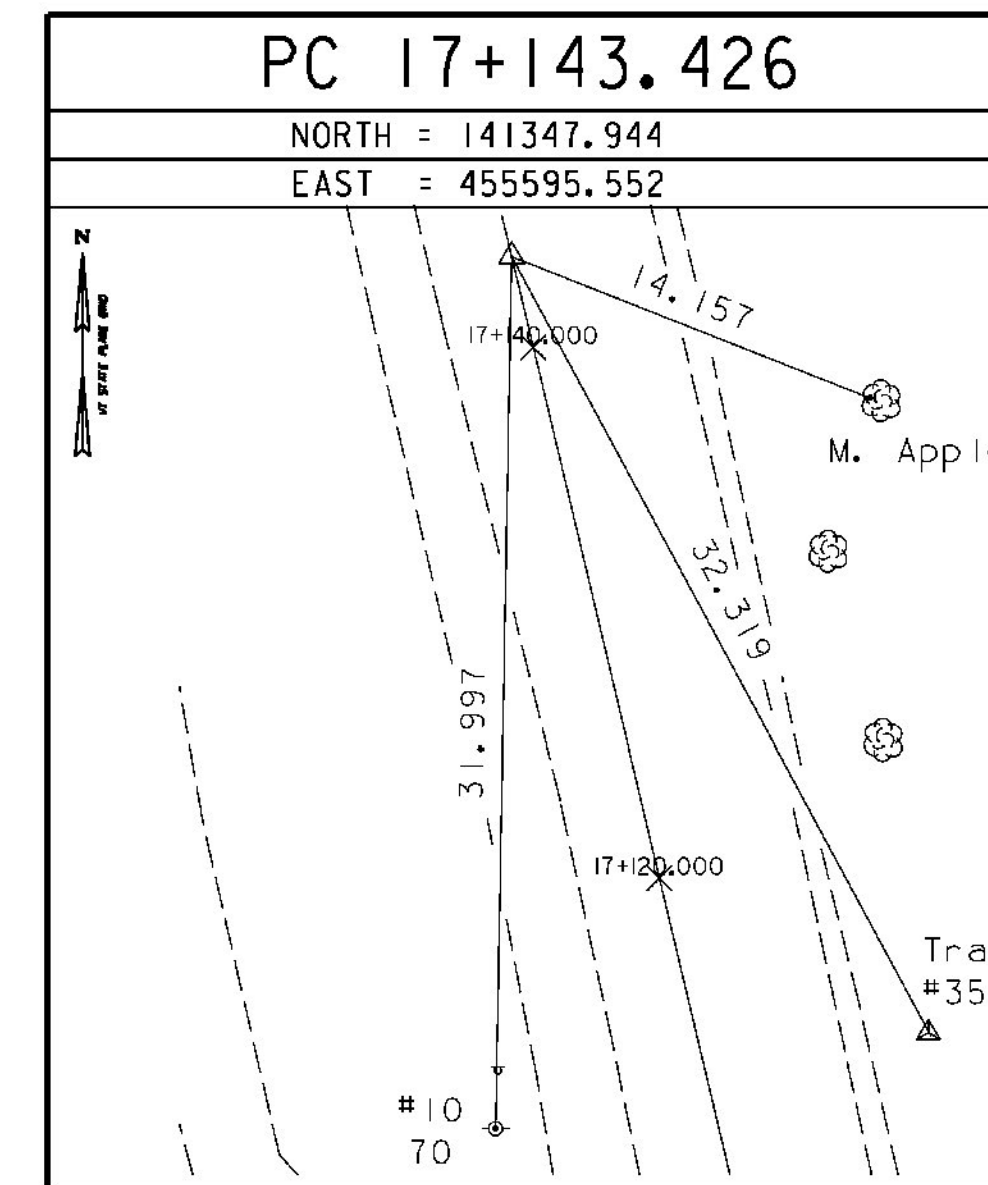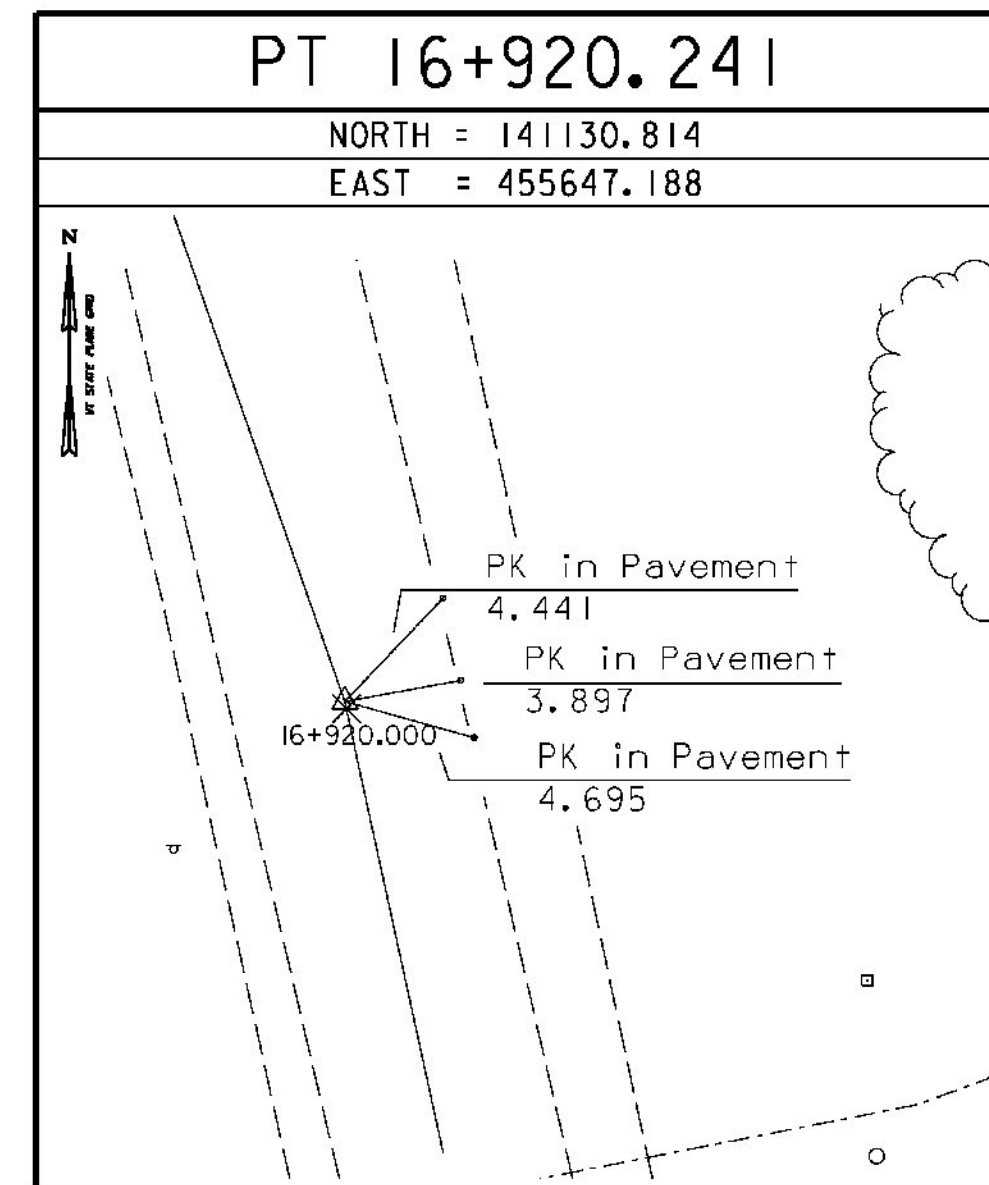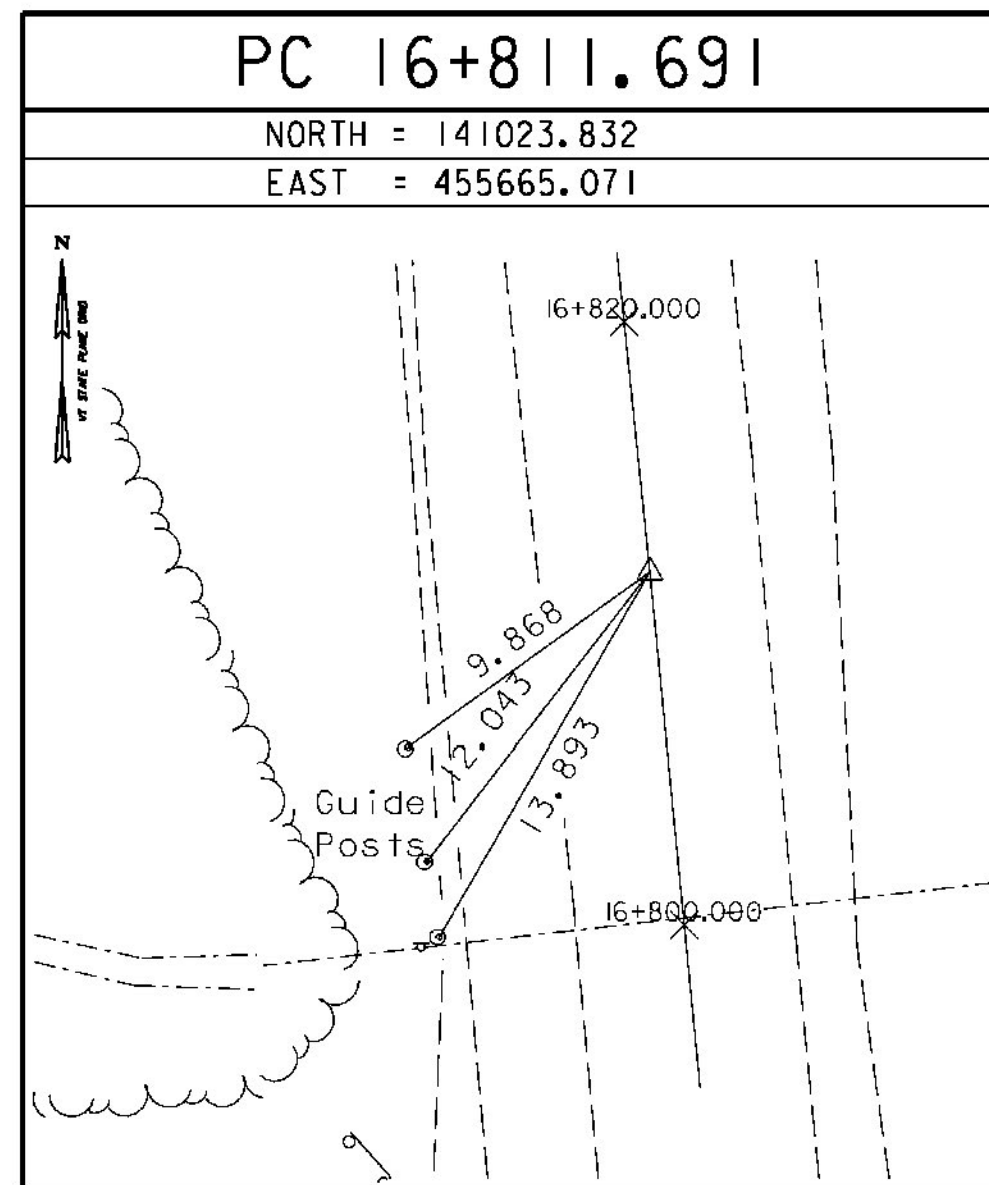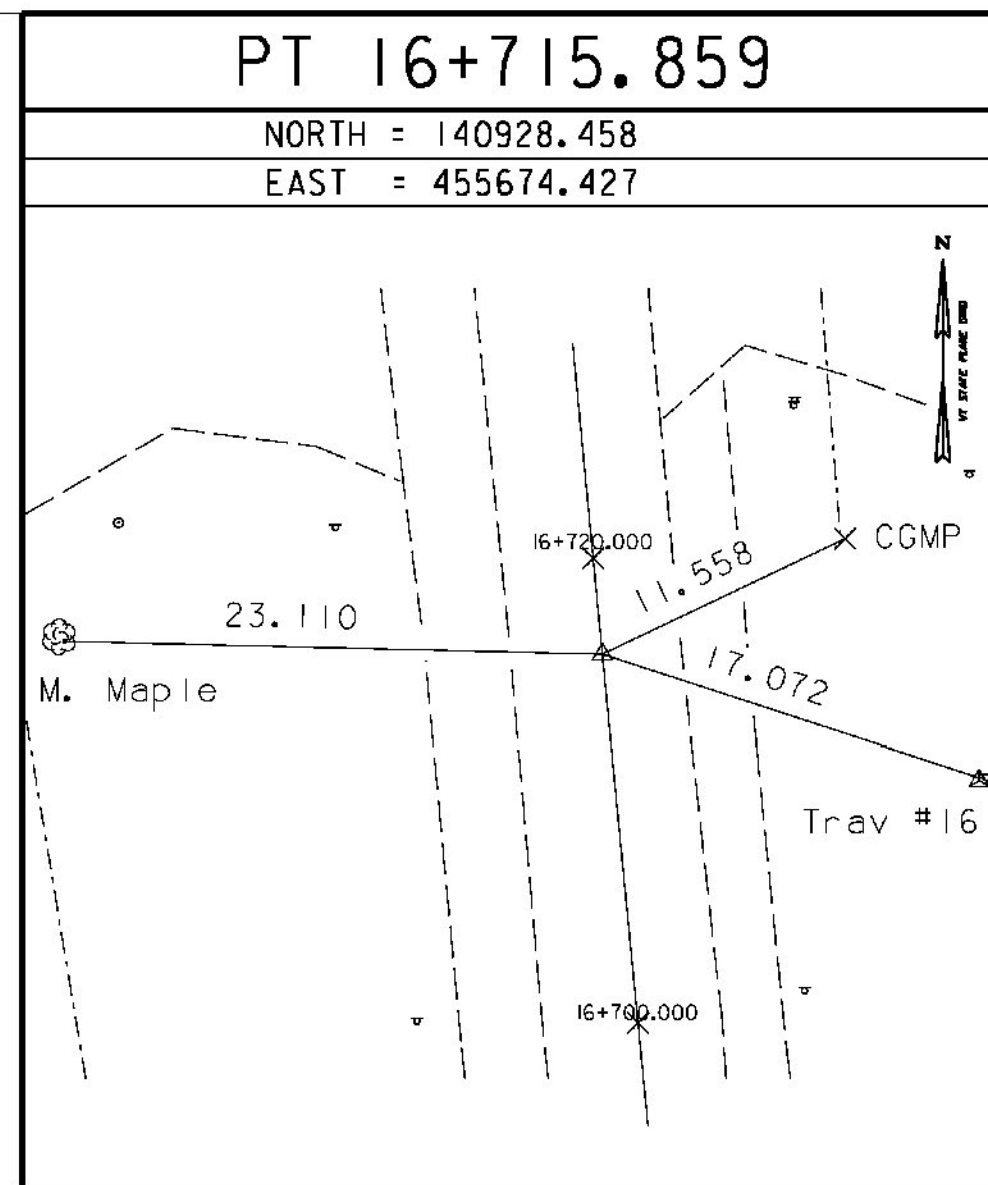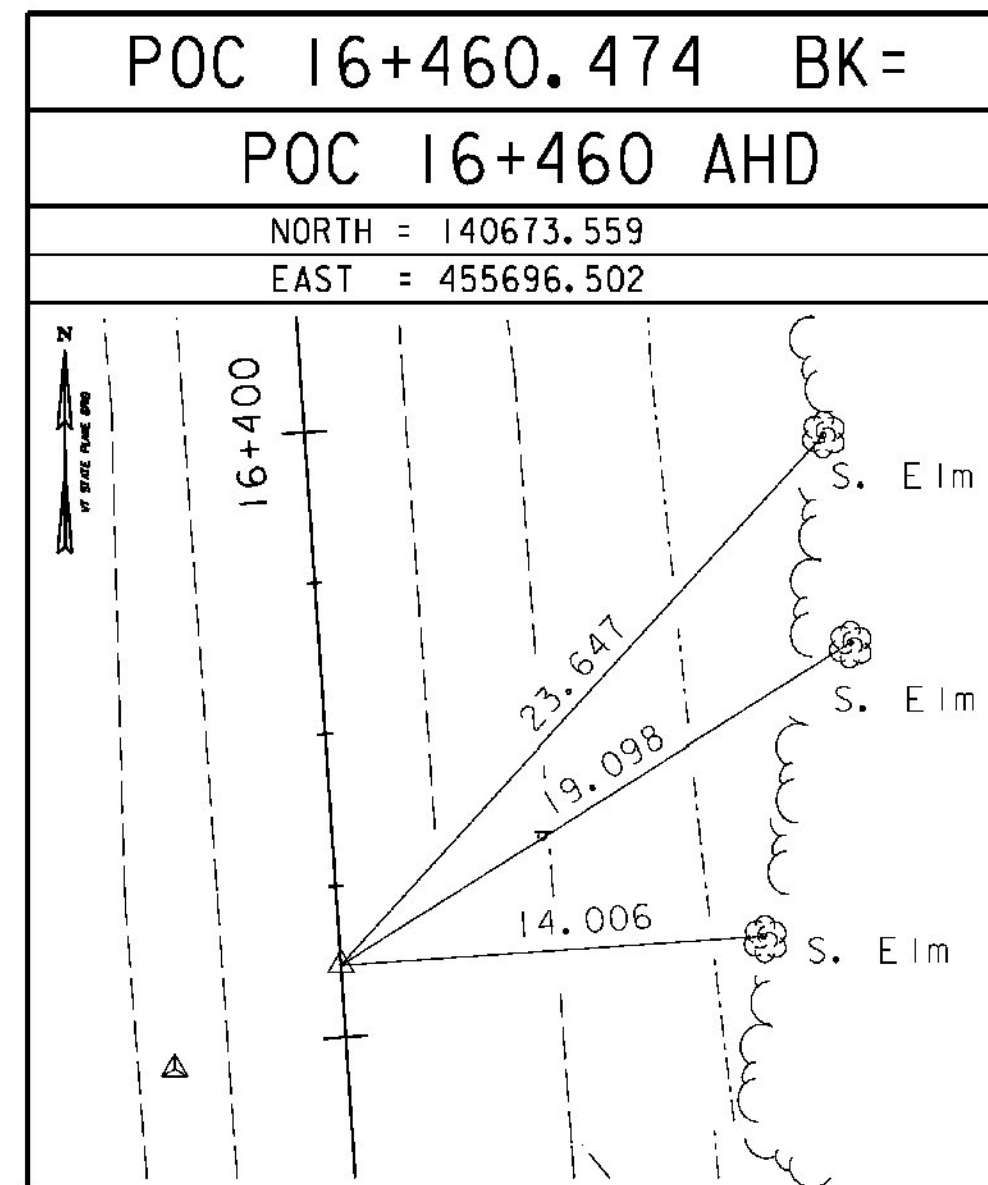

* Alignment Staked 08/05/03 by L/ Orvis P.C. & J. Hulett & B. Farley

ALIGNMENT TIES

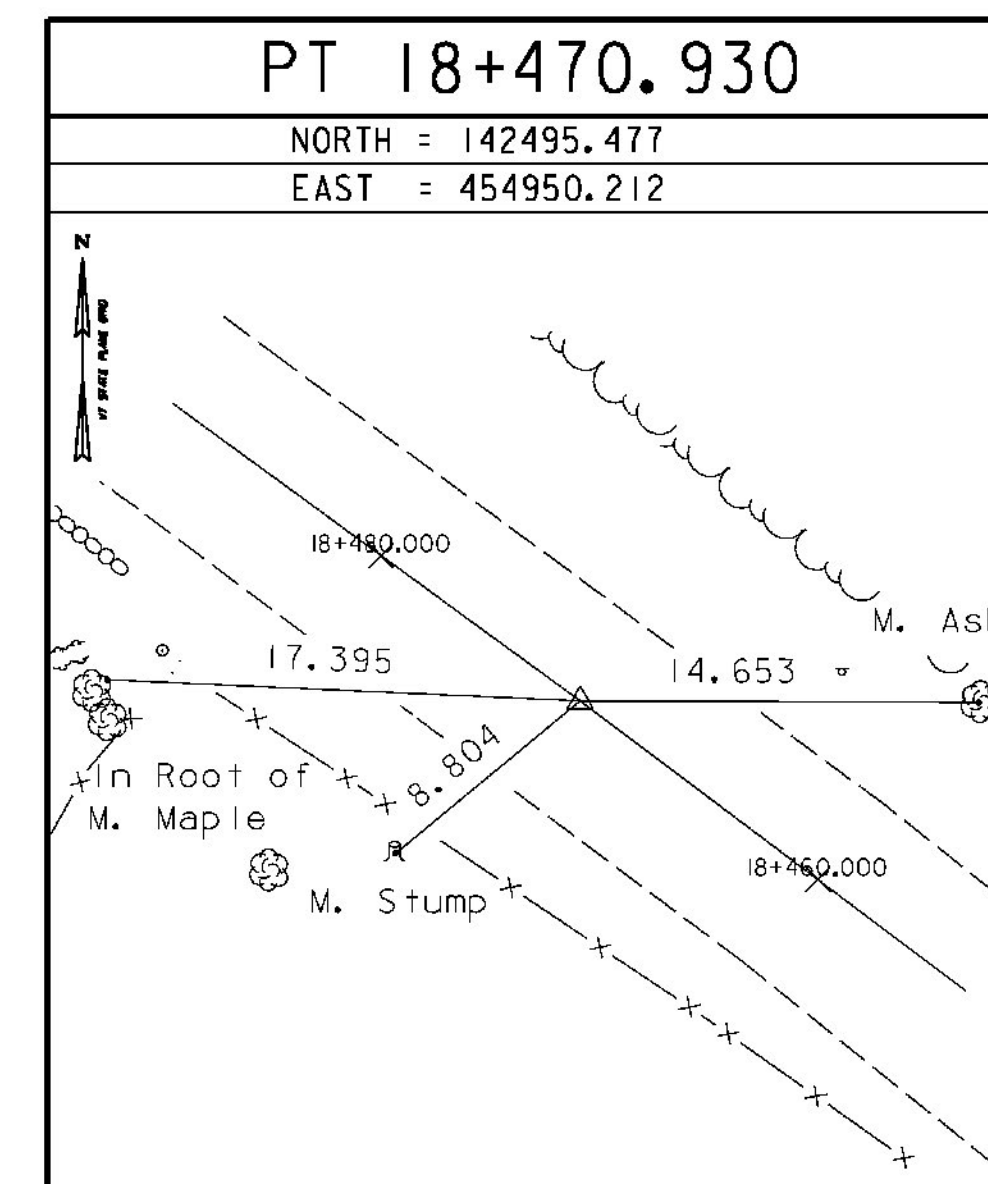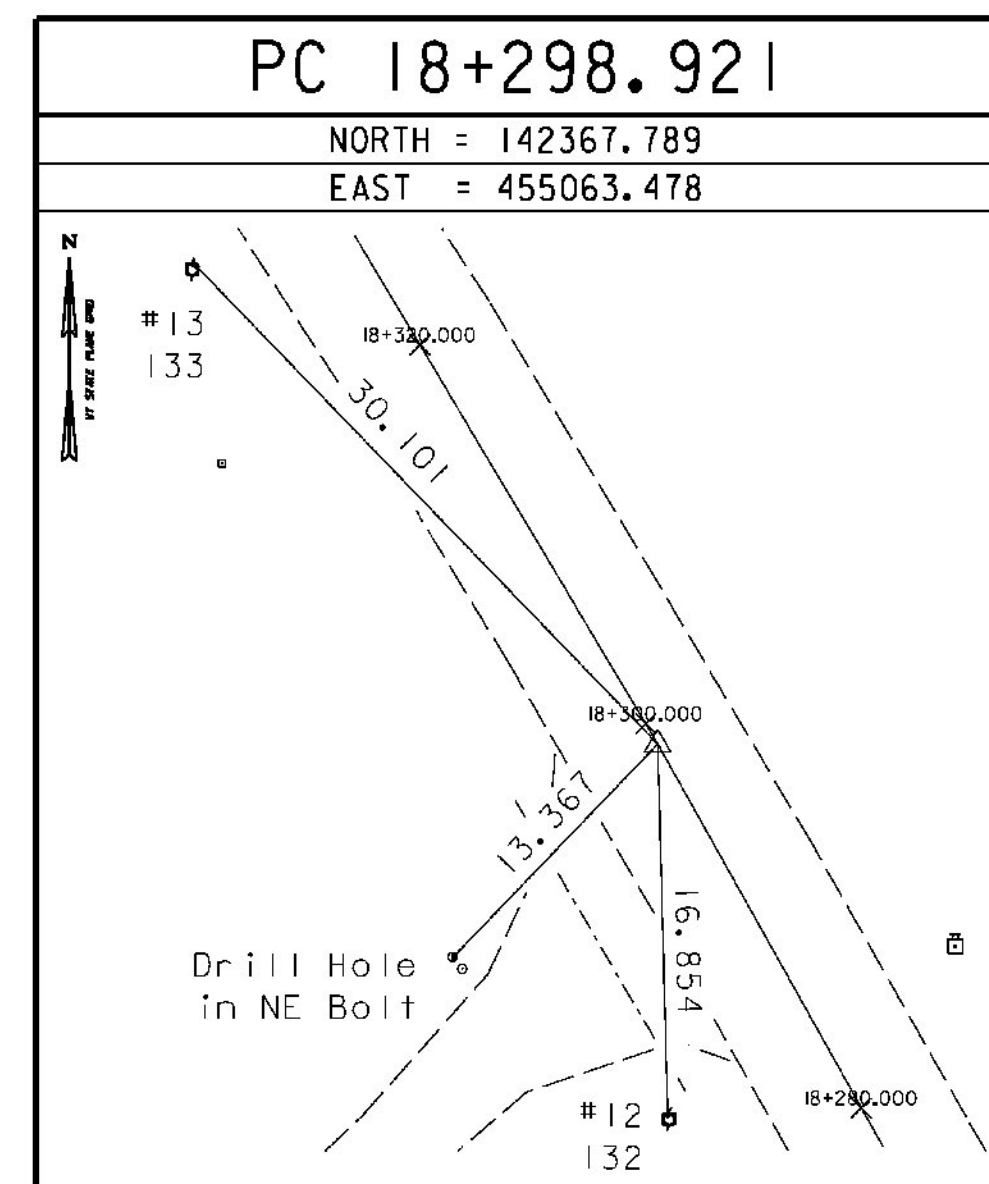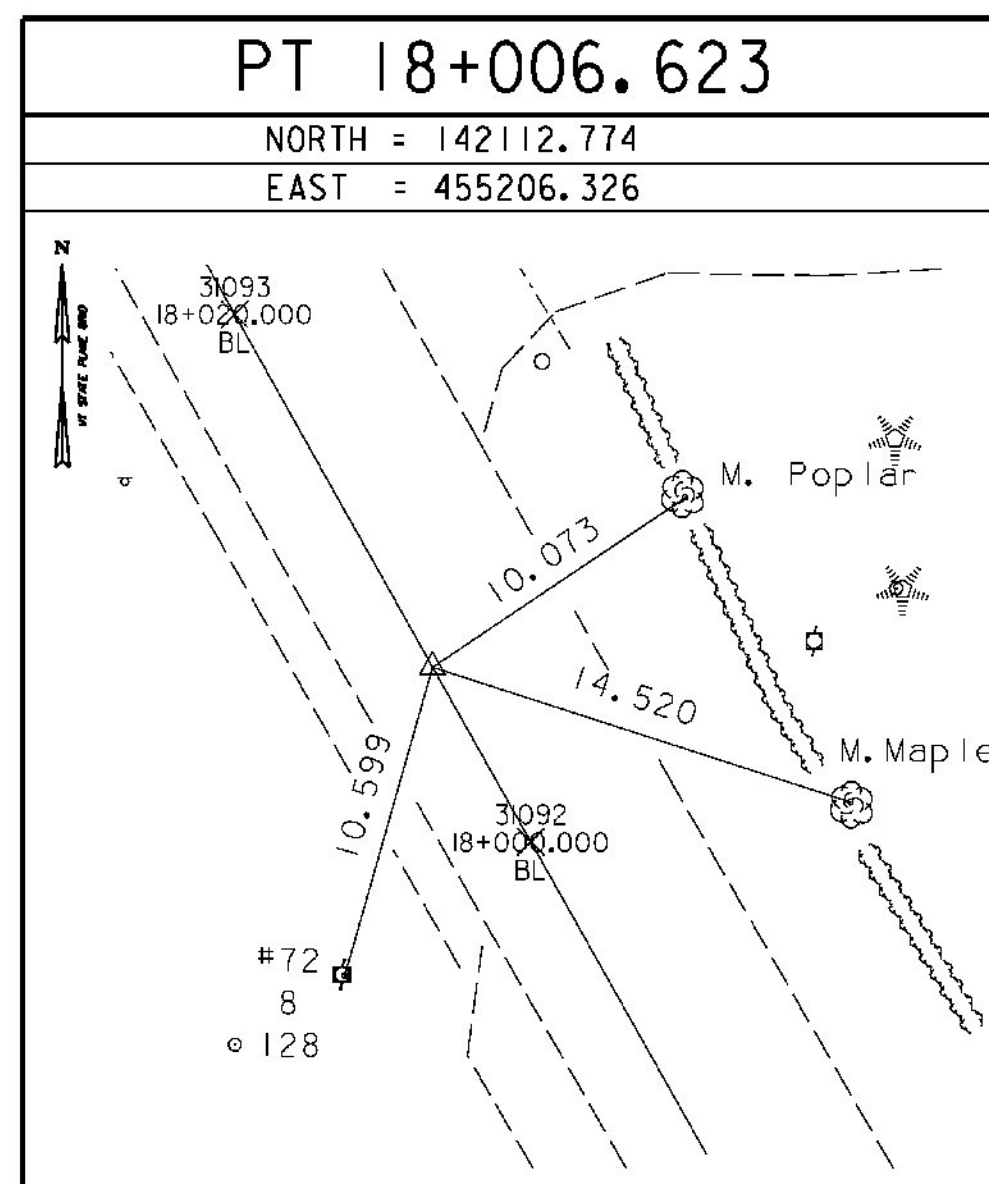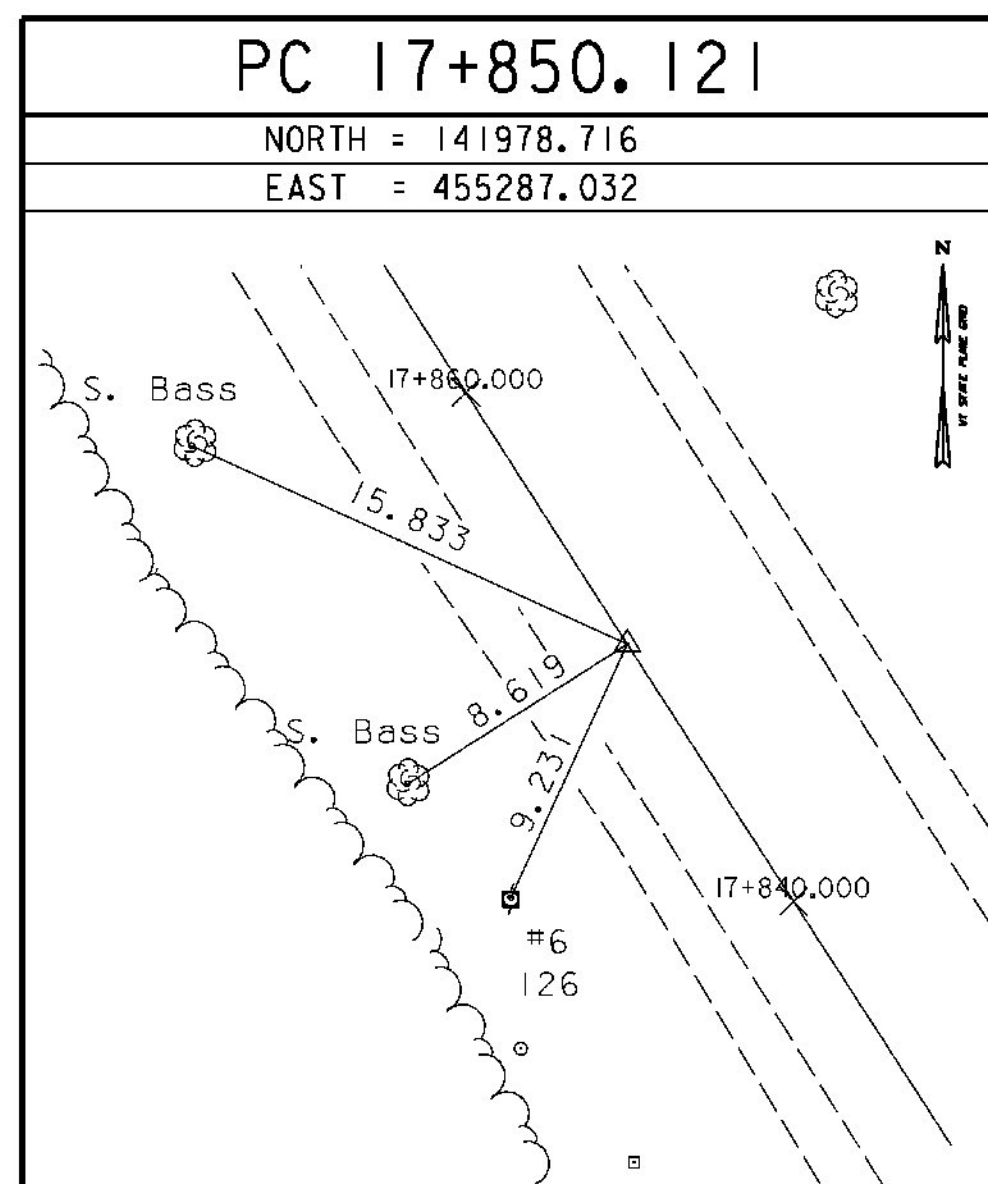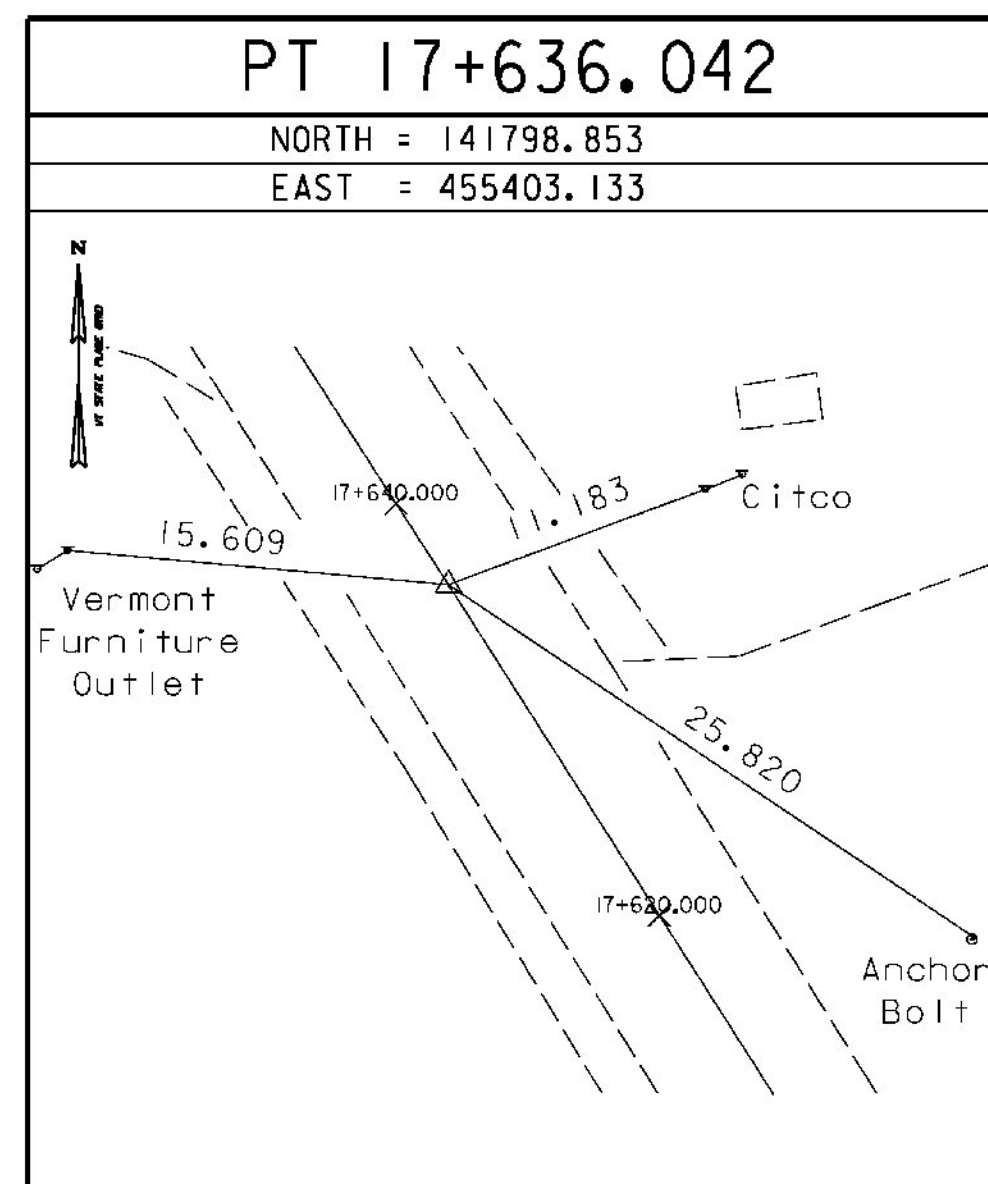

TIE SHEET

DATUM	
VERTICAL	NAVD 88
HORIZONTAL	NAD 83/92
ADJUSTMENT	Least Squares

PROJECT NAME:	BRANDON
PROJECT NUMBER:	NH 019-3(495)
FILE NAME:	x85b008s5-t102.dgn
PROJECT LEADER:	VA0T
DESIGNED BY:	VTRANS
CLD 02-0149	
PLOT DATE:	9/3/2009
DRAWN BY:	R. Bullock
CHECKED BY:	VTRANS
SHEET	66 OF 546

NOTE: ALL TIE DISTANCES IN METERS