

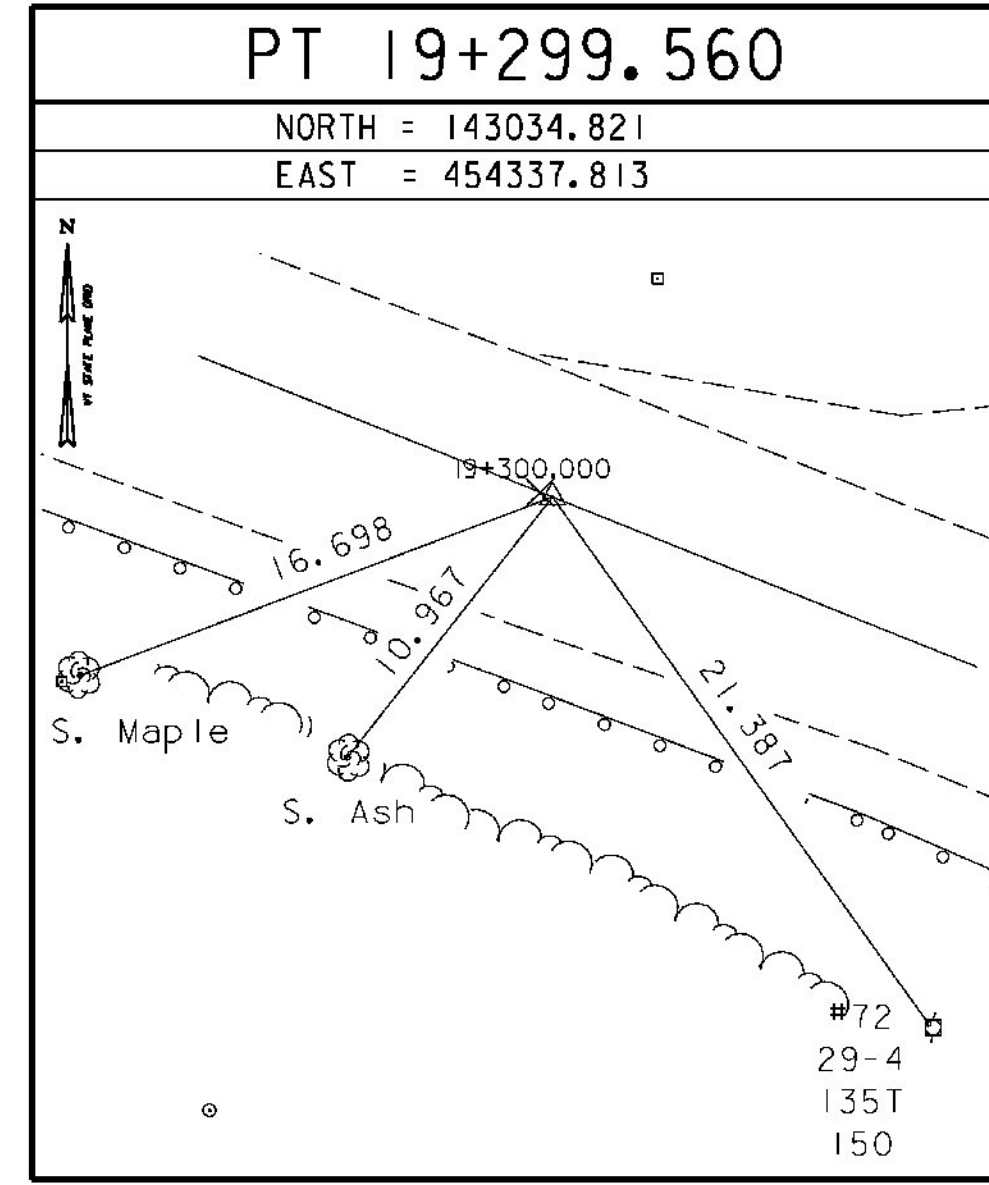
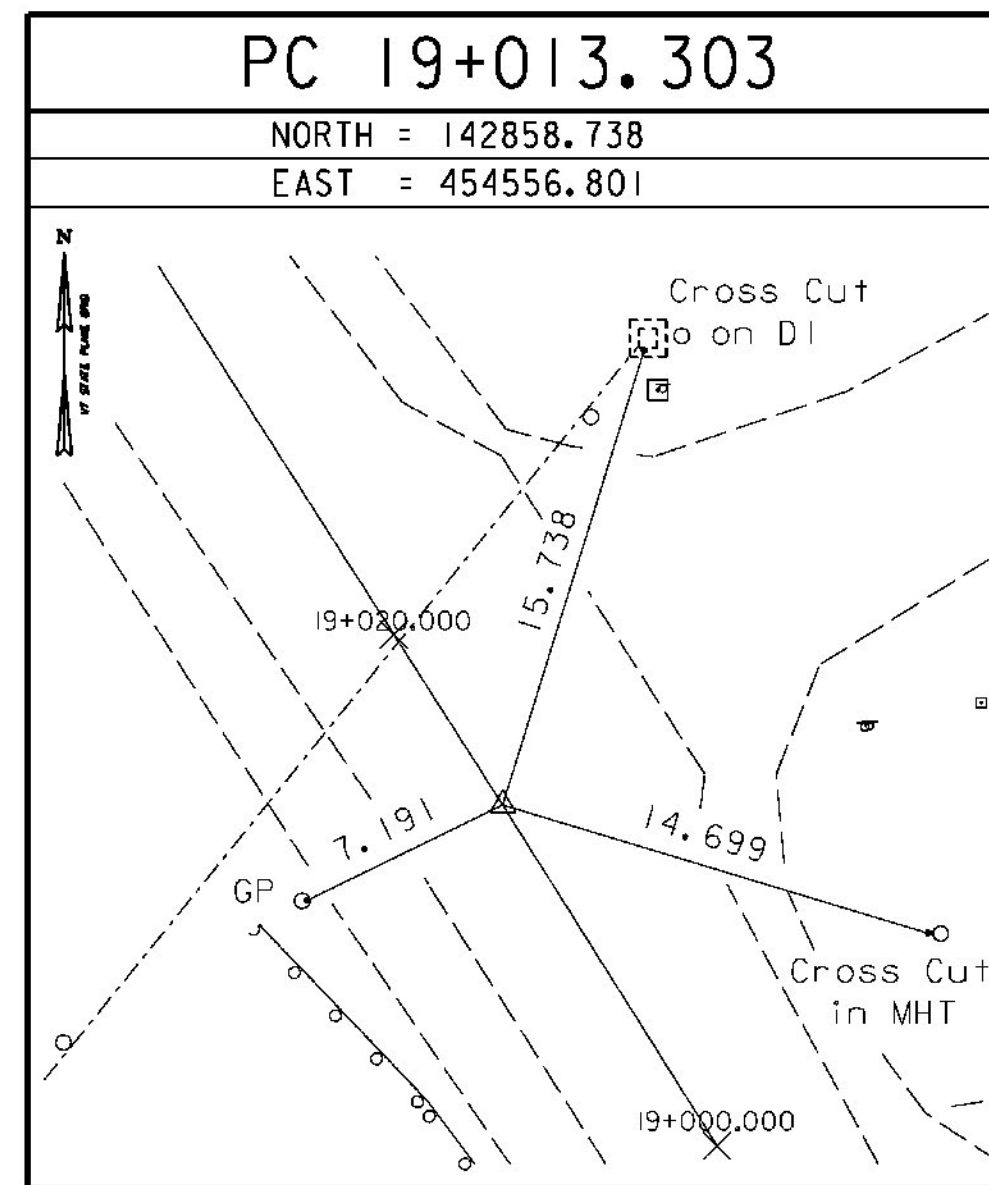
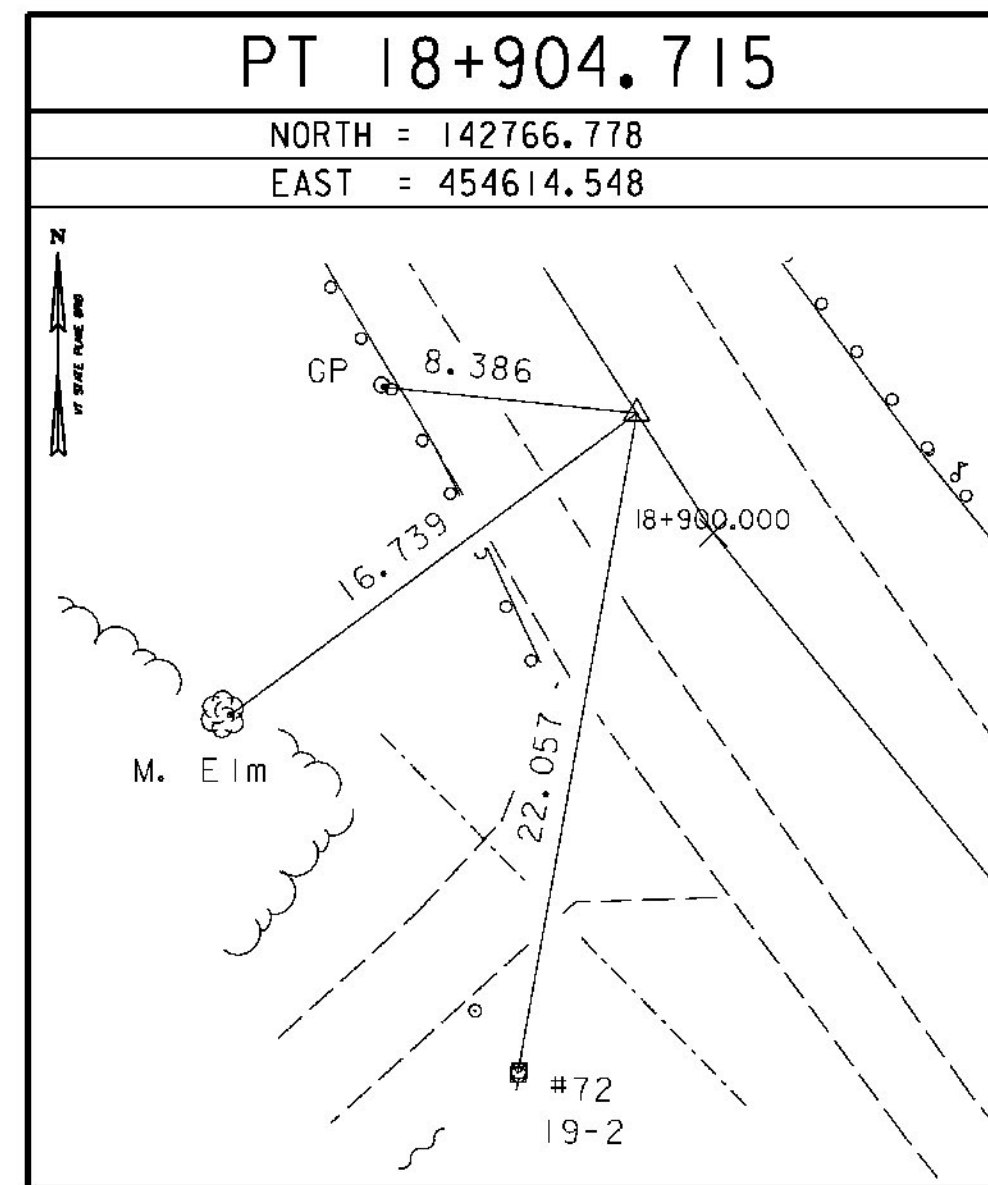
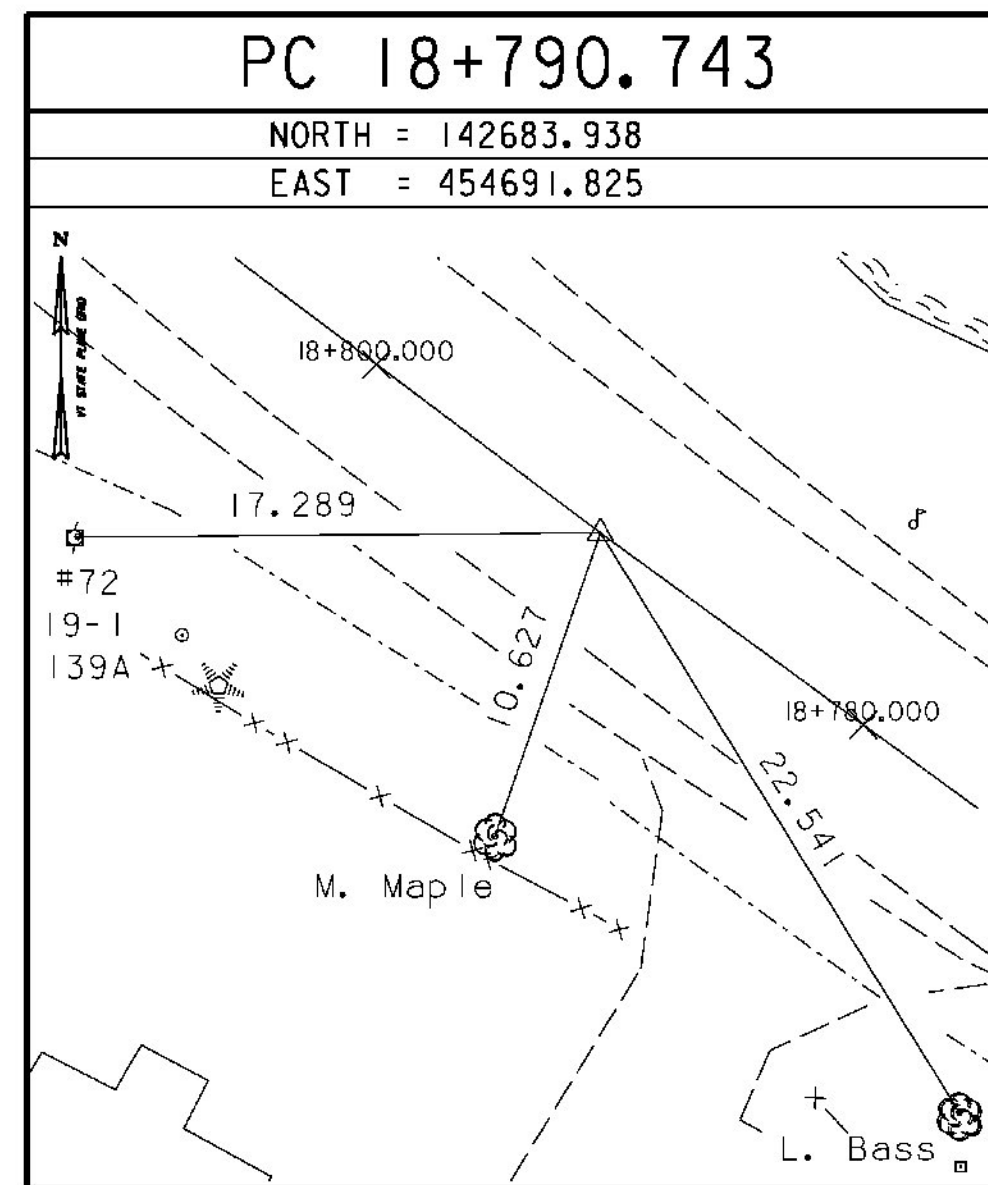
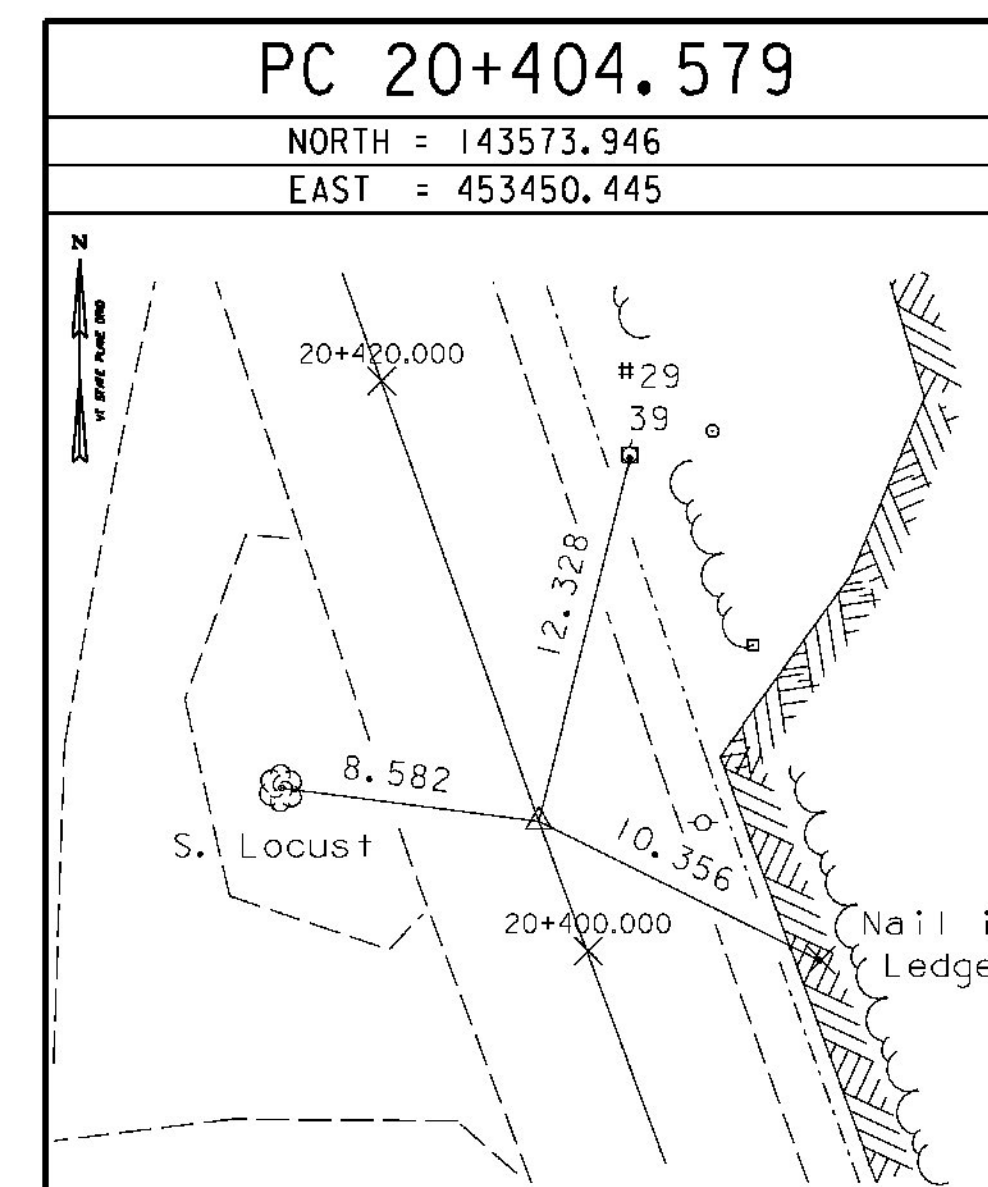
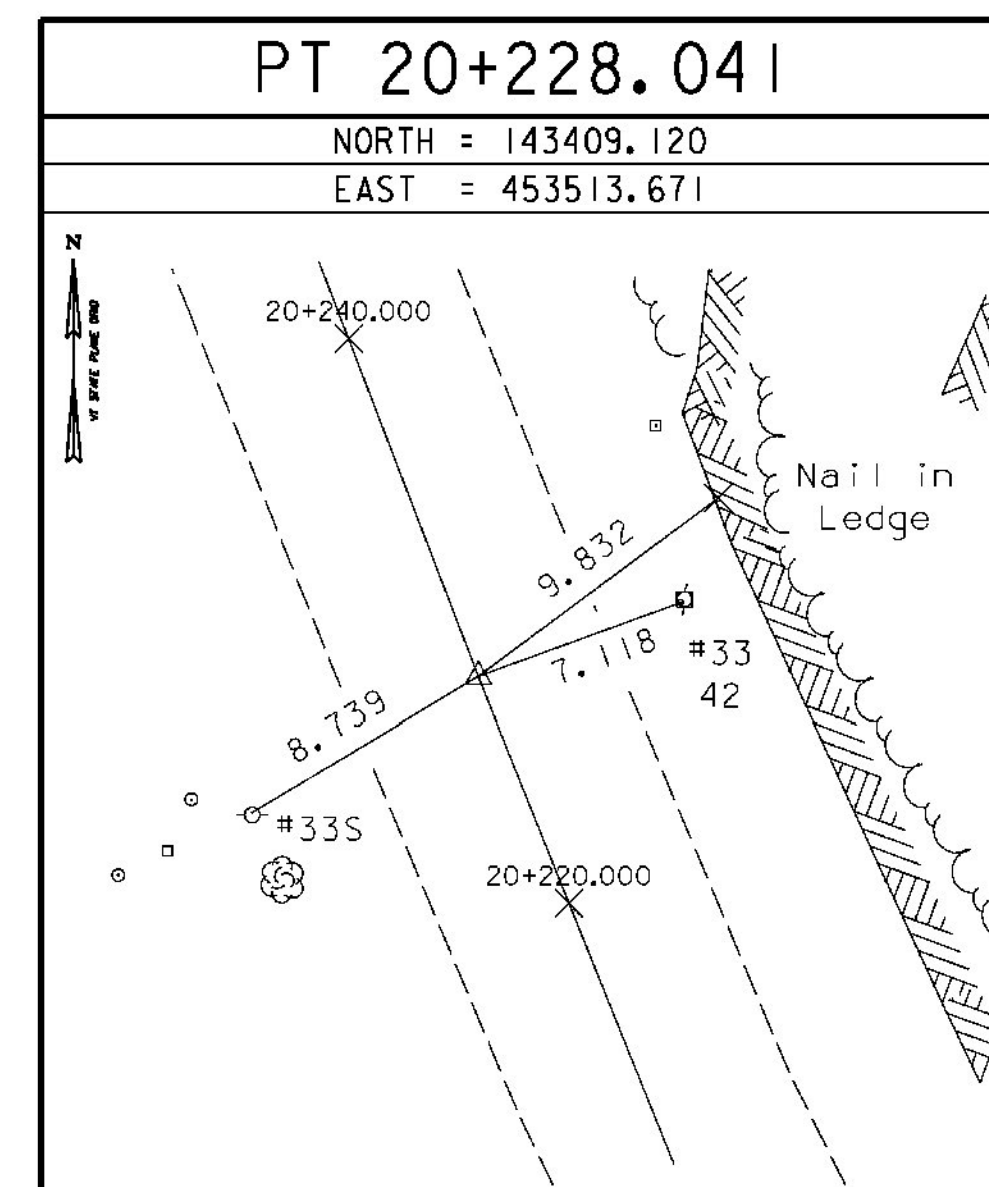
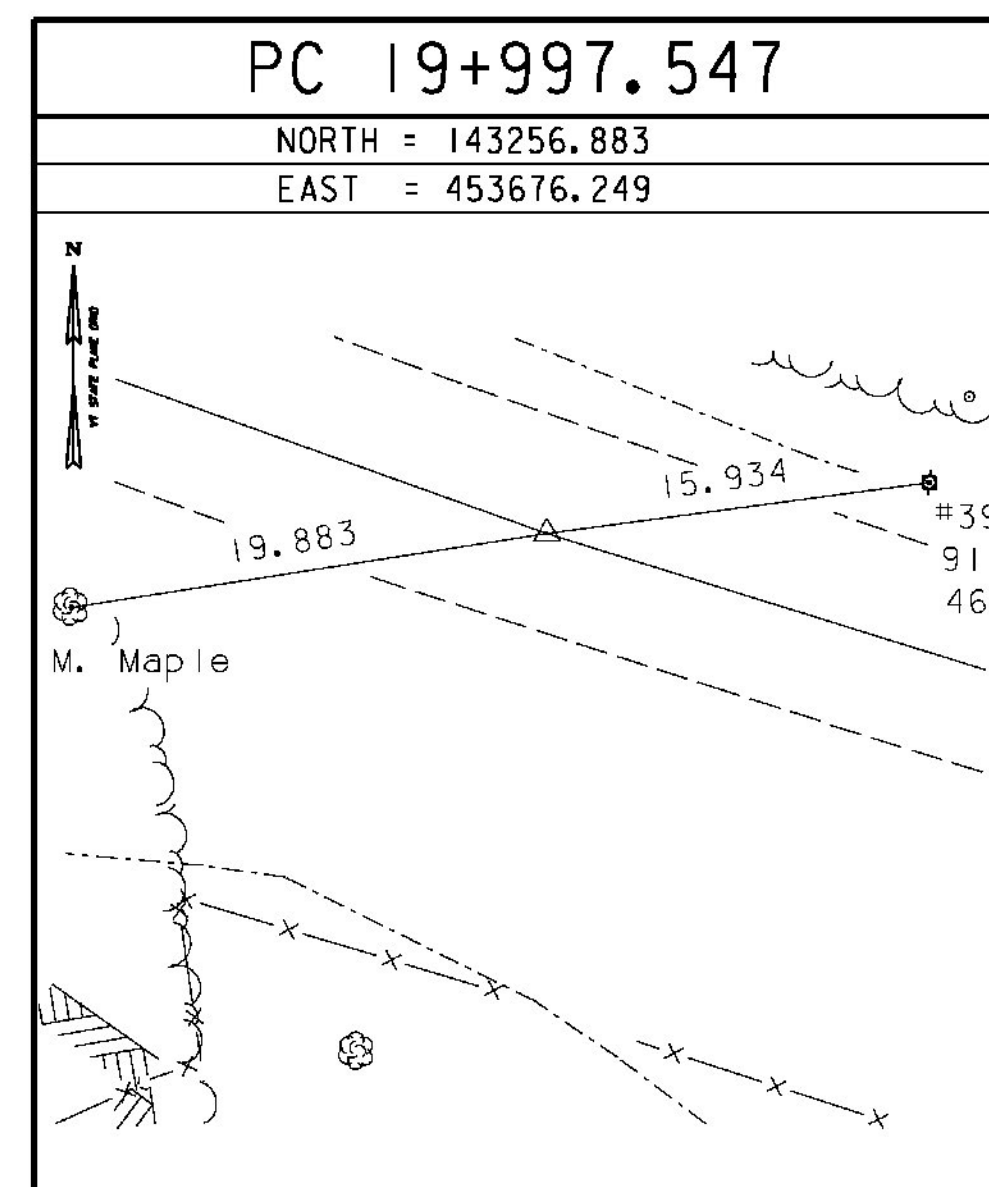







ALIGNMENT TIES

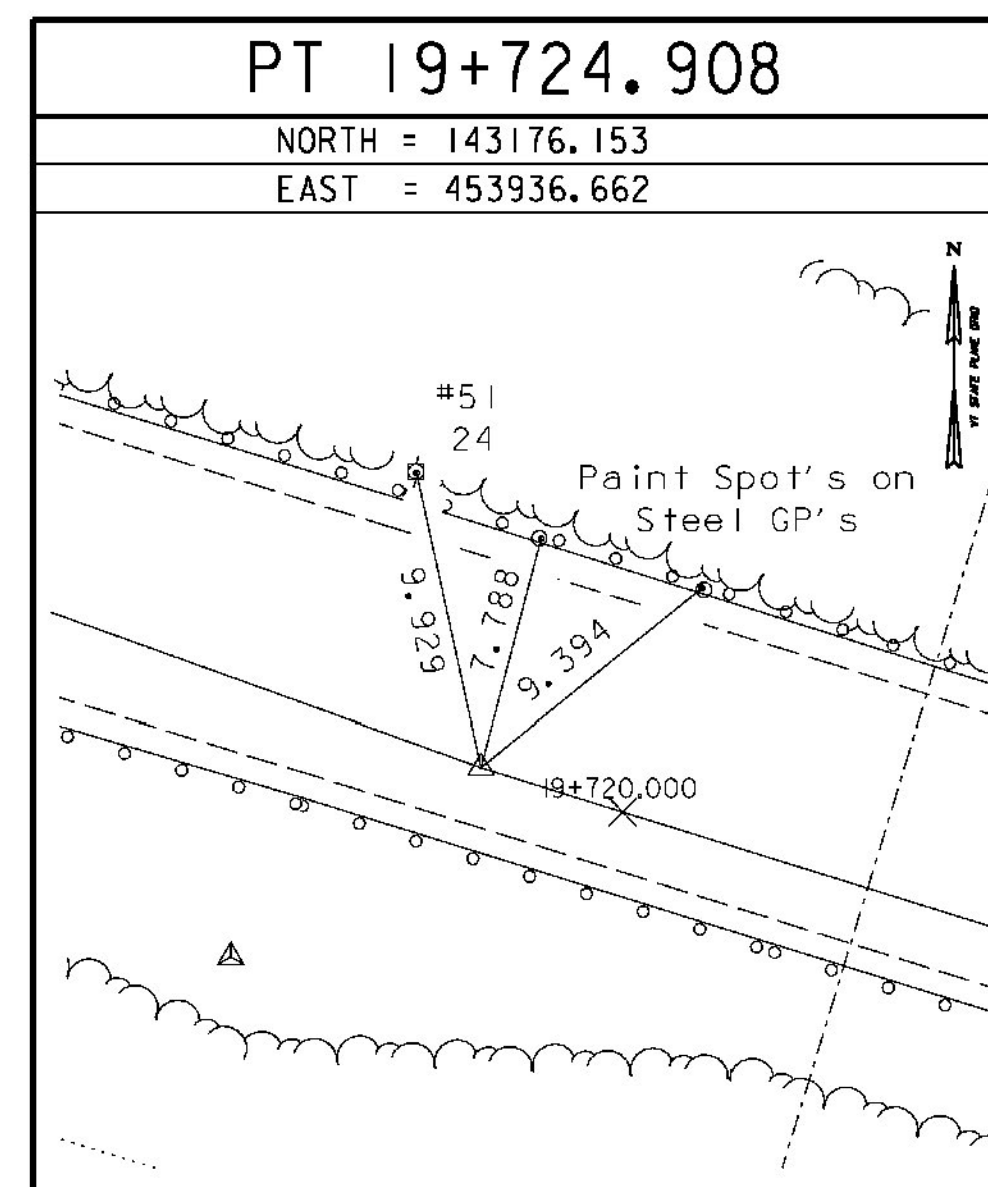

ALIGNMENT TIES

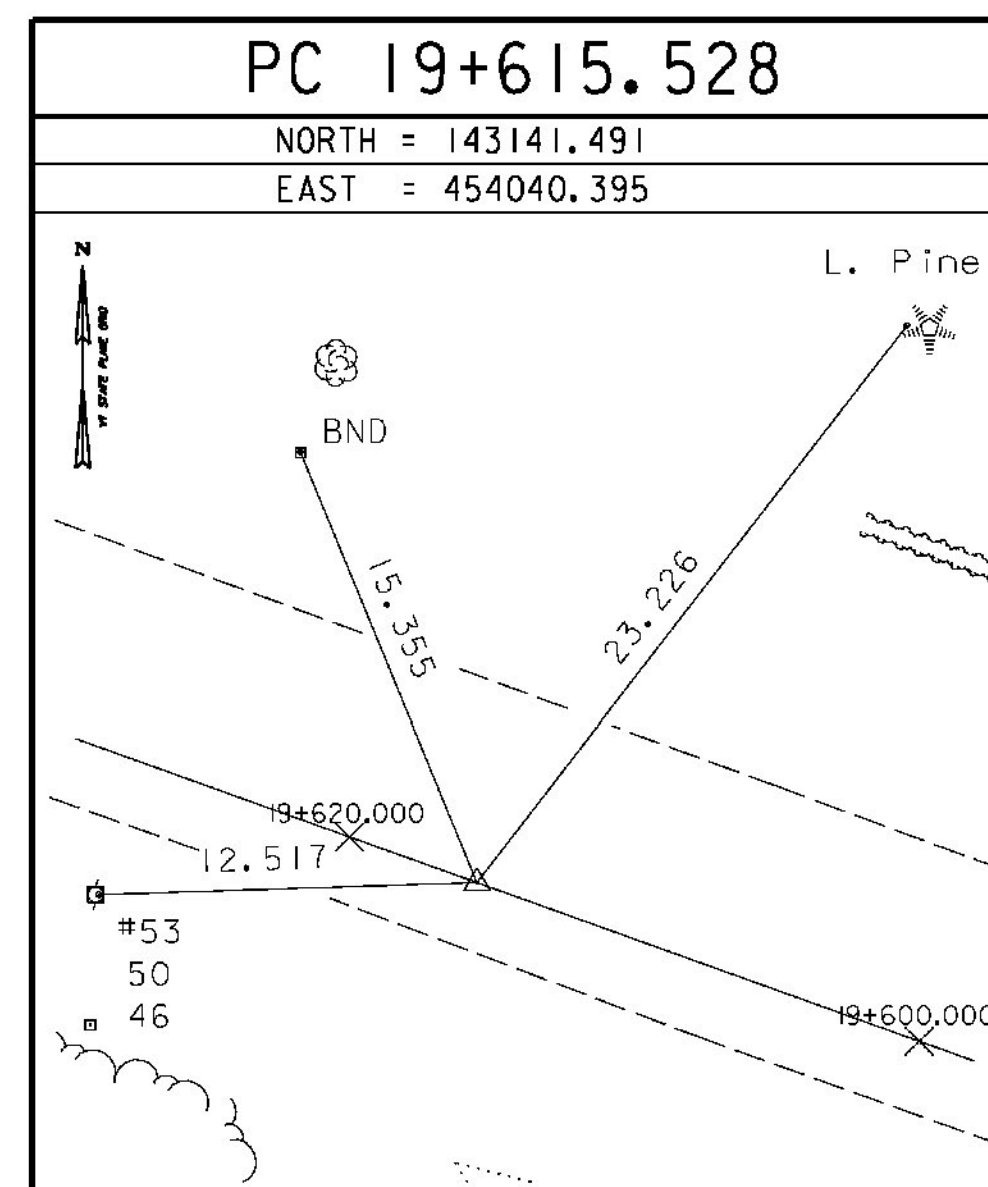

ALIGNMENT TIES

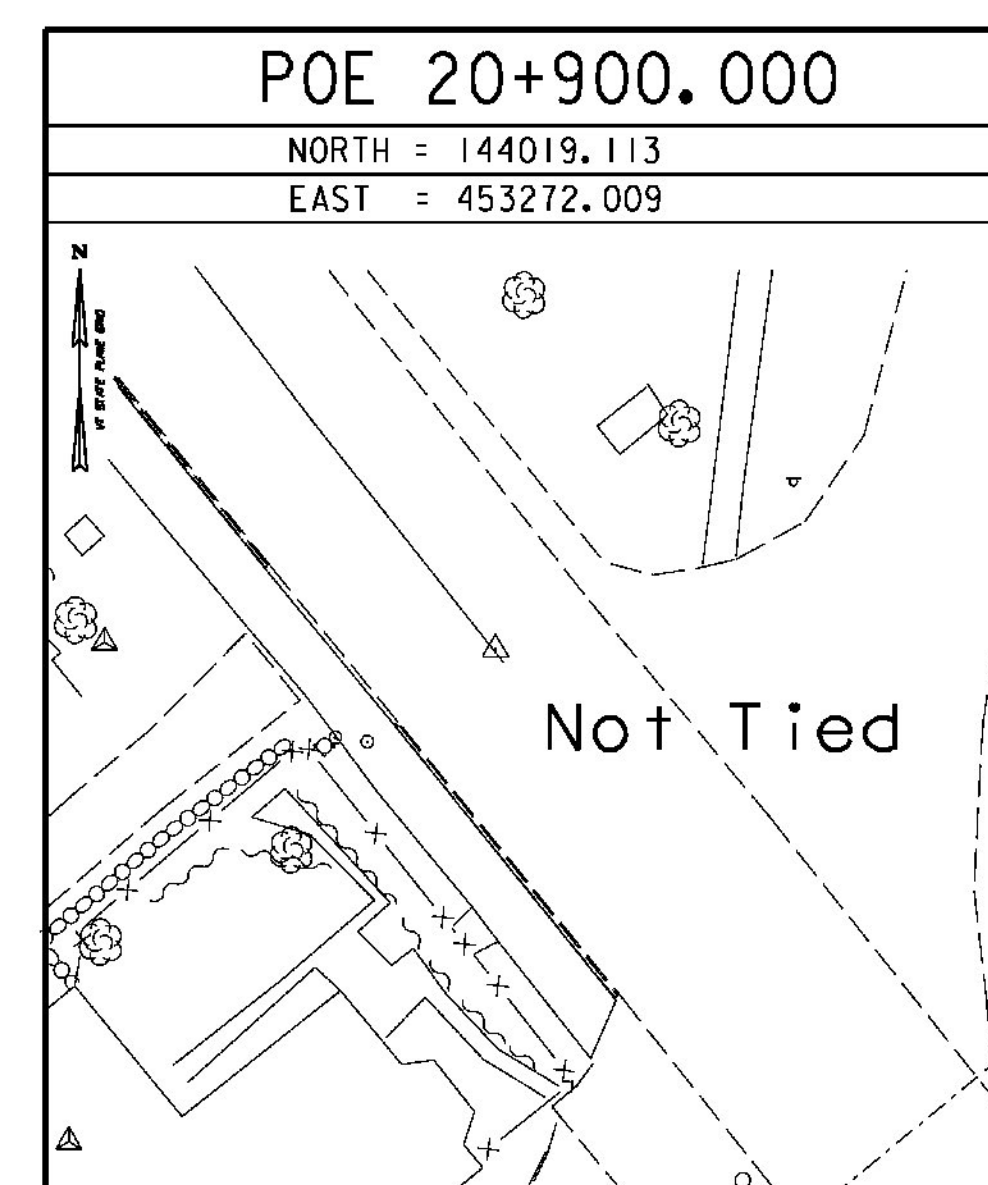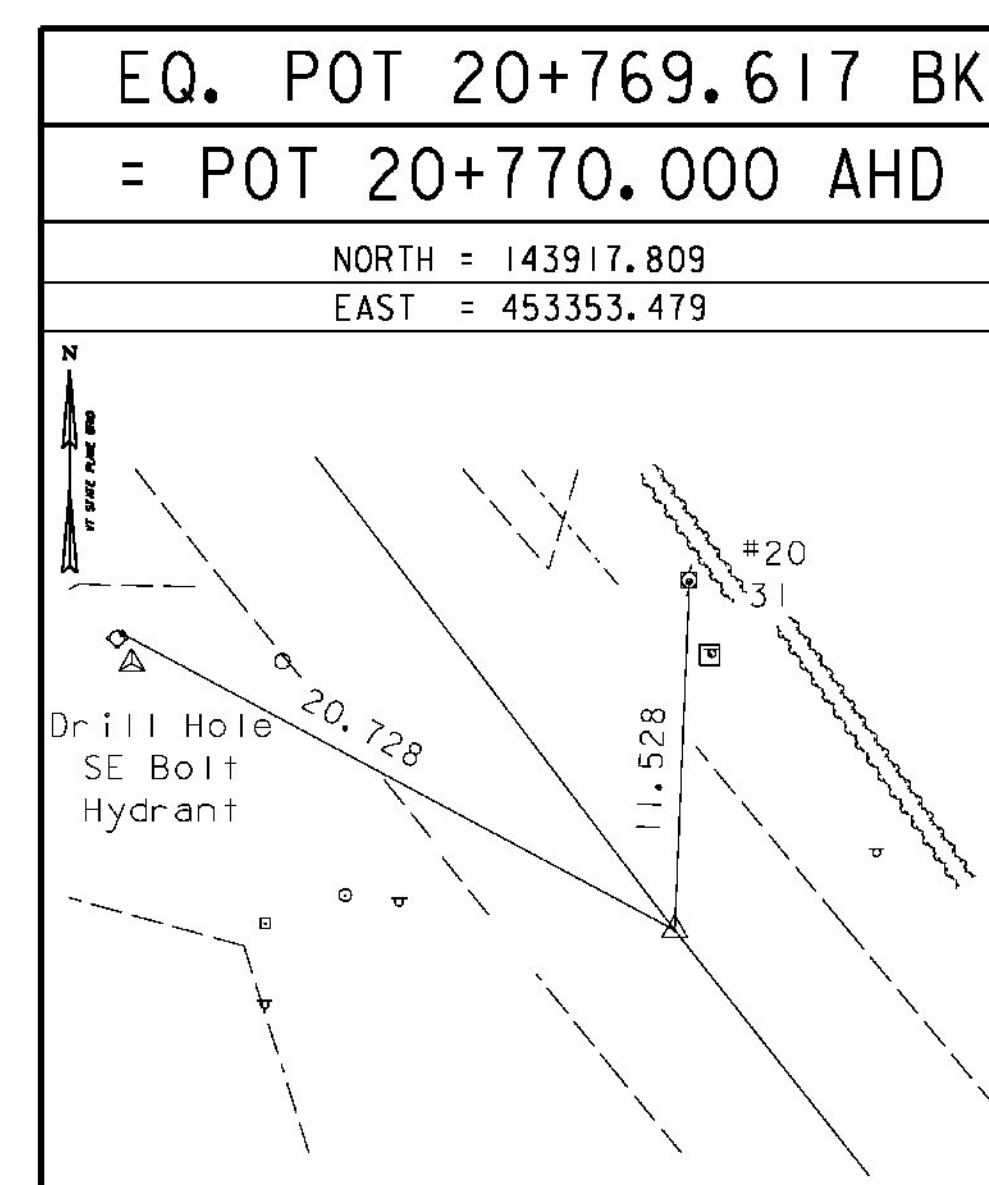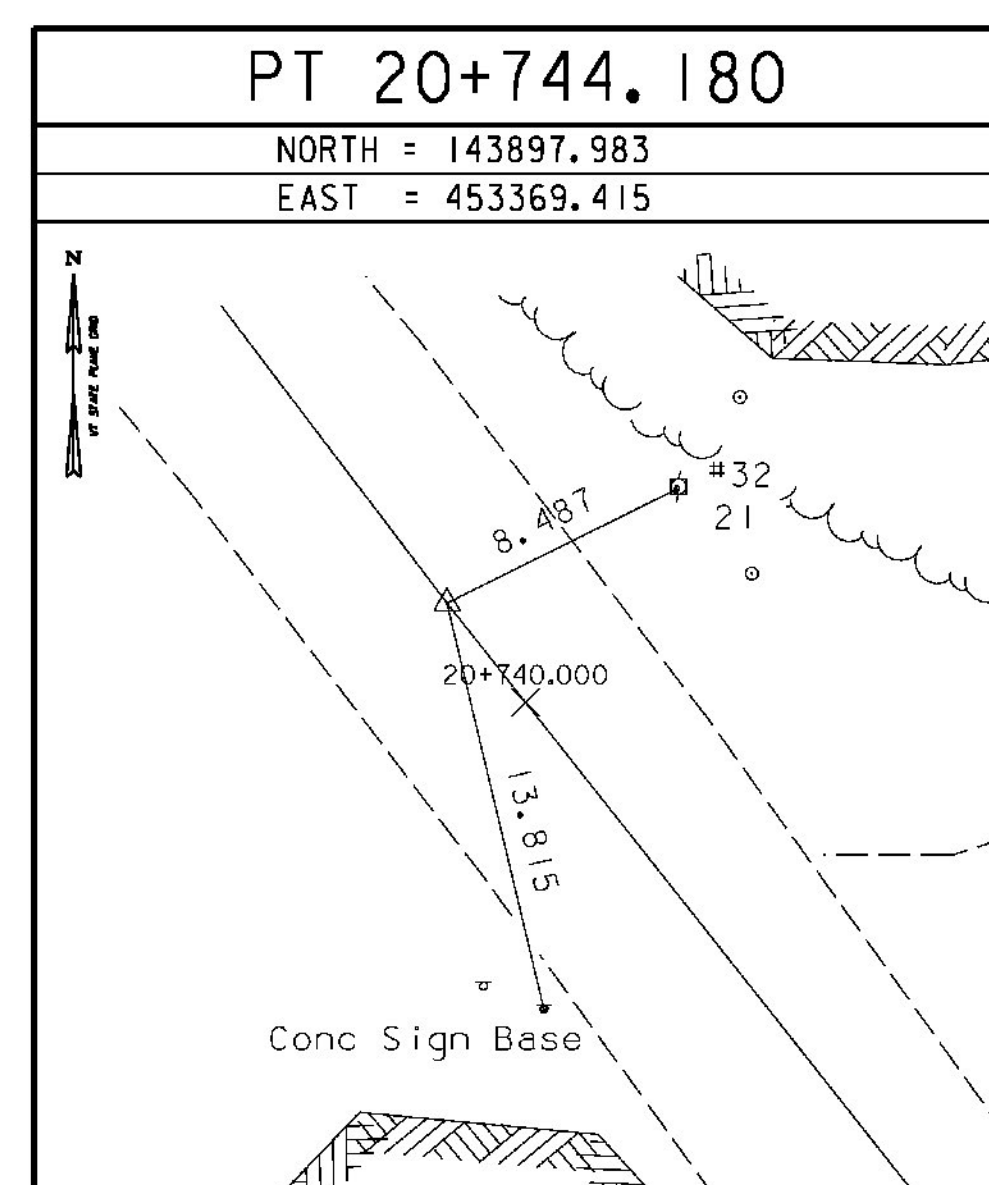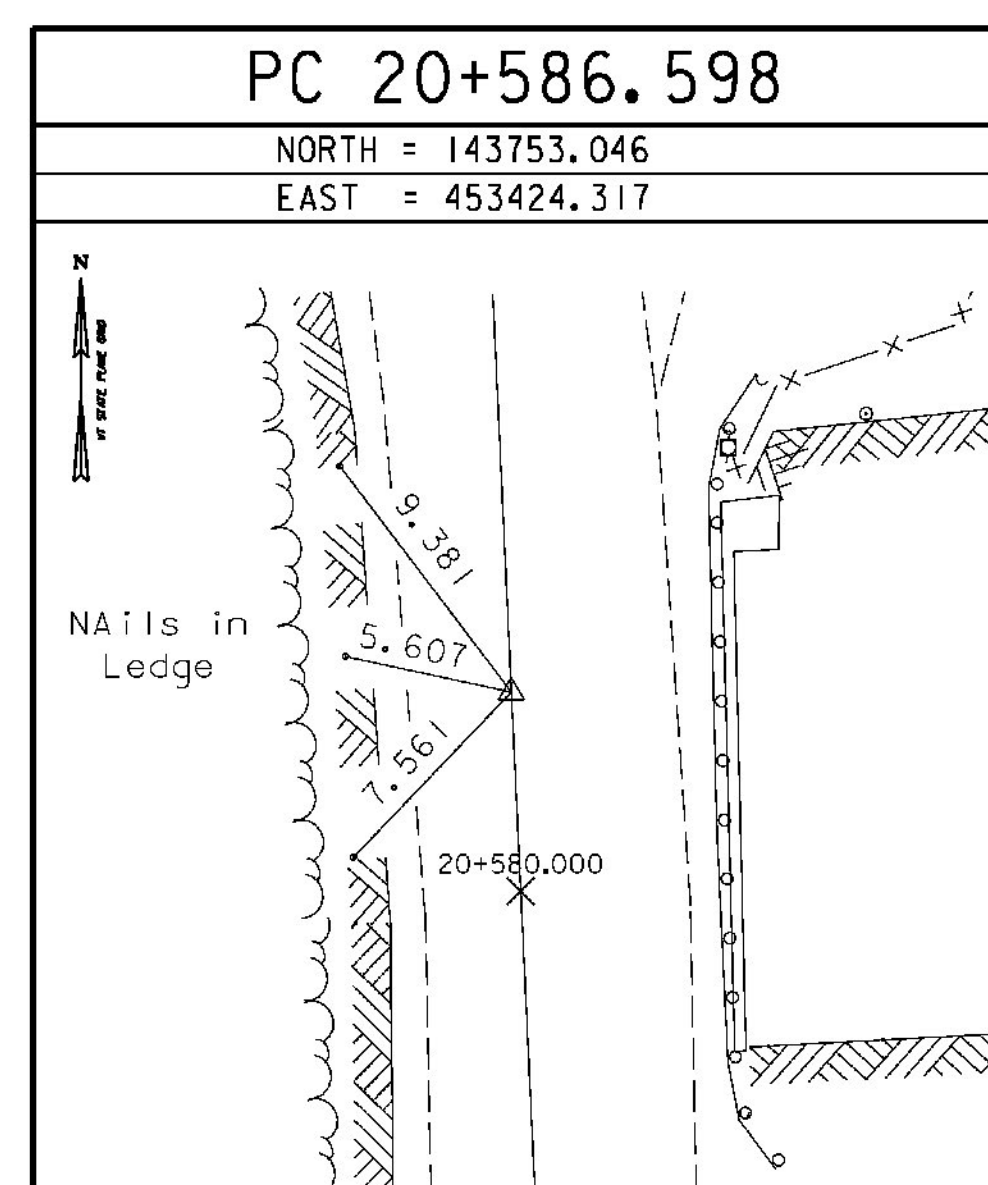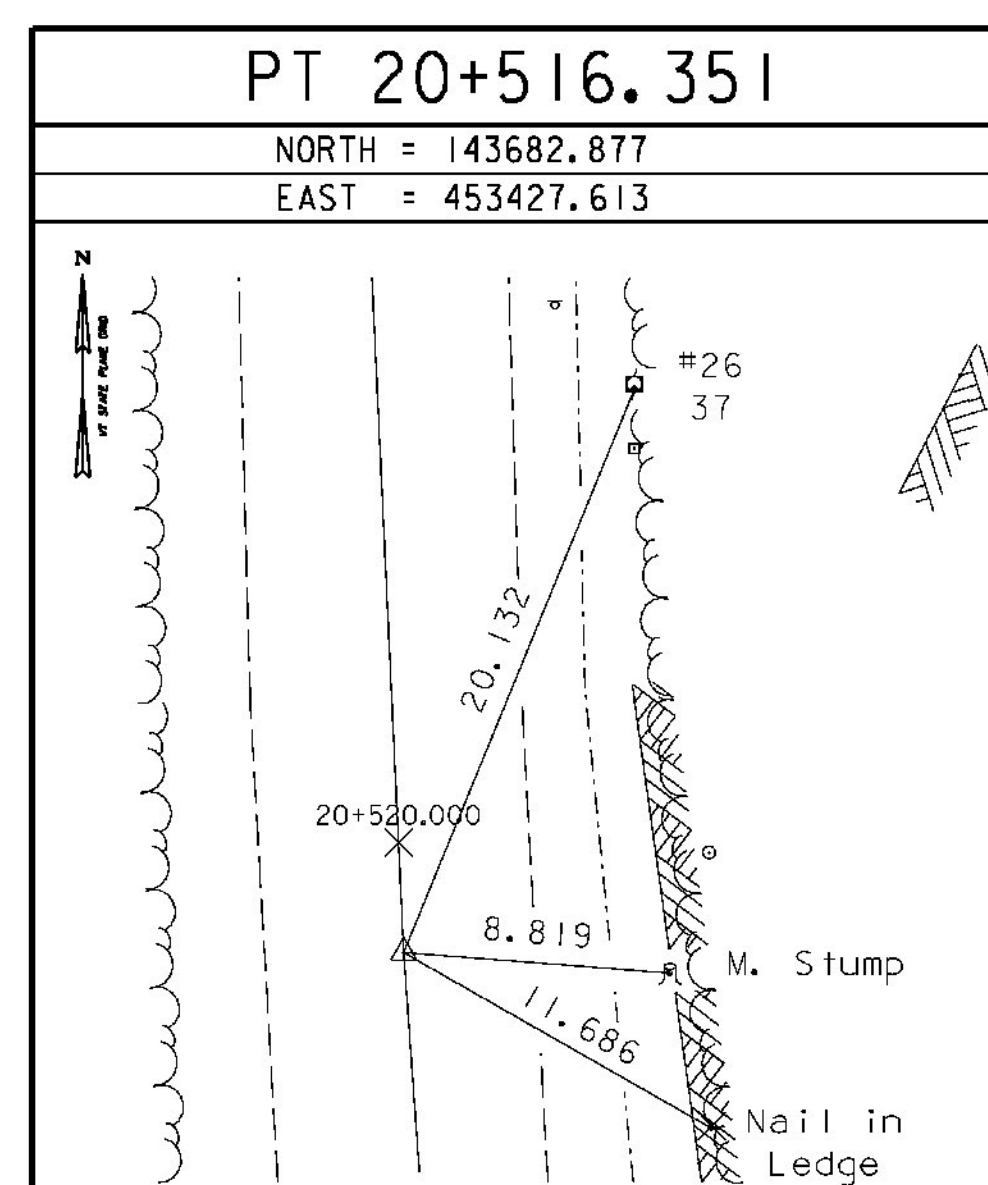

DATUM

VERTICAL	NAVD 88
HORIZONTAL	NAD 83/92
ADJUSTMENT	Least Squares

TIE SHEET

PROJECT NAME:	BRANDON	PLOT DATE:	9/3/2009
PROJECT NUMBER:	NH 019-3(495)	DRAWN BY:	R. Bullock
FILE NAME:	x85b008s5-t103.dgn	CHECKED BY:	VTRANS
PROJECT LEADER:	VAOT	SHEET	67 OF 546
DESIGNED BY:	VTRANS		
CLD 02-0149			

NOTE: ALL TIE DISTANCES IN METERS