


NOTE
 1. EXISTING GROUND ELEVATION IS SHOWN LIGHT.
 2. FINISH GRADE ELEVATION IS SHOWN IN BOLD.

POC 16+460.474 BK
 POC 16+460.000 AHD
 EG. = +0.474 m

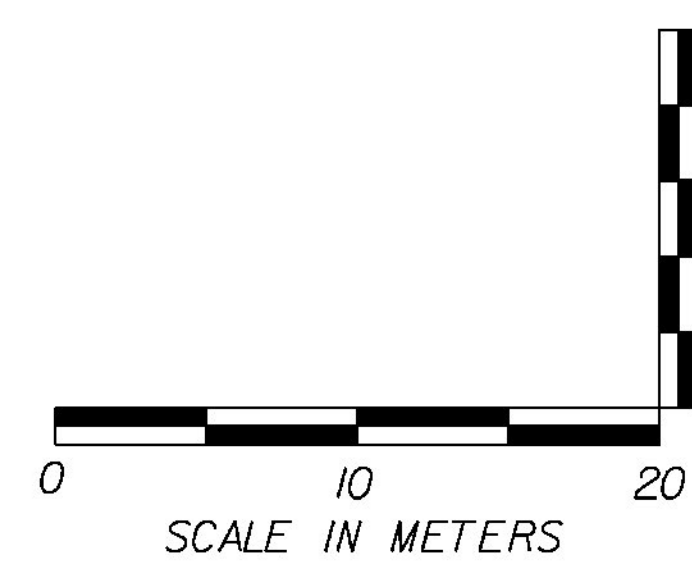

US 7 PROFILE 1

PROJECT NAME: BRANDON
 PROJECT NUMBER: NH 019-3(495)

FILE NAME: zb008s5-pro01.dgn
 PROJECT LEADER: CRB
 DESIGNED BY: DAM
 CLD 02-0149

PLOT DATE: 9/3/2009
 DRAWN BY: NLL
 CHECKED BY: PTS
 SHEET 69 OF 546