



CONSTRUCT DRIVES
 STA 16+730.0 RT - 6.8 m WIDE, PAVED-COMM.
 STA 16+775.0 LT - 7.2 m WIDE, PAVED-COMM.

REMOVAL AND DISPOSAL OF GUARDRAIL
 STA 16+749.4 - 16+764.7 LT
 STA 16+783.6 - 16+807.0 LT

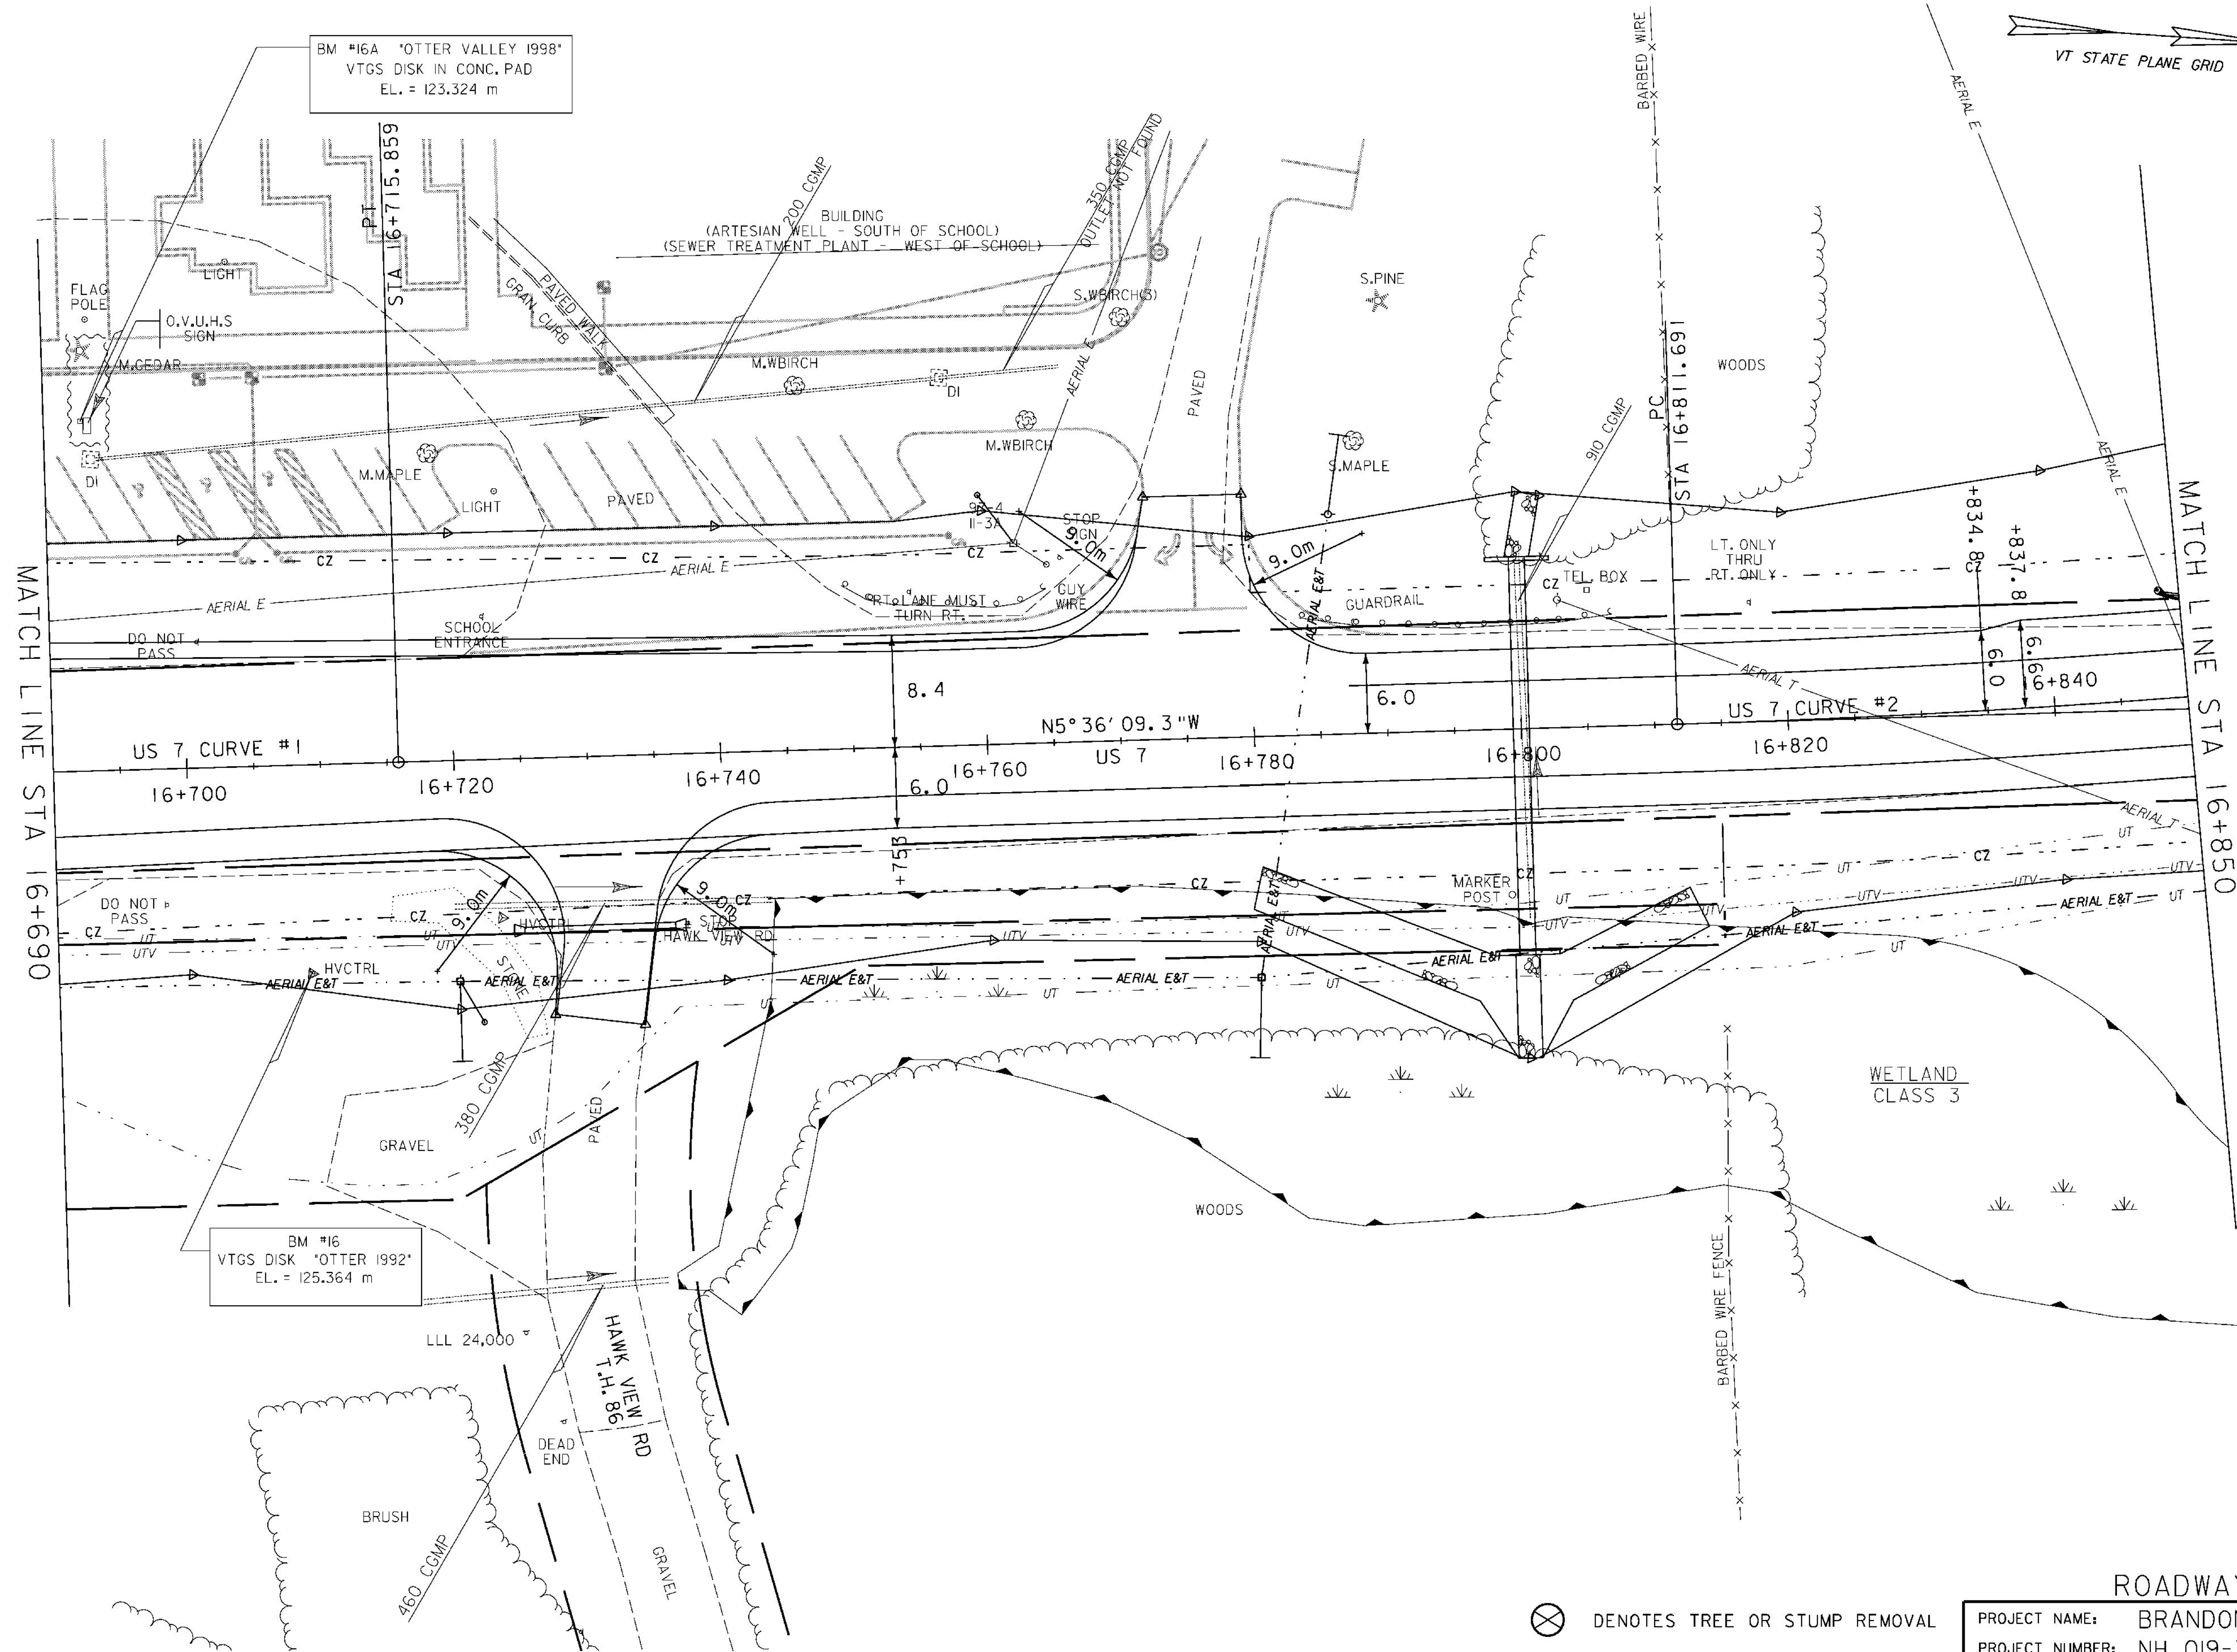

MATCH LINE STA 16+690

MATCH LINE STA 16+850

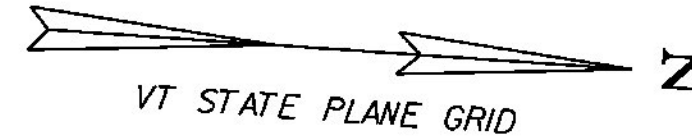

⊗ DENOTES TREE OR STUMP REMOVAL



ROADWAY LAYOUT 3

PROJECT NAME:	BRANDON	PLOT DATE:	9/3/2009
PROJECT NUMBER:	NH 019-3(495)	DRAWN BY:	NLL
FILE NAME:	zb008s5-gen03.dgn	CHECKED BY:	PTS
PROJECT LEADER:	CRB	CLD 02-0149	SHEET 72 OF 546