


**NOTE**  
 1. EXISTING GROUND ELEVATION IS SHOWN LIGHT.  
 2. FINISH GRADE ELEVATION IS SHOWN IN BOLD.

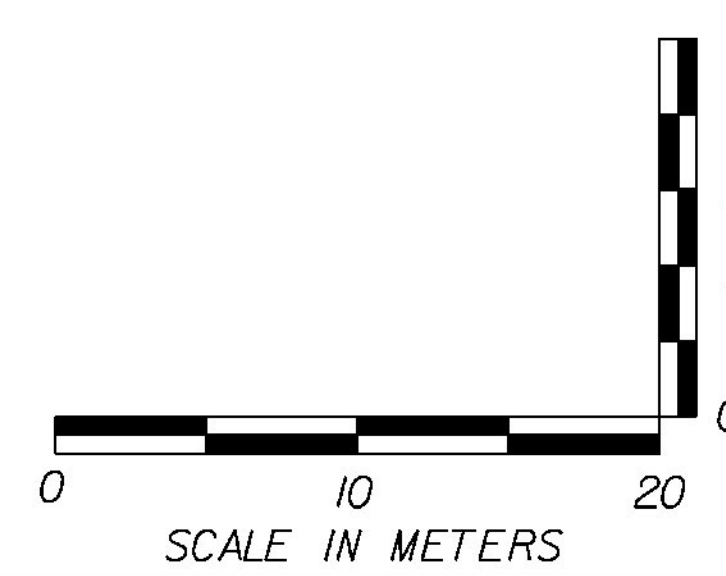

US 7 PROFILE 3

PROJECT NAME: BRANDON	PLOT DATE: 9/3/2009
PROJECT NUMBER: NH 019-3(495)	DRAWN BY: NLL
FILE NAME: zb008s5-pro03.dgn	CHECKED BY: PTS
PROJECT LEADER: CRB	SHEET 73 OF 546
DESIGNED BY: DAM	
CLD 02-0149	