
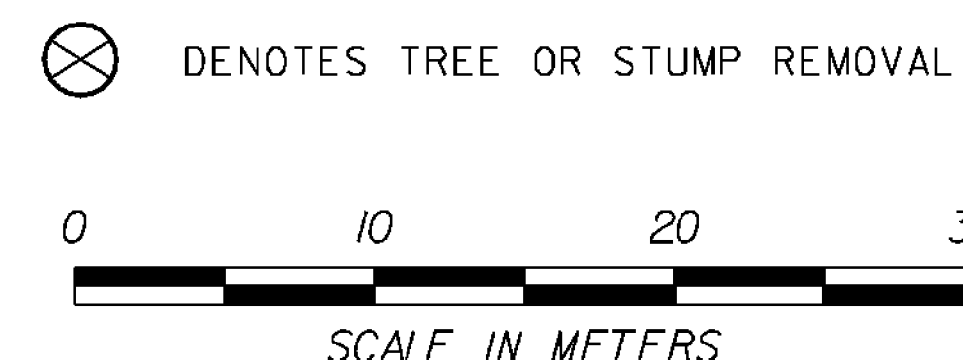


CONSTRUCT DRIVES
 STA 17+320.0 RT - 10.5 m WIDE, PAVED-COMM.

GRANITE SLOPE EDGING (100mm)
 STA 17+306.3 - 17+315.8 RT
 STA 17+326.5 - 17+330.0 RT (ISLAND)

STEEL BEAM GUARDRAIL, GALVANIZED
 STA 17+170.0 LT - 17+290.0 LT
 MANUFACTURED TERMINAL SECTION, TANGENT
 STA 17+290.0 LT

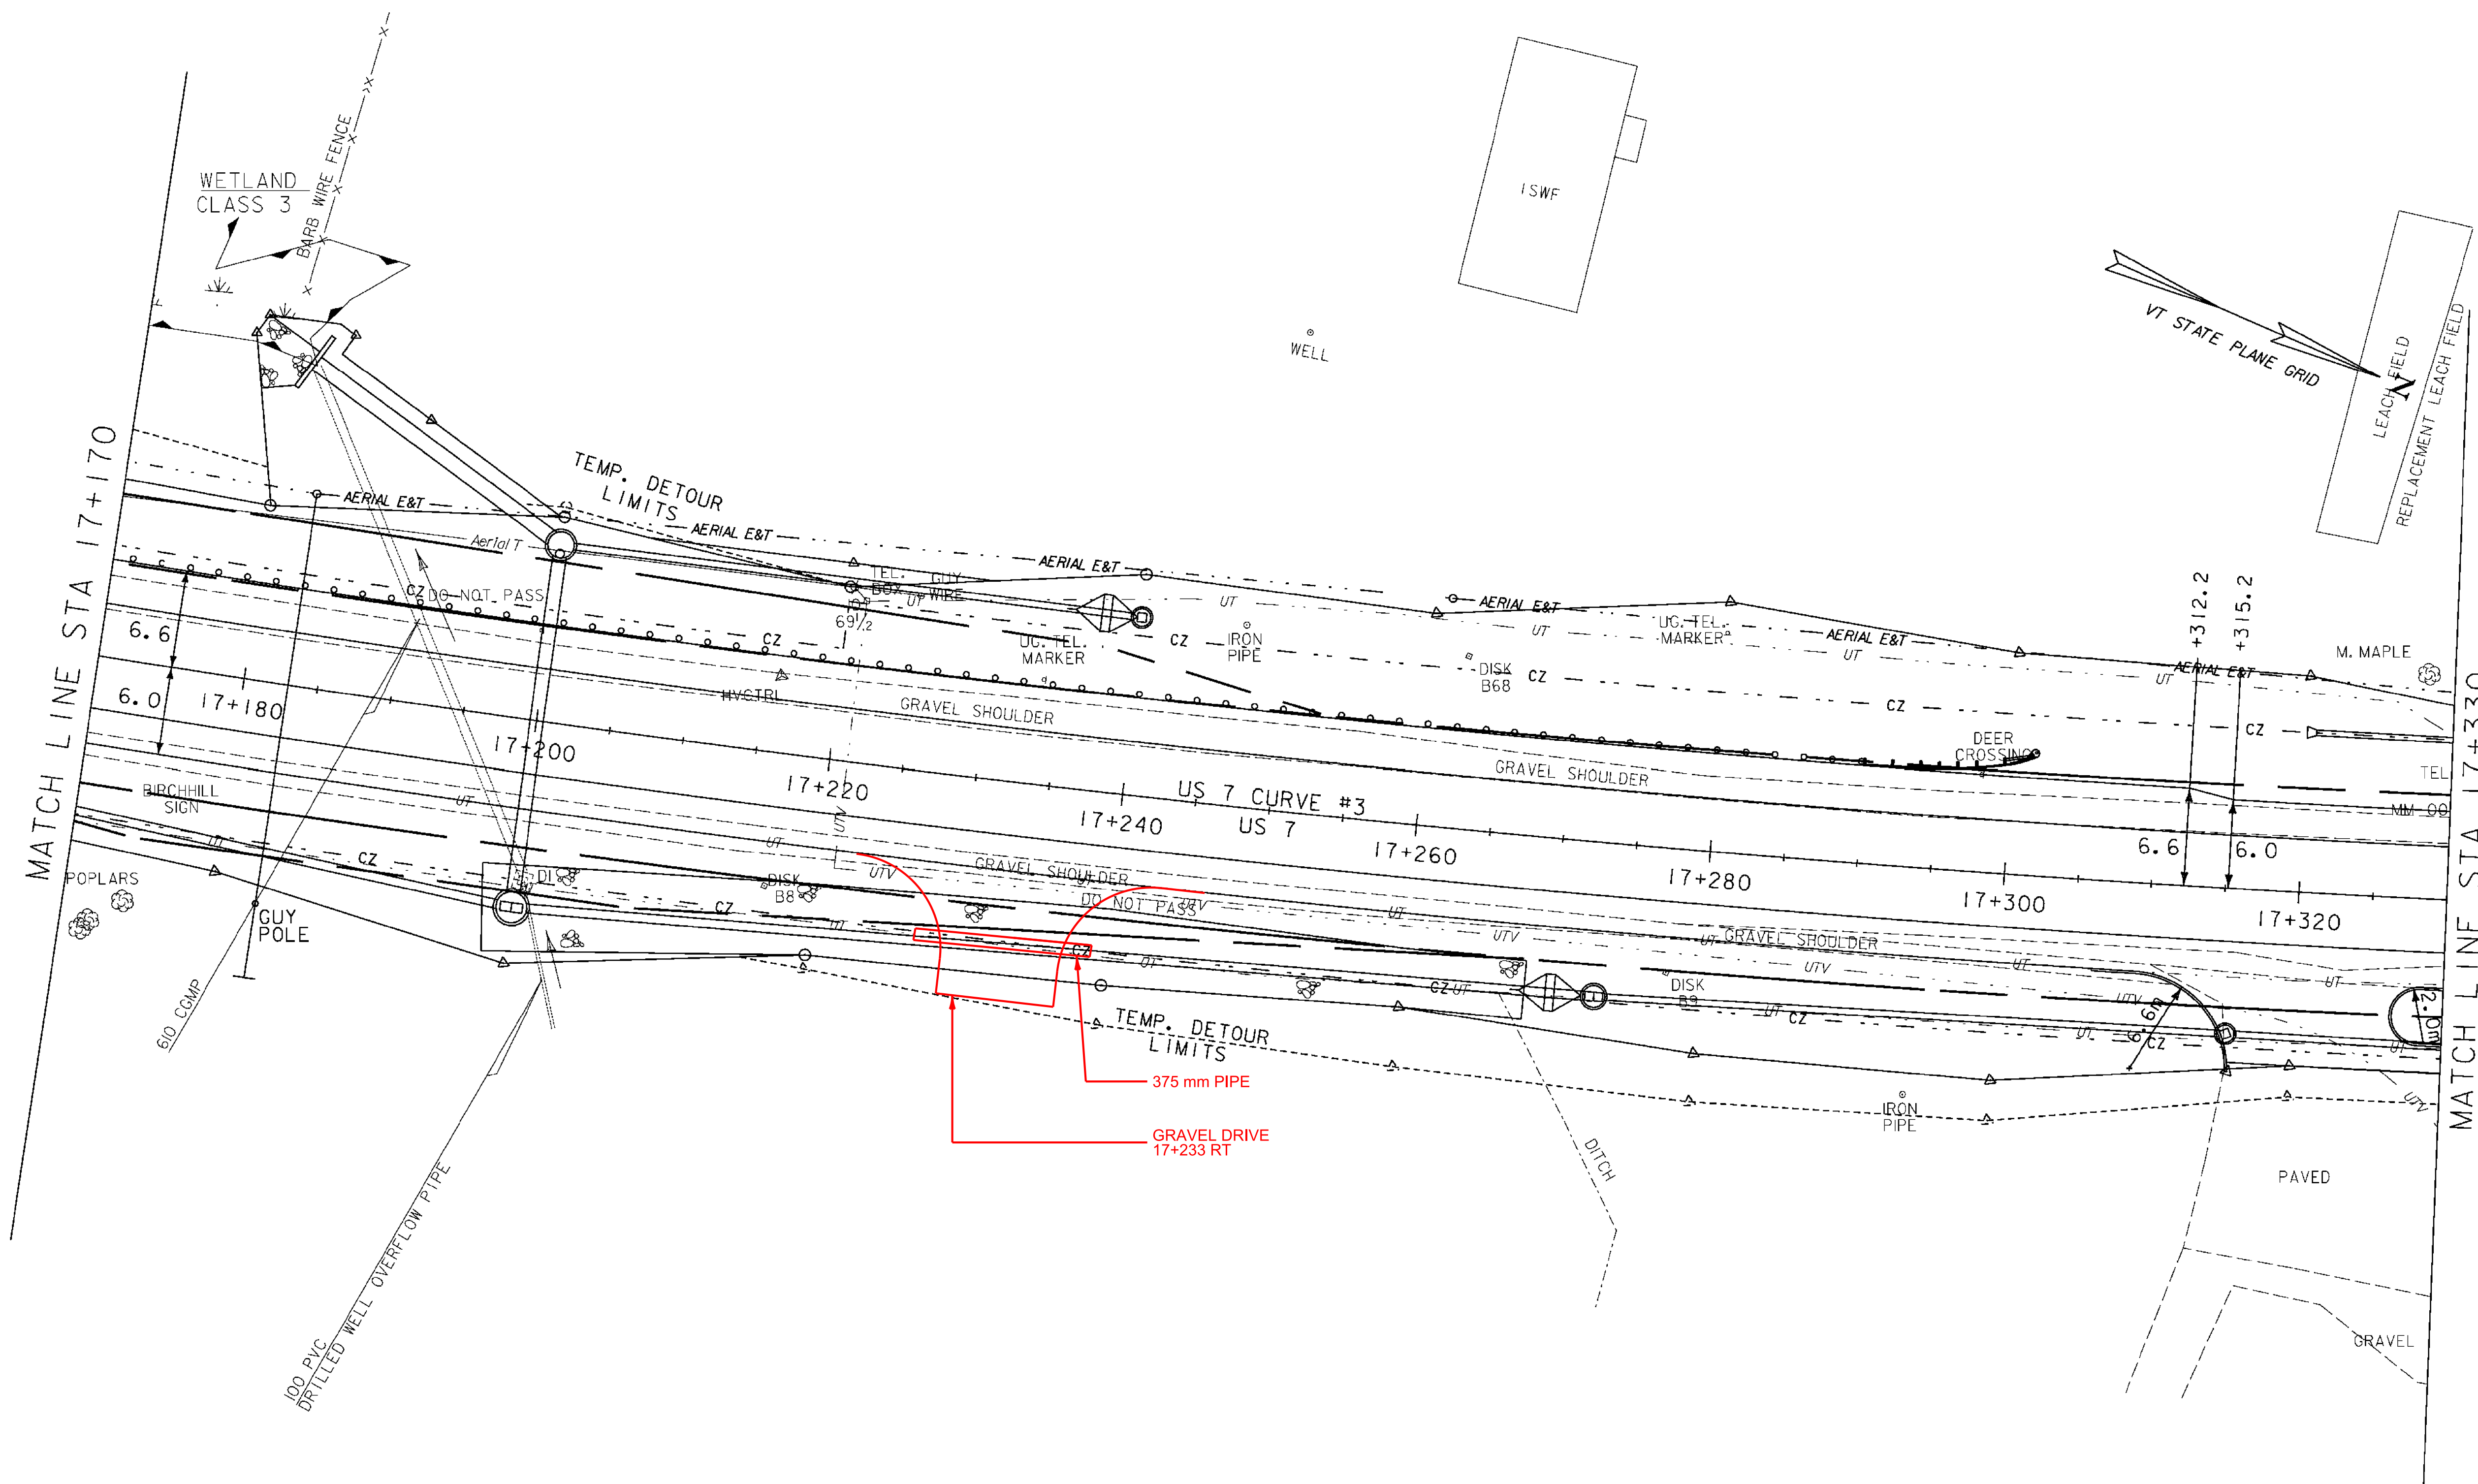

ROADWAY LAYOUT 6

PROJECT NAME:	BRANDON	FILE NAME:	zb008s5-gen06.dgn	PLOT DATE:	9/3/2009
PROJECT NUMBER:	NH 019-3(495)	PROJECT LEADER:	CRB	DRAWN BY:	NLL
		DESIGNED BY:	DAM	CHECKED BY:	PTS
		CLD 02-0149		SHEET 78	OF 546