


NOTE
 1. EXISTING GROUND ELEVATION IS SHOWN LIGHT.
 2. FINISH GRADE ELEVATION IS SHOWN IN BOLD.

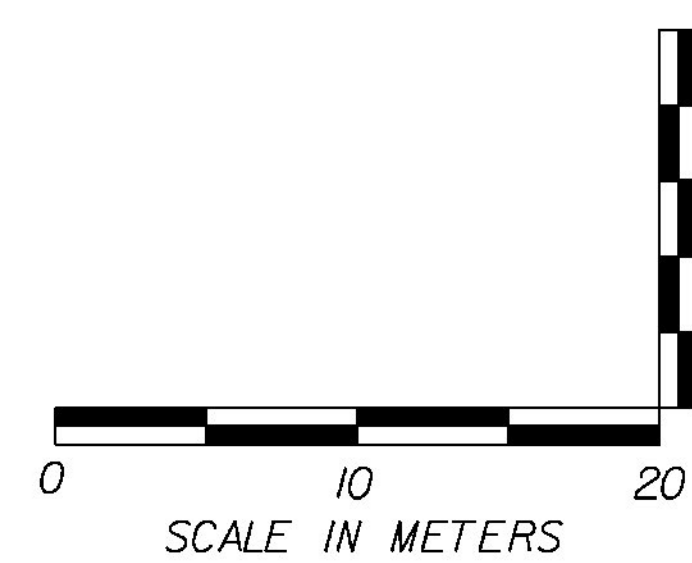

US 7 PROFILE 6

PROJECT NAME:	BRANDON	PLOT DATE:	9/3/2009
PROJECT NUMBER:	NH 019-3(495)	DRAWN BY:	NLL
FILE NAME:	zb008s5-pro06.dgn	CHECKED BY:	PTS
PROJECT LEADER:	CRB	CLD 02-0149	SHEET 79 OF 546
DESIGNED BY:	DAM		