



CONSTRUCT DRIVES

STA 17+530.0 LT - 11.0 m WIDE, COLORED STONE-COMM.
 STA 17+570.0 LT - 10.5 m WIDE, COLORED STONE-COMM.
 STA 17+620.0 RT - 12.0 m WIDE, PAVED-COMM.
 STA 1+040.0 RT - 6.0 m WIDE, GRAVEL-COMM.
 STA 1+060.0 LT - 12.0 m WIDE, PAVED-COMM.

REMOVING AND RESETTING FENCE

STA 17+580.0 - 17+588.4 LT
 STA 1+034.5 - 1+036.5 RT
 STA 1+043.2 - 1+047.5 RT

SPECIAL PROVISION (REMOVE AND RESET COMMERCIAL SIGN)
 STA 17+633 RT

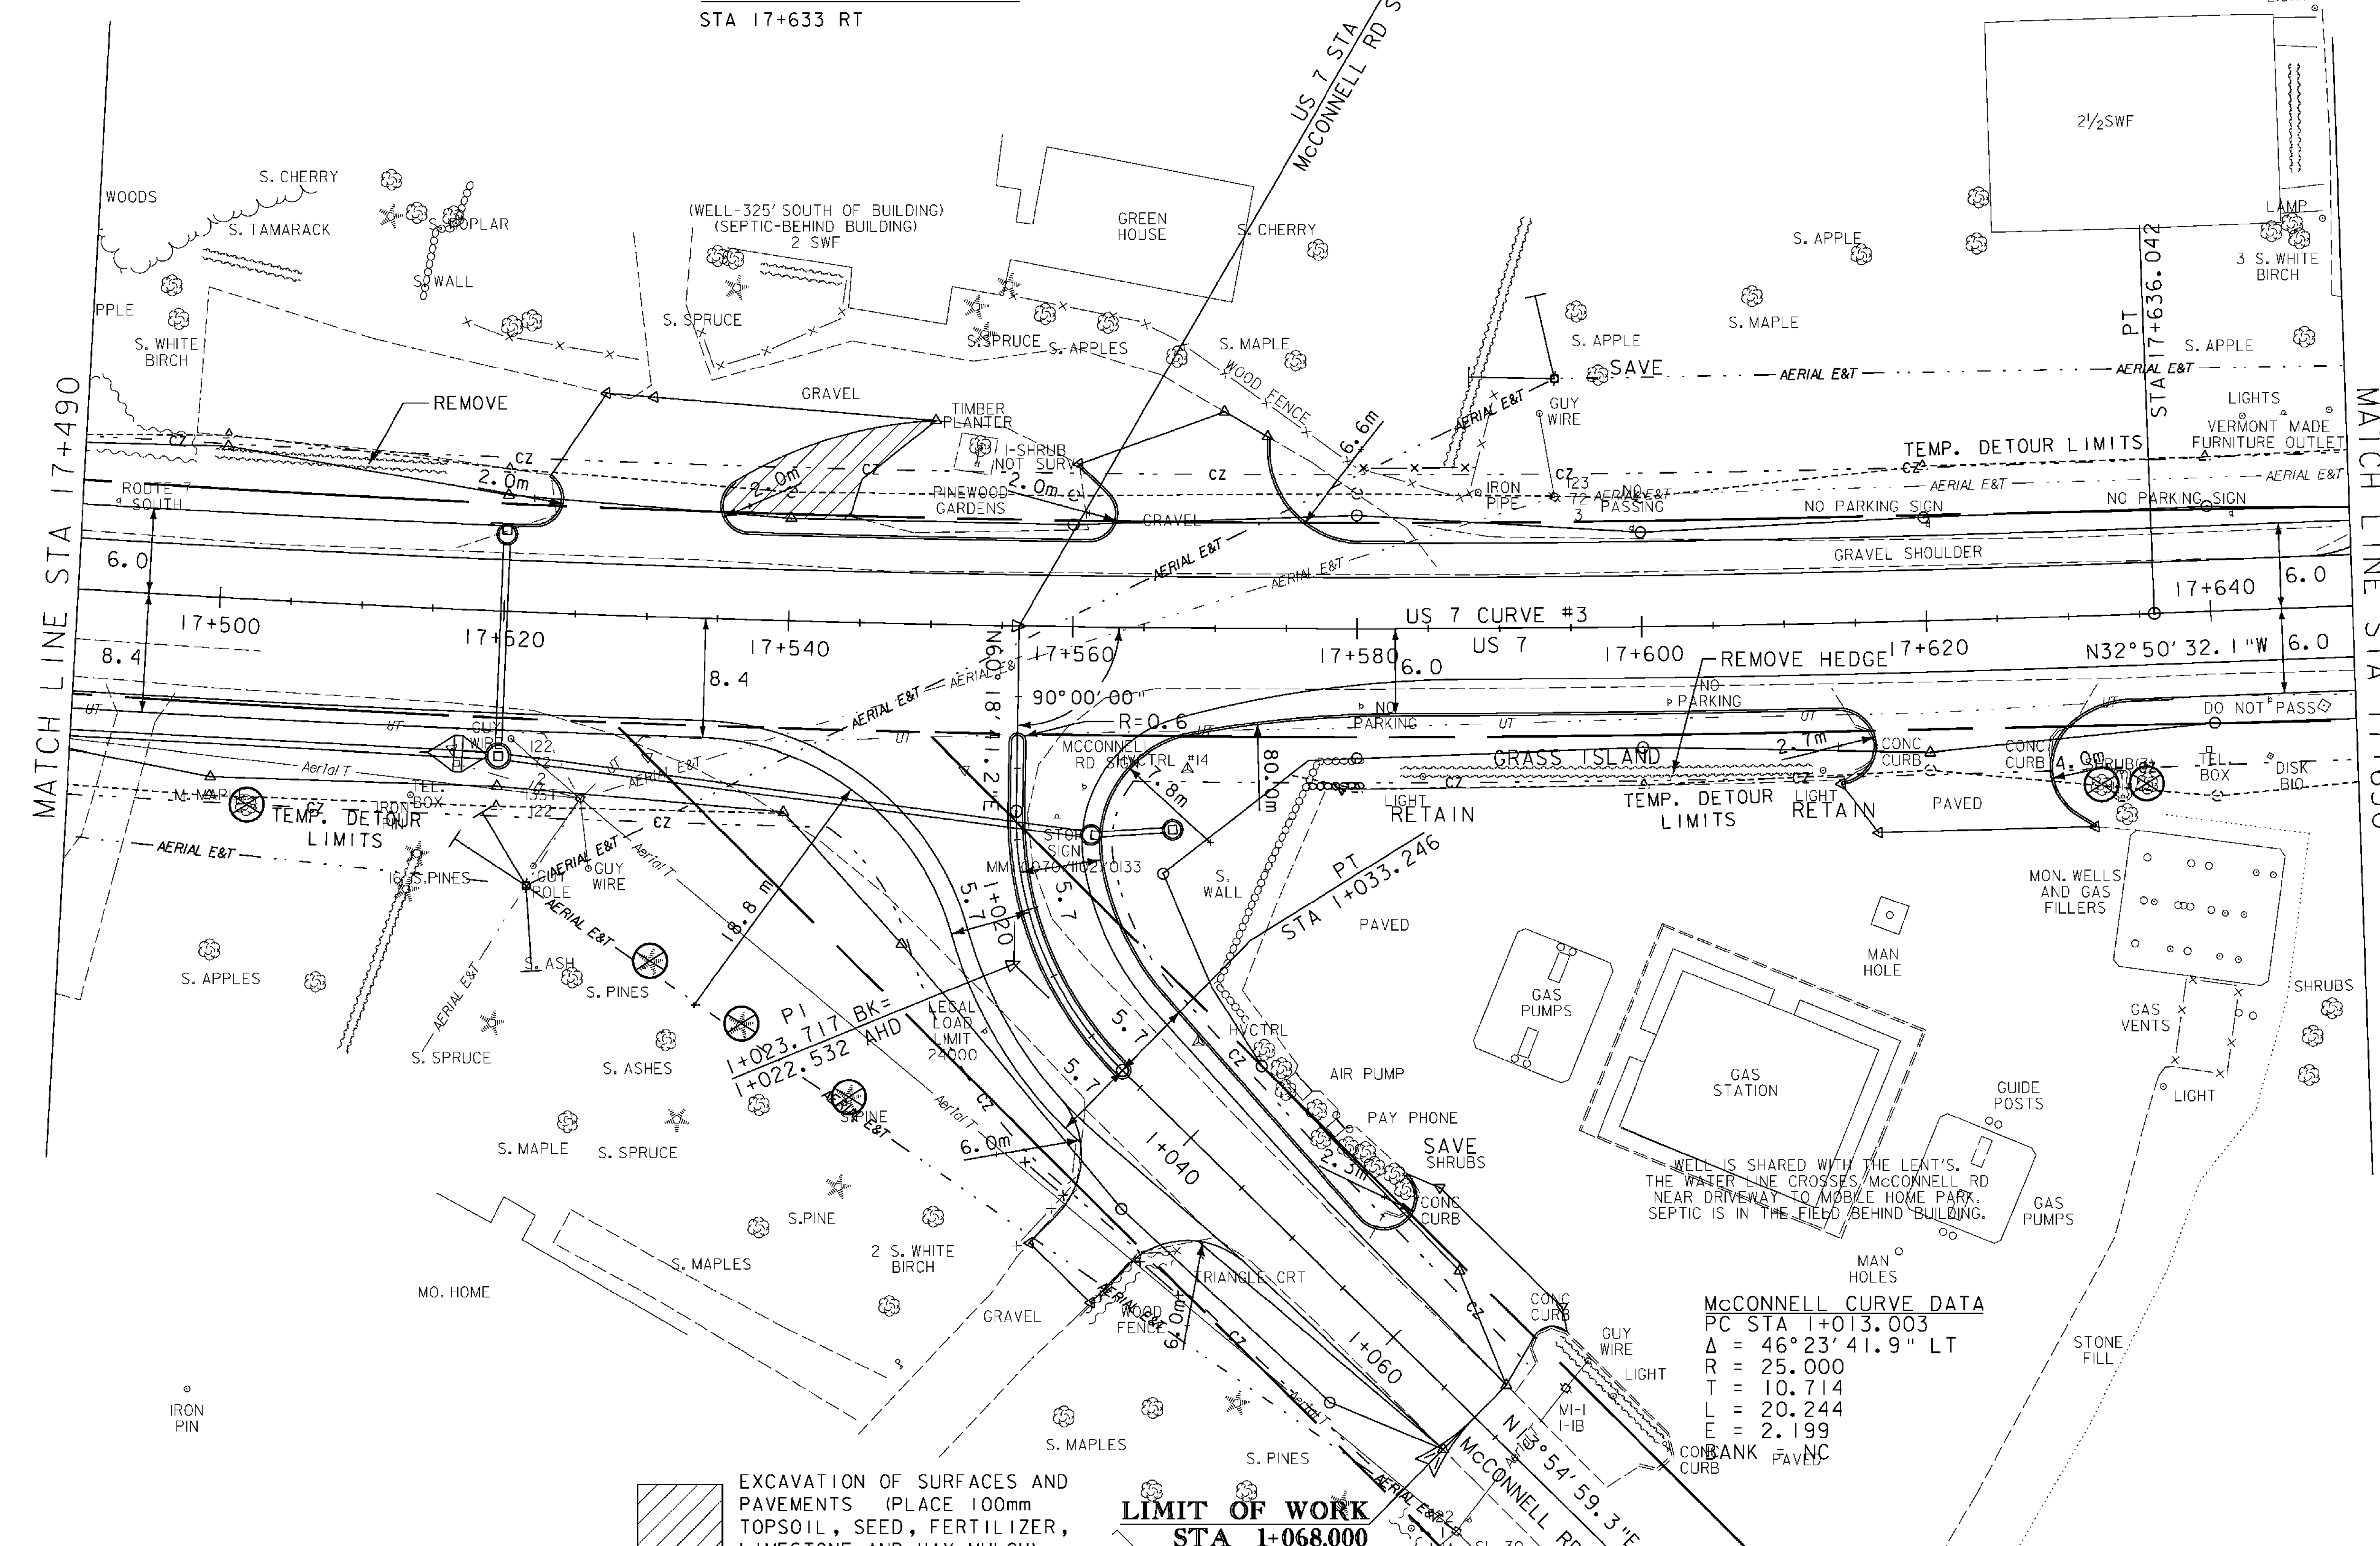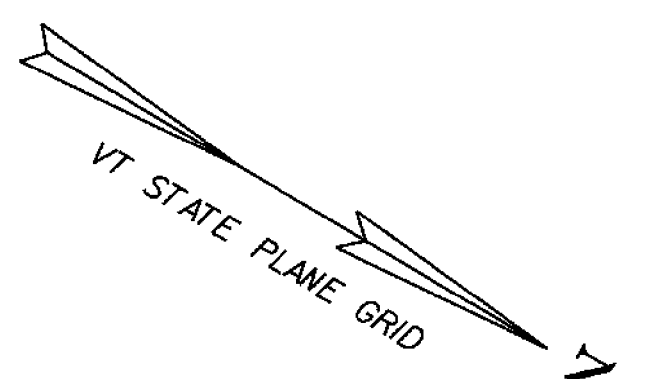

GRANITE SLOPE EDGING (100mm)


STA 17+518.8 - 17+523.8 LT
 STA 17+535.0 - 17+563.1 LT
 STA 17+568.3 - 17+616.2 RT
 STA 17+573.6 - 17+583.3 LT
 STA 17+628.4 - 17+637.1 RT
 STA 1+007.5 - 1+033.8 LT & RT (McCONNELL ROAD) (ISLAND)
 STA 1+007.3 - 1+054.9 LT (McCONNELL ROAD)

EXCAVATION OF SURFACES AND PAVEMENTS (PLACE 100mm TOPSOIL, SEED, FERTILIZER, LIMESTONE AND HAY MULCH)
 STA 17+535.0 - 17+550.1 LT

~~BITUMINOUS CONCRETE CUTTERS AND TRAFFIC ISLANDS~~
~~STA 1+007.5 - 1+033.8 LT & RT (McCONNELL ROAD) (ISLAND)~~
 ISLAND REMOVED AT THE REQUEST OF THE TOWN OF BRANDON

LIMIT OF WORK
 STA 1+068.000

McCONNELL CURVE DATA
 PC STA 1+013.003
 $\Delta = 46^\circ 23' 41.9''$ LT
 R = 25.000
 T = 10.714
 L = 20.244
 E = 2.199

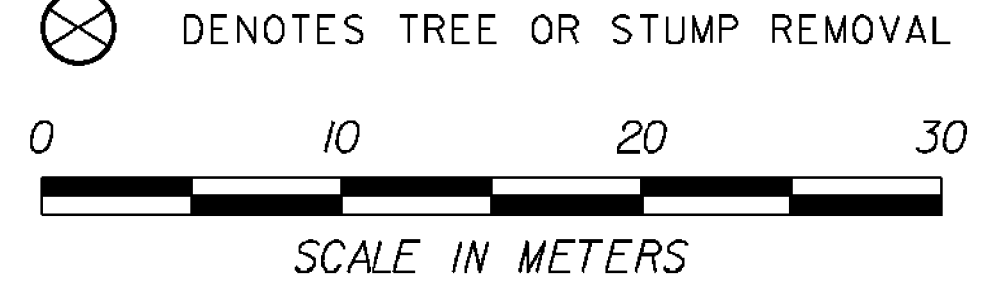

ROADWAY LAYOUT 8

PROJECT NAME:	BRANDON	FILE NAME:	zb008s5-gen08.dgn	PLOT DATE:	9/3/2009
PROJECT NUMBER:	NH 019-3(495)	PROJECT LEADER:	CRB	DRAWN BY:	NLL
		DESIGNED BY:	DAM	CHECKED BY:	PTS
		CLD 02-049		SHEET	82 OF 546