
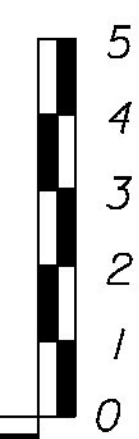


$L = 120$ m
 $K = 44$
 $SSD = 135$ m

PVT STA = 17+680.000
 PVT ELEV = 137.478

NOTE
 1. EXISTING GROUND ELEVATION IS SHOWN LIGHT.
 2. FINISH GRADE ELEVATION IS SHOWN IN BOLD.

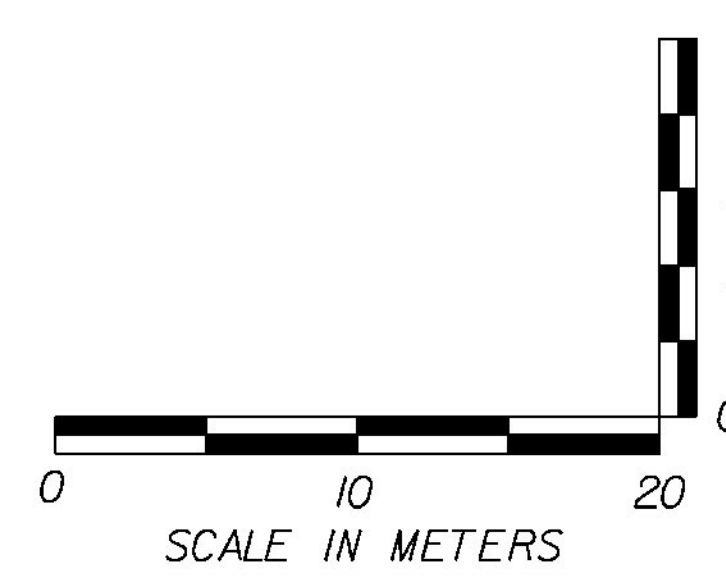

US 7 PROFILE 9

PROJECT NAME: BRANDON	PLOT DATE: 9/3/2009
PROJECT NUMBER: NH 019-3(495)	DRAWN BY: NLL
FILE NAME: zb008s5-pro09.dgn	CHECKED BY: PTS
PROJECT LEADER: CRB	SHEET 85 OF 546
DESIGNED BY: DAM	