


**NOTE**  
 1. EXISTING GROUND ELEVATION IS SHOWN LIGHT.  
 2. FINISH GRADE ELEVATION IS SHOWN IN BOLD.

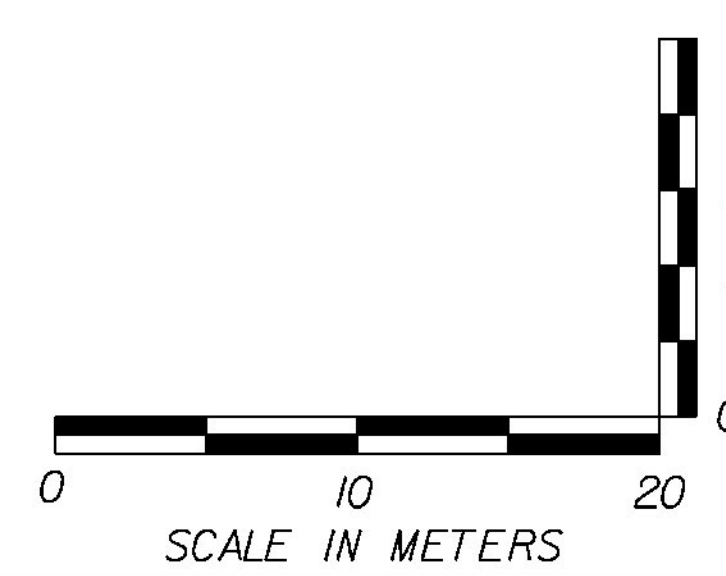

<b>US 7 PROFILE 10</b>	
PROJECT NAME:	BRANDON
PROJECT NUMBER:	NH 019-3(495)
FILE NAME: zb008s5-pro10.dgn	PLOT DATE: 9/3/2009
PROJECT LEADER: CRB	DRAWN BY: NLL
DESIGNED BY: DAM	CHECKED BY: PTS
CLD 02-0149	SHEET 87 OF 546