

CONSTRUCT DRIVES
 STA 20+173.0 RT - 3.6 m WIDE, GRAVEL-RES.
 STA 2+032.0 RT - 3.9 m WIDE, GRAVEL-RES.
 STA 2+042.0 RT - 3.6 m WIDE, GRAVEL-RES.

STEEL BEAM GUARDRAIL, GALVANIZED
 STA 20+030.0 - 20+068.2 LT


MANUFACTURED TERMINAL SECTION, TANGENT
 STA 20+068.2 LT

REMOVAL OF EXISTING FENCE
 STA 20+152.3 - 20+169.0 LT

NICKERSON CURVE DATA
 PC STA 2+007.973
 $\Delta = 9^{\circ}04'05.1''$ RT
 R = 300.000
 T = 23.790
 L = 47.480
 E = 0.942
 BANK = NC

LIMIT OF WORK
 STA 2+048.000

BM #7
 VTGS SURVEY MARK
 STAMPED "A97035"
 ELEV. = 136.949 m

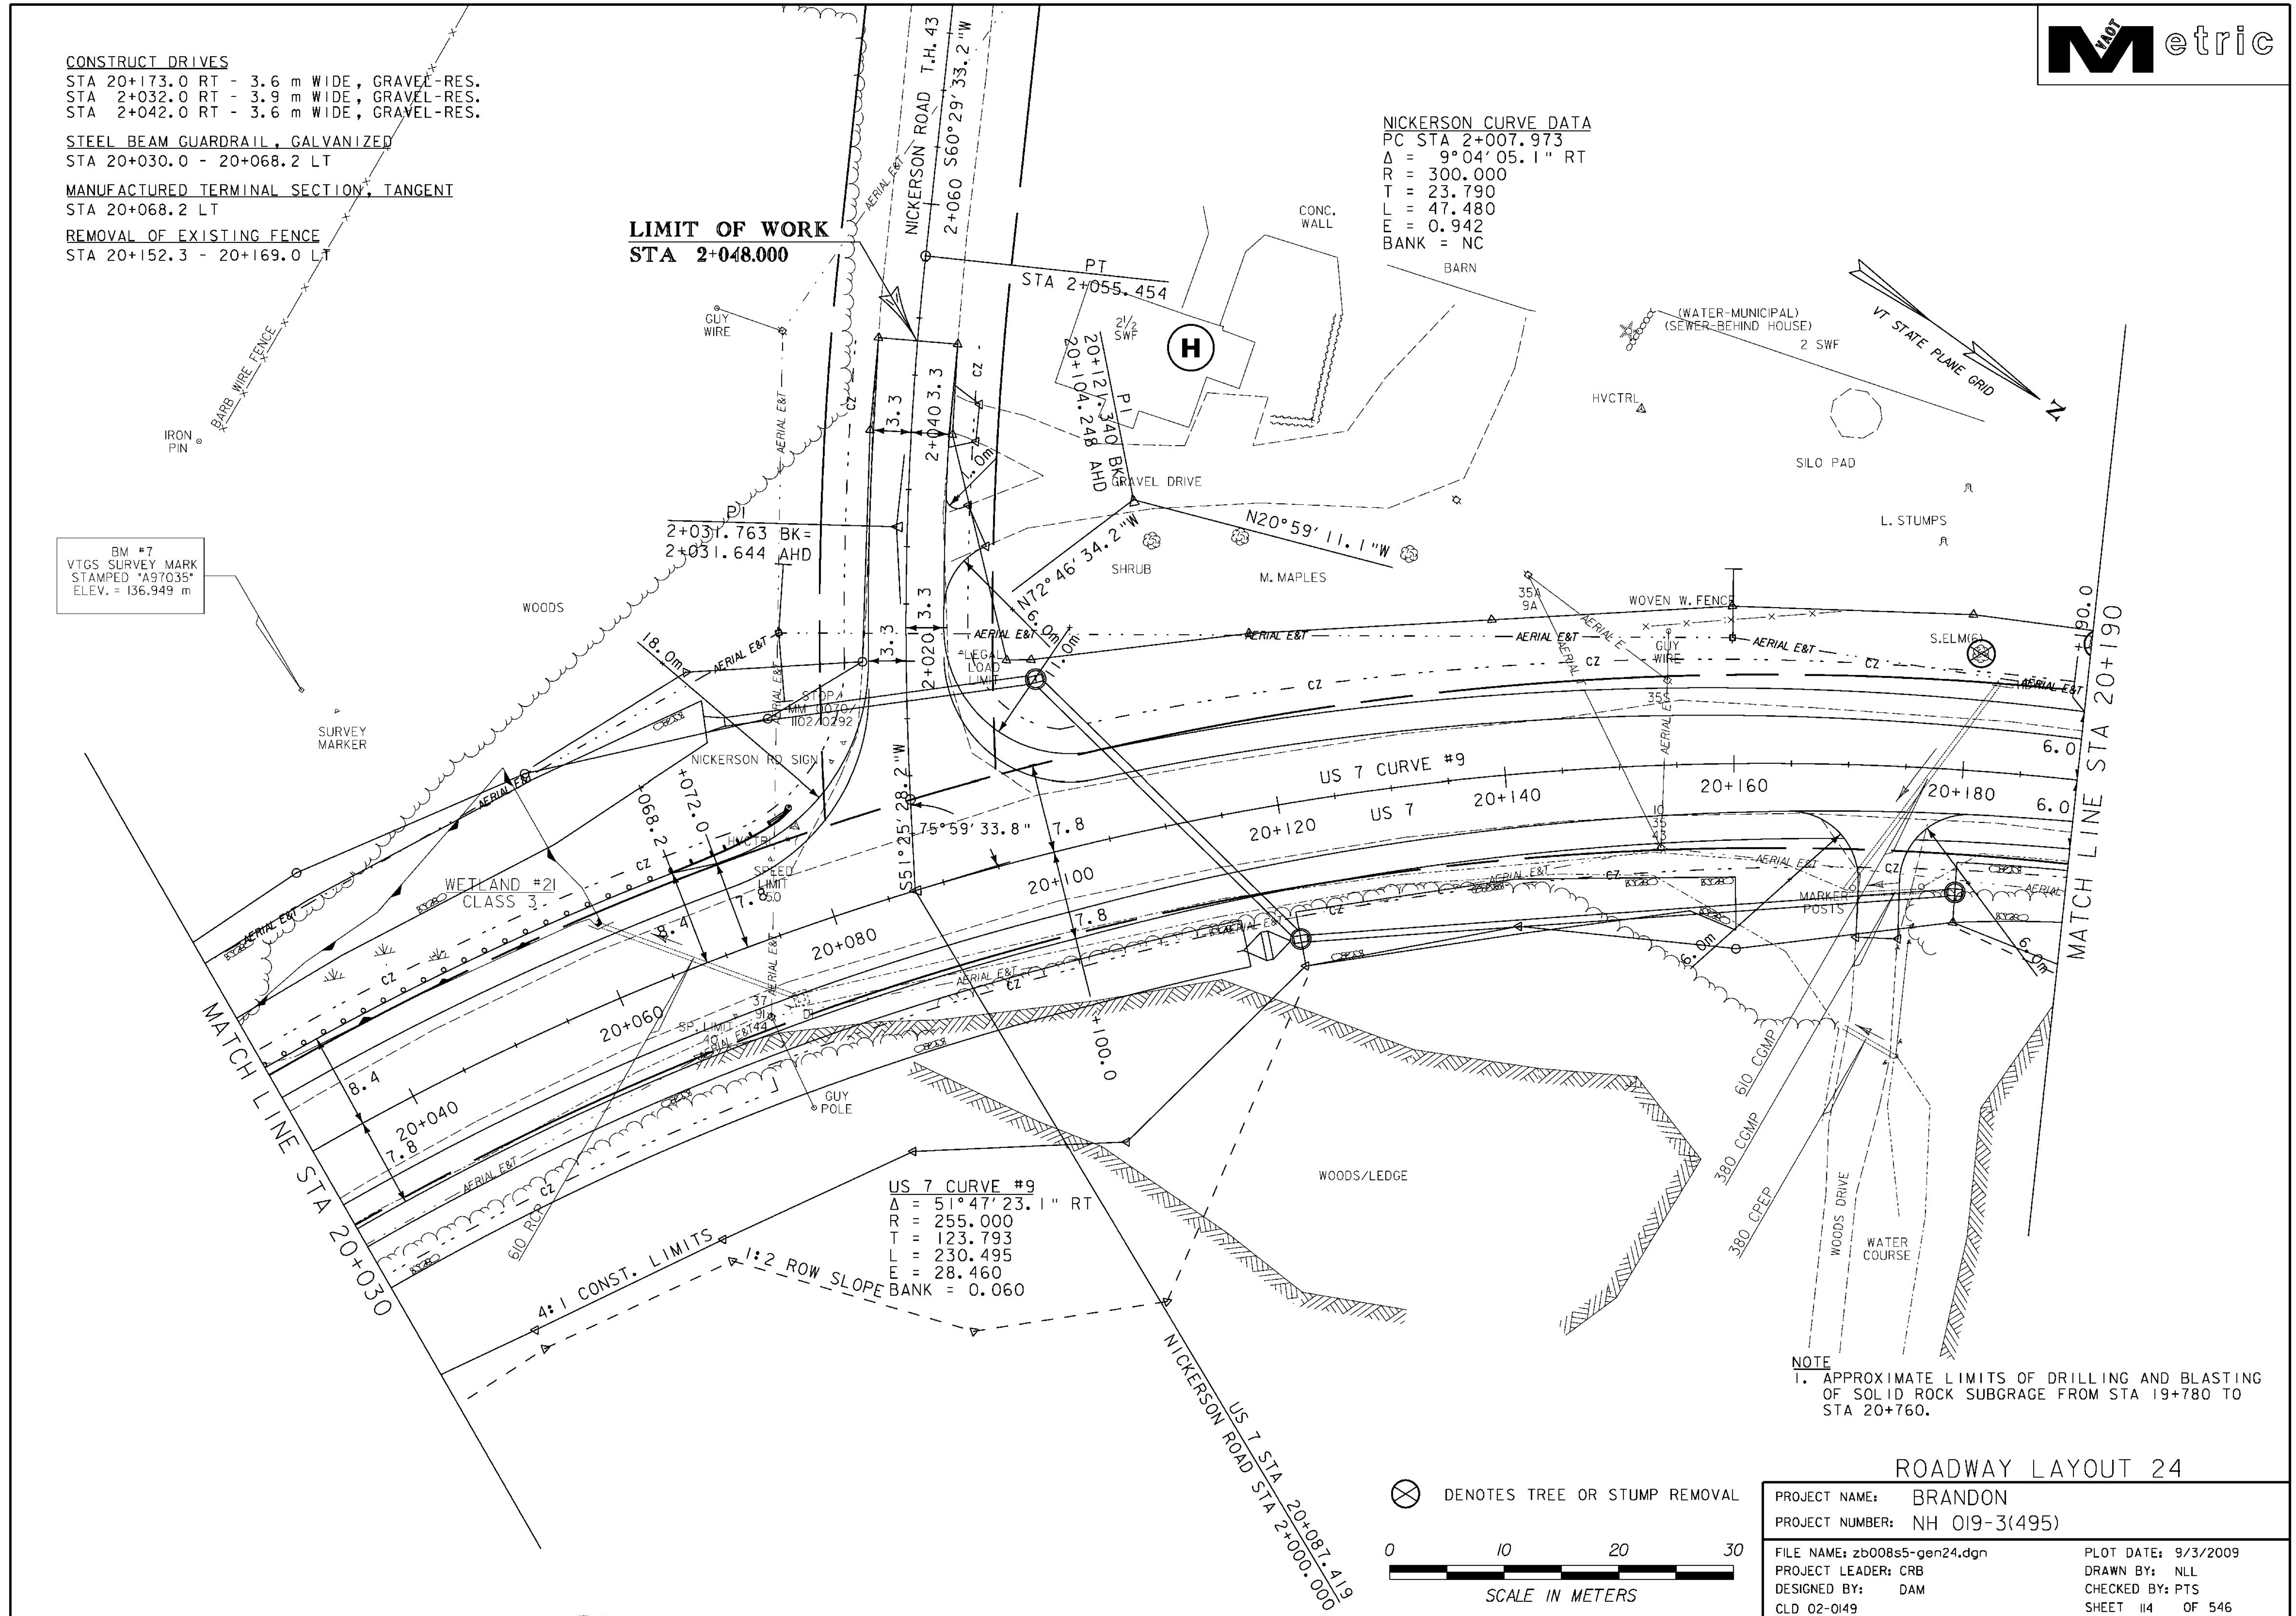

ROADWAY LAYOUT 24	
PROJECT NAME:	BRANDON
PROJECT NUMBER:	NH 019-3(495)
FILE NAME:	zb008s5-gen24.dgn
PROJECT LEADER:	CRB
DESIGNED BY:	DAM
CLD 02-0149	
PLOT DATE:	9/3/2009
DRAWN BY:	NLL
CHECKED BY:	PTS
	SHEET 114 OF 546