



US 7 STA 20+087.419
 NICKERSON ROAD STA 2+000.000
 ELEV. 136.971

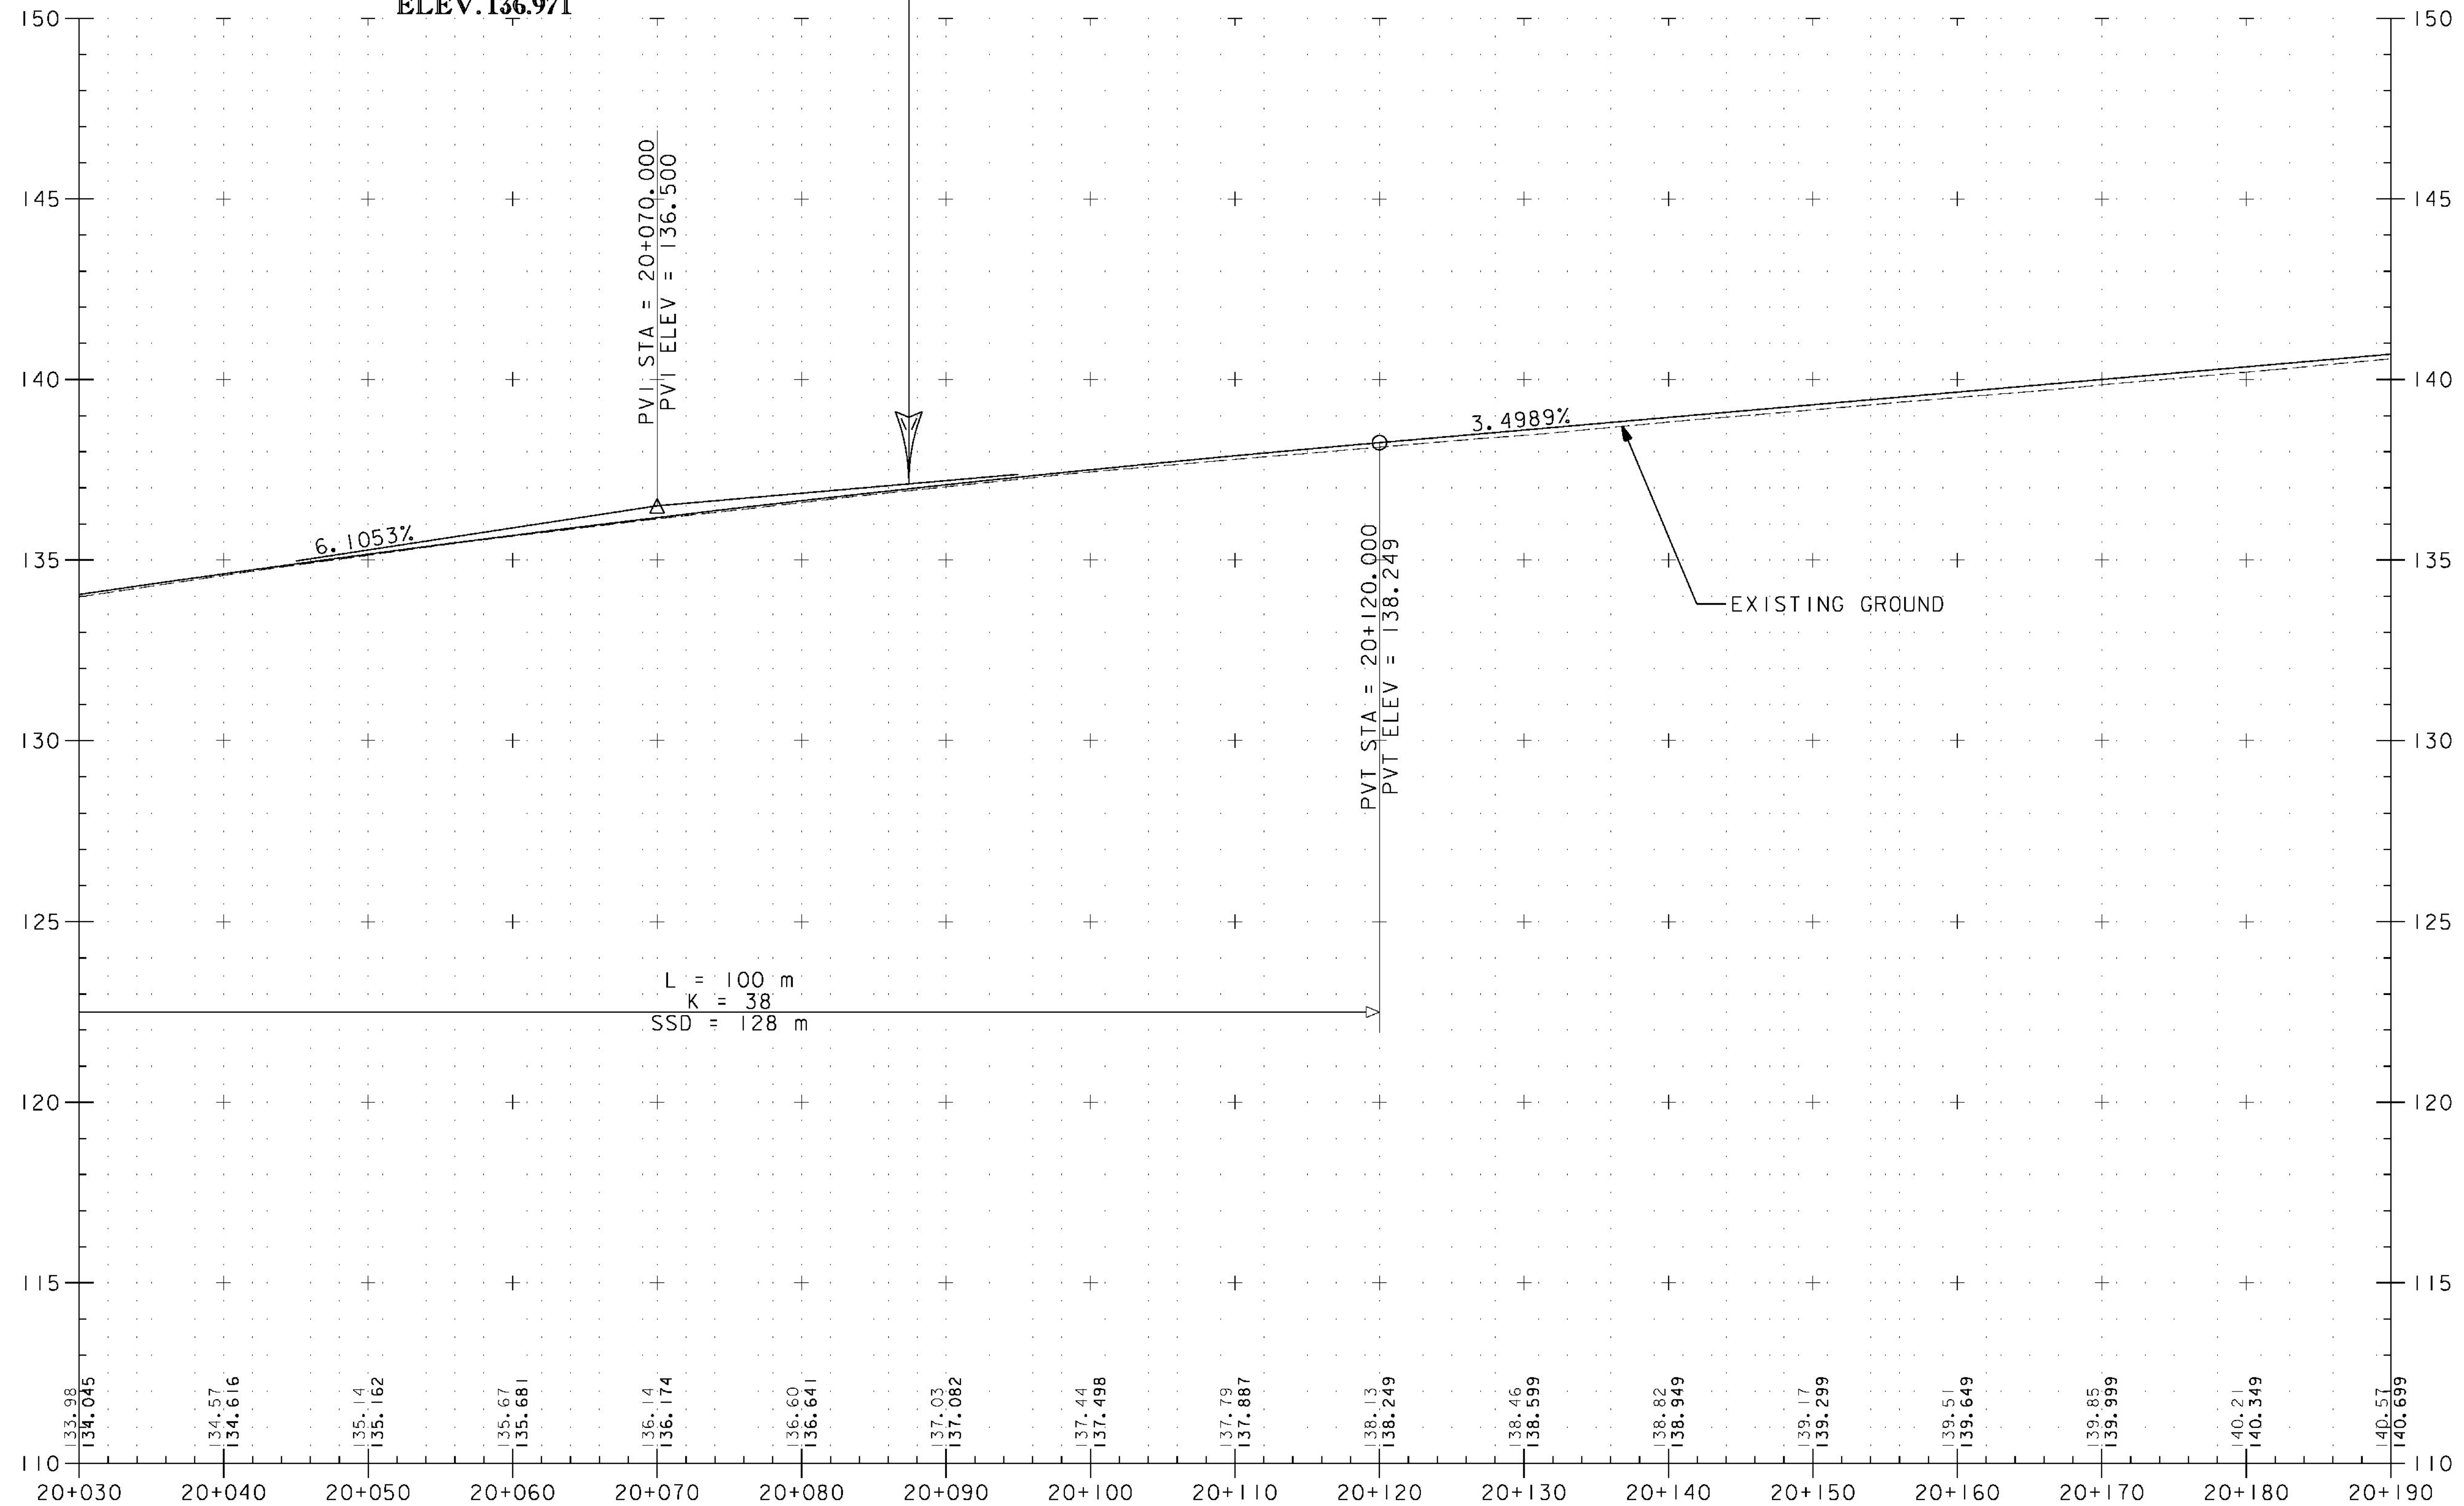

NOTE
 1. EXISTING GROUND ELEVATION IS SHOWN LIGHT.
 2. FINISH GRADE ELEVATION IS SHOWN IN BOLD.

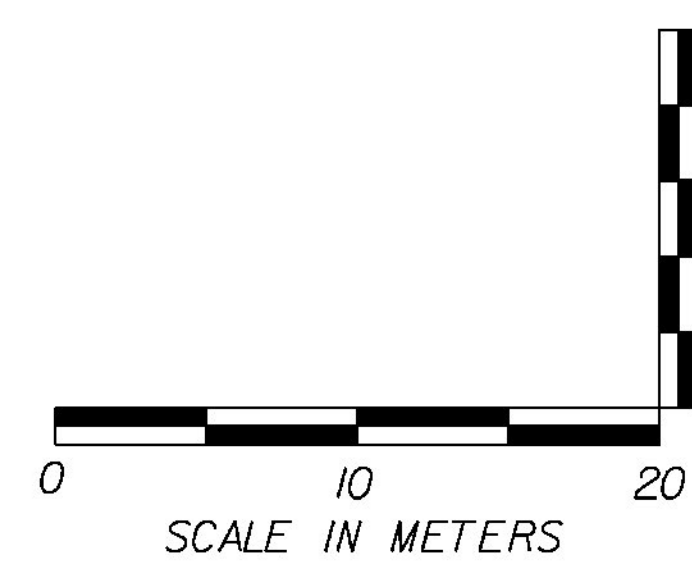

US 7 PROFILE 24	
PROJECT NAME:	BRANDON
PROJECT NUMBER:	NH 019-3(495)
FILE NAME:	zb008s5-pro24.dgn
PROJECT LEADER:	CRB
DESIGNED BY:	DAM
CLD 02-0149	
PLOT DATE:	9/3/2009
DRAWN BY:	NLL
CHECKED BY:	PTS
SHEET	115 OF 546