

CONSTRUCT DRIVES

STA 20+270.0 LT - 6.0 m WIDE, GRAVEL-RES.
 STA 20+296.5 LT - 12.0 m WIDE, PAVED-COMM.
 STA 20+334.9 LT - 12.0 m WIDE, PAVED-COMM.


GRANITE SLOPE EDGING (100mm)

~~VERTICAL GRANITE CURB~~
 STA 20+281.7 - 20+290.5 LT
 STA 20+302.5 - 20+329.0 LT (ISLAND)
 STA 20+341.0 - 20+350.0 LT


REMOVAL OF EXISTING FENCE

STA 20+248.0 - 20+337.8 LT

EXCAVATION OF SURFACES AND PAVEMENTS (PLACE 100mm TOPSOIL, SEED, FERTILIZER, LIMESTONE AND HAY MULCH)
 STA 20+245.2 - 20+266.3 LT

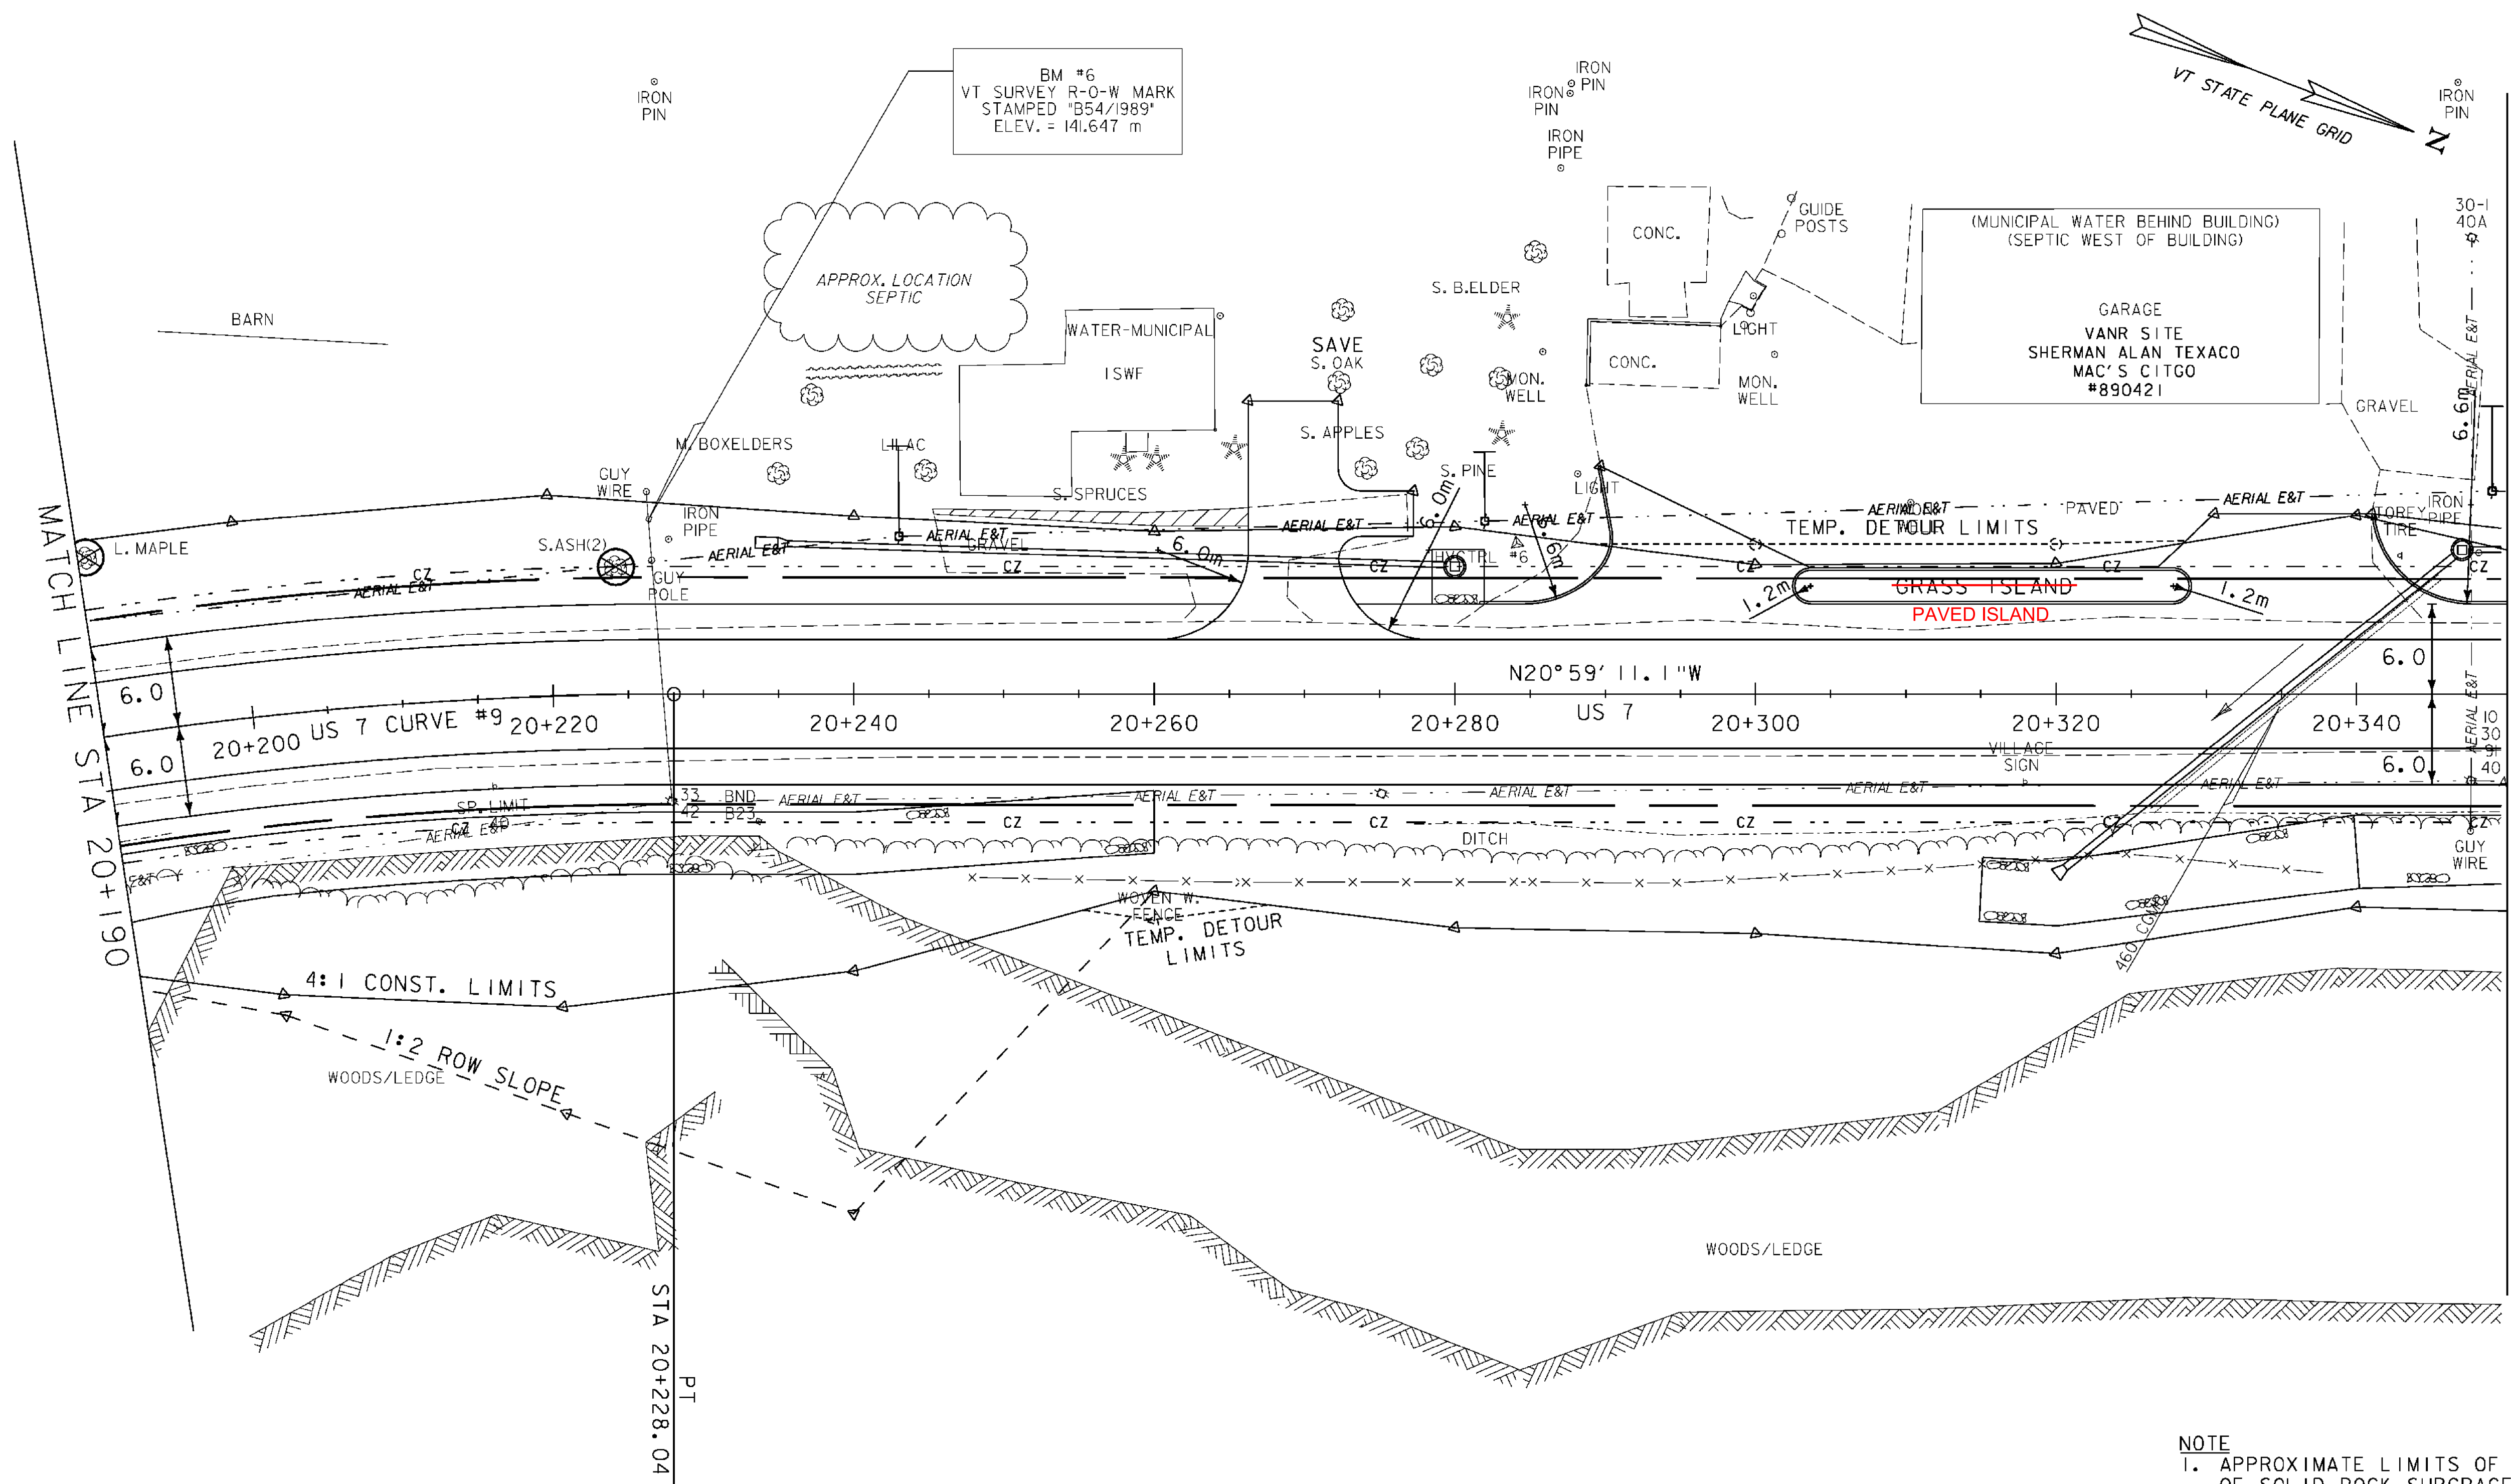

NOTE
 1. APPROXIMATE LIMITS OF DRILLING AND BLASTING OF SOLID ROCK SUBGRADE FROM STA 19+780 TO STA 20+760.

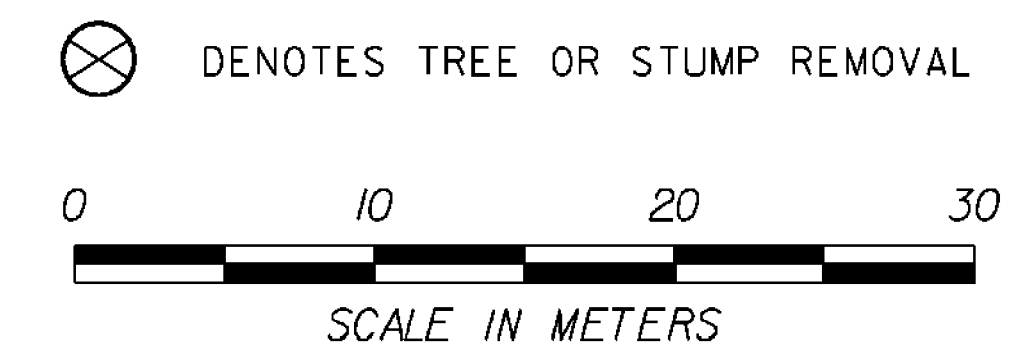

ROADWAY LAYOUT 25	
PROJECT NAME:	BRANDON
PROJECT NUMBER:	NH 019-3(495)
FILE NAME:	zb008s5-gen25.dgn
PROJECT LEADER:	CRB
DESIGNED BY:	DAM
CLD 02-0149	
PLOT DATE:	9/3/2009
DRAWN BY:	NLL
CHECKED BY:	PTS
SHEET	116 OF 546