
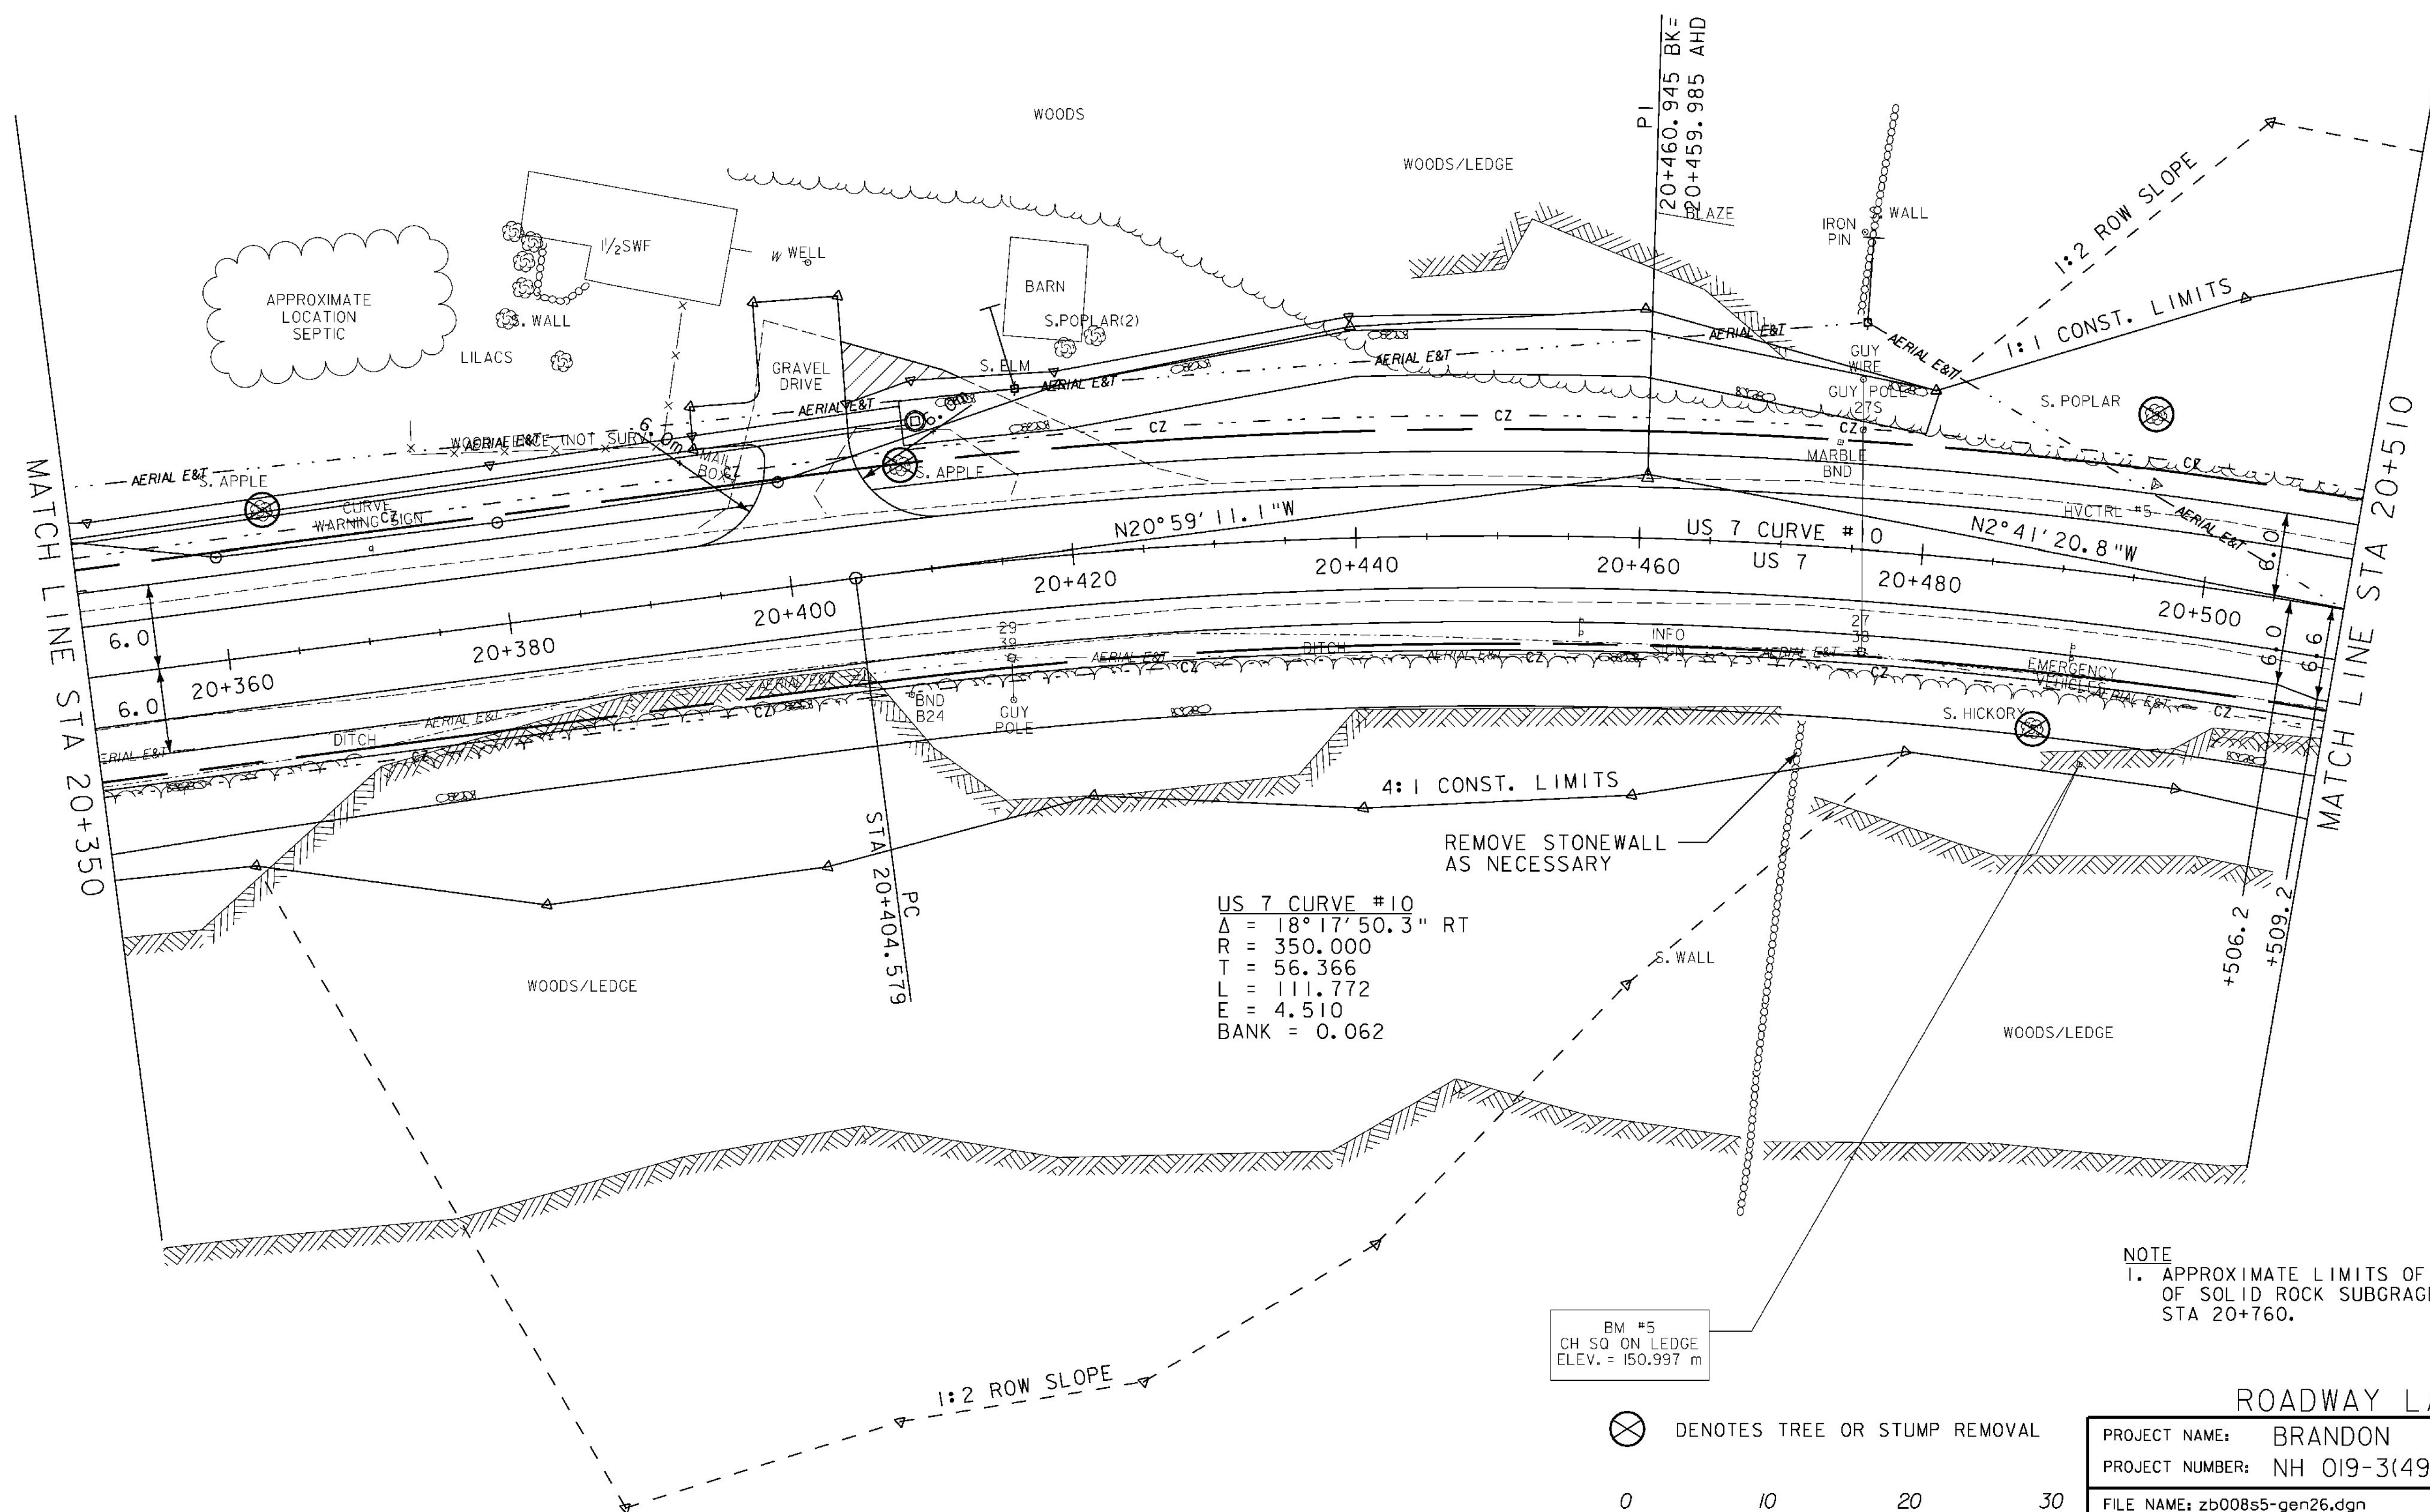


**CONSTRUCT DRIVES**  
 STA 20+403.0 LT - 6.0 m WIDE, GRAVEL-RES.  
**VERTICAL GRANITE CURB**  
 STA 20+350.0 - 20+350.6 LT  
**RELOCATE MAIL BOX, SINGLE SUPPORT**  
 STA 20+396.4 LT  
**REMOVING AND RESETTING FENCE**  
 STA 20+388.2 - 20+392.4 LT

EXCAVATION OF SURFACES AND PAVEMENTS (PLACE 100mm TOPSOIL, SEED, FERTILIZER, LIMESTONE AND HAY MULCH)  
 STA 20+405.4 - 20+413.3 LT

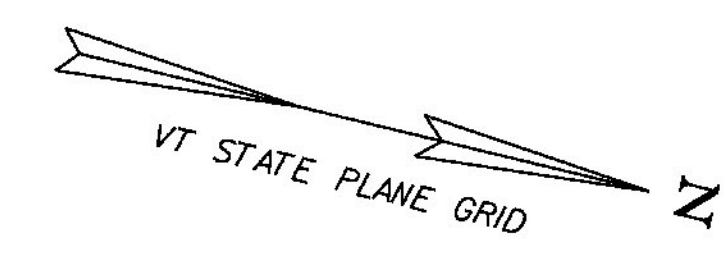

**NOTE**  
 1. APPROXIMATE LIMITS OF DRILLING AND BLASTING OF SOLID ROCK SUBGRAGE FROM STA 19+780 TO STA 20+760.

BM #5  
 CH SQ ON LEDGE  
 ELEV. = 150.997 m

DENOTES TREE OR STUMP REMOVAL



**ROADWAY LAYOUT 26**

PROJECT NAME:	BRANDON	PLOT DATE:	9/3/2009
PROJECT NUMBER:	NH 019-3(495)	DRAWN BY:	NLL
FILE NAME:	zb008s5-gen26.dgn	CHECKED BY:	PTS
PROJECT LEADER:	CRB	CLD 02-0149	SHEET 118 OF 546
DESIGNED BY:	DAM		