


NOTE
1. EXISTING GROUND ELEVATION IS SHOWN LIGHT.
2. FINISH GRADE ELEVATION IS SHOWN IN BOLD.

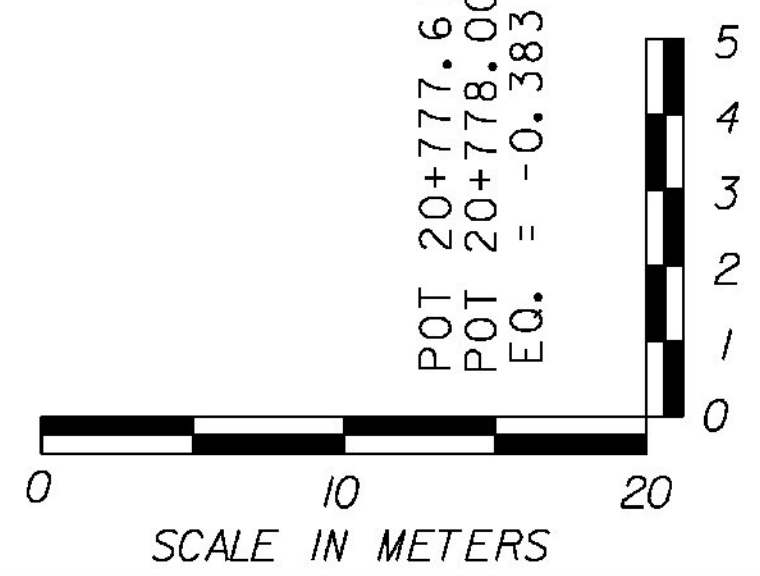

US 7 PROFILE 28

PROJECT NAME:	BRANDON	PLOT DATE:	9/3/2009
PROJECT NUMBER:	NH 019-3(495)	DRAWN BY:	NLL
FILE NAME:	zb008s5-pro28.dgn	CHECKED BY:	PTS
PROJECT LEADER:	CRB	SHEET	123 OF 546
DESIGNED BY:	DAM		
CLD 02-0149			