


NOTE
 1. EXISTING GROUND ELEVATION IS SHOWN LIGHT.
 2. FINISH GRADE ELEVATION IS SHOWN IN BOLD.

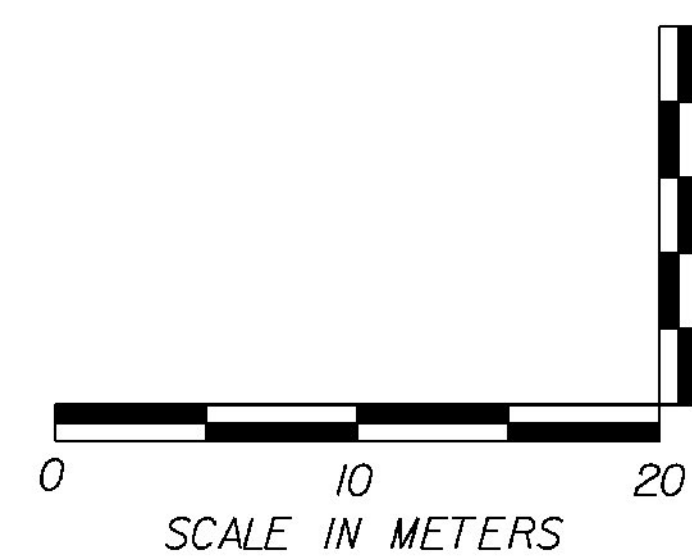

NICKERSON ROAD PROFILE

PROJECT NAME: BRANDON	PLOT DATE: 9/3/2009
PROJECT NUMBER: NH 019-3(495)	DRAWN BY: NLL
FILE NAME: zb008s5-pro30.dgn	CHECKED BY: PTS
PROJECT LEADER: CRB	SHEET 125 OF 546
DESIGNED BY: DAM	