



McCONNELL ROAD

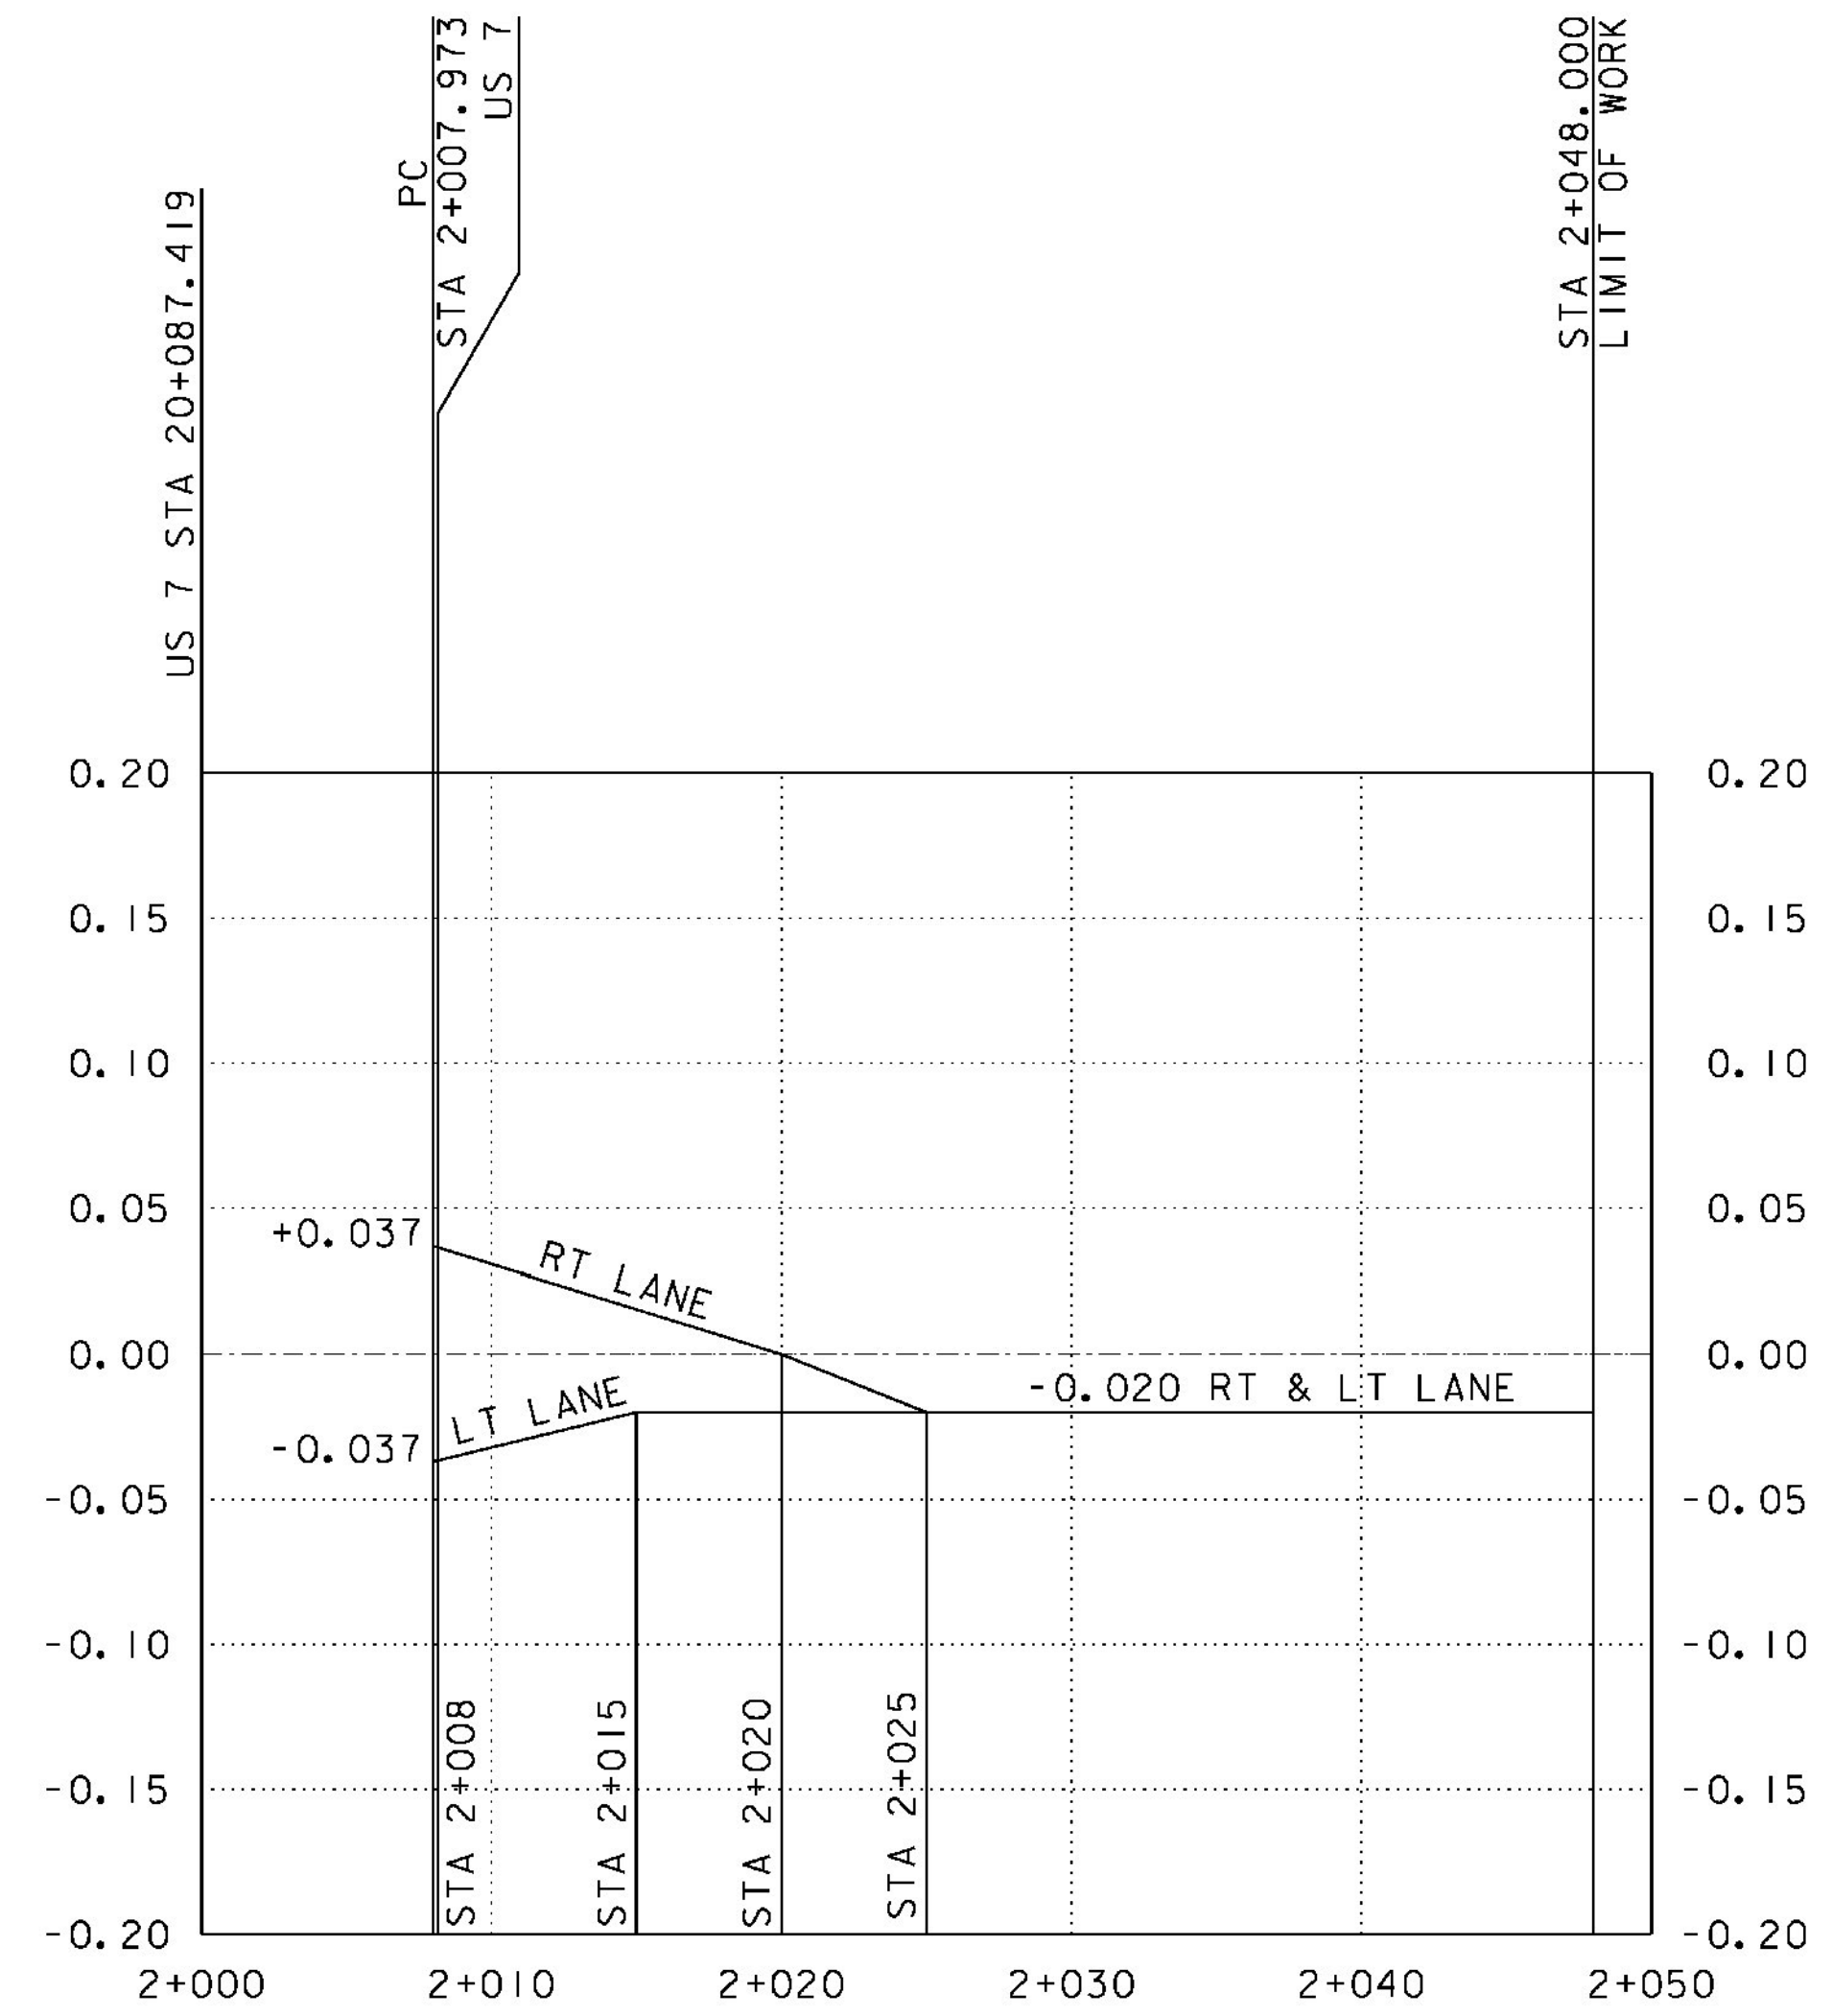

NICKERSON ROAD

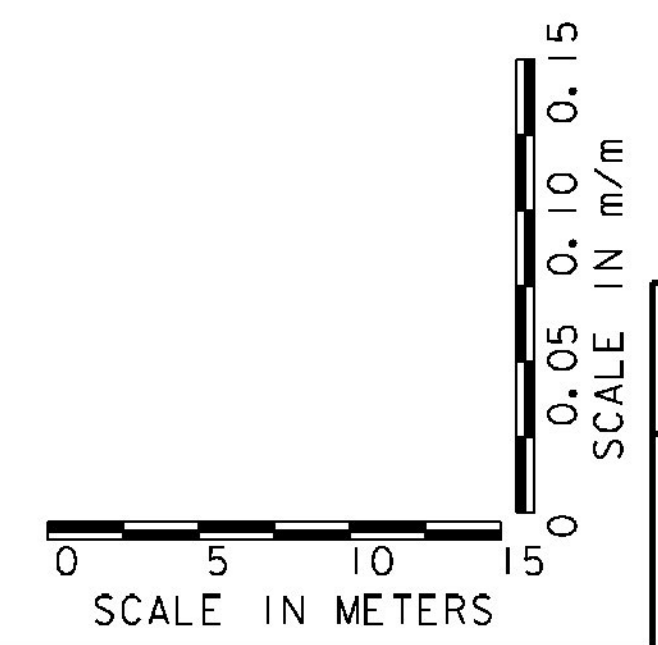

BANKING DIAGRAM 5

PROJECT NAME: BRANDON	PLOT DATE: 9/3/2009
PROJECT NUMBER: NH 019-3(495)	DRAWN BY: HJC
FILE NAME: zb008s5-frml0.dgn	CHECKED BY: PTS
PROJECT LEADER: CRB	SHEET 131 OF 546
DESIGNED BY: DAM	
CLD 02-0149	