





SYSTEM A
US 7 STA 20+730 TO 20+882 20+807.2

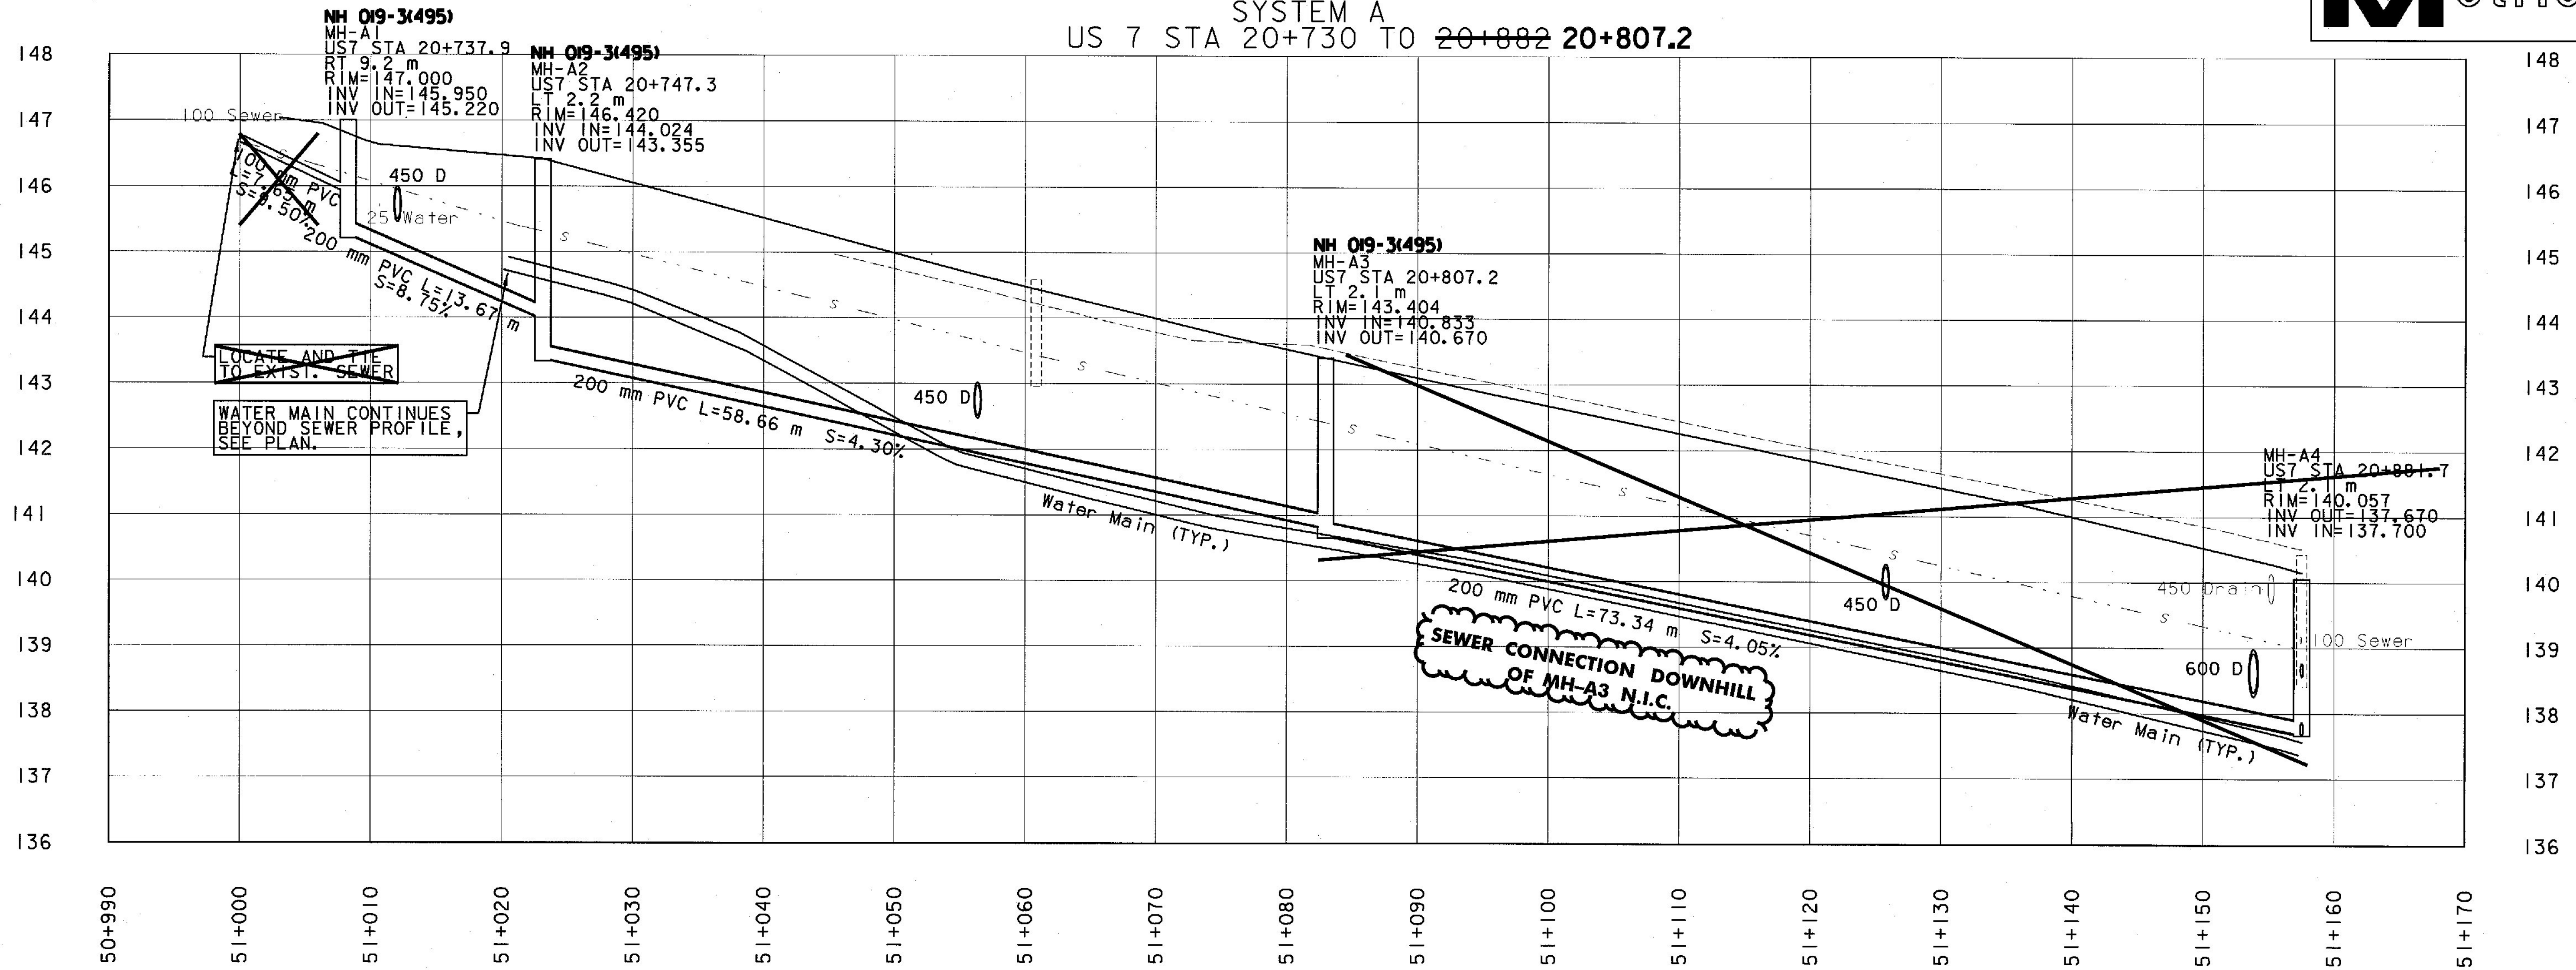

SYSTEM A continued

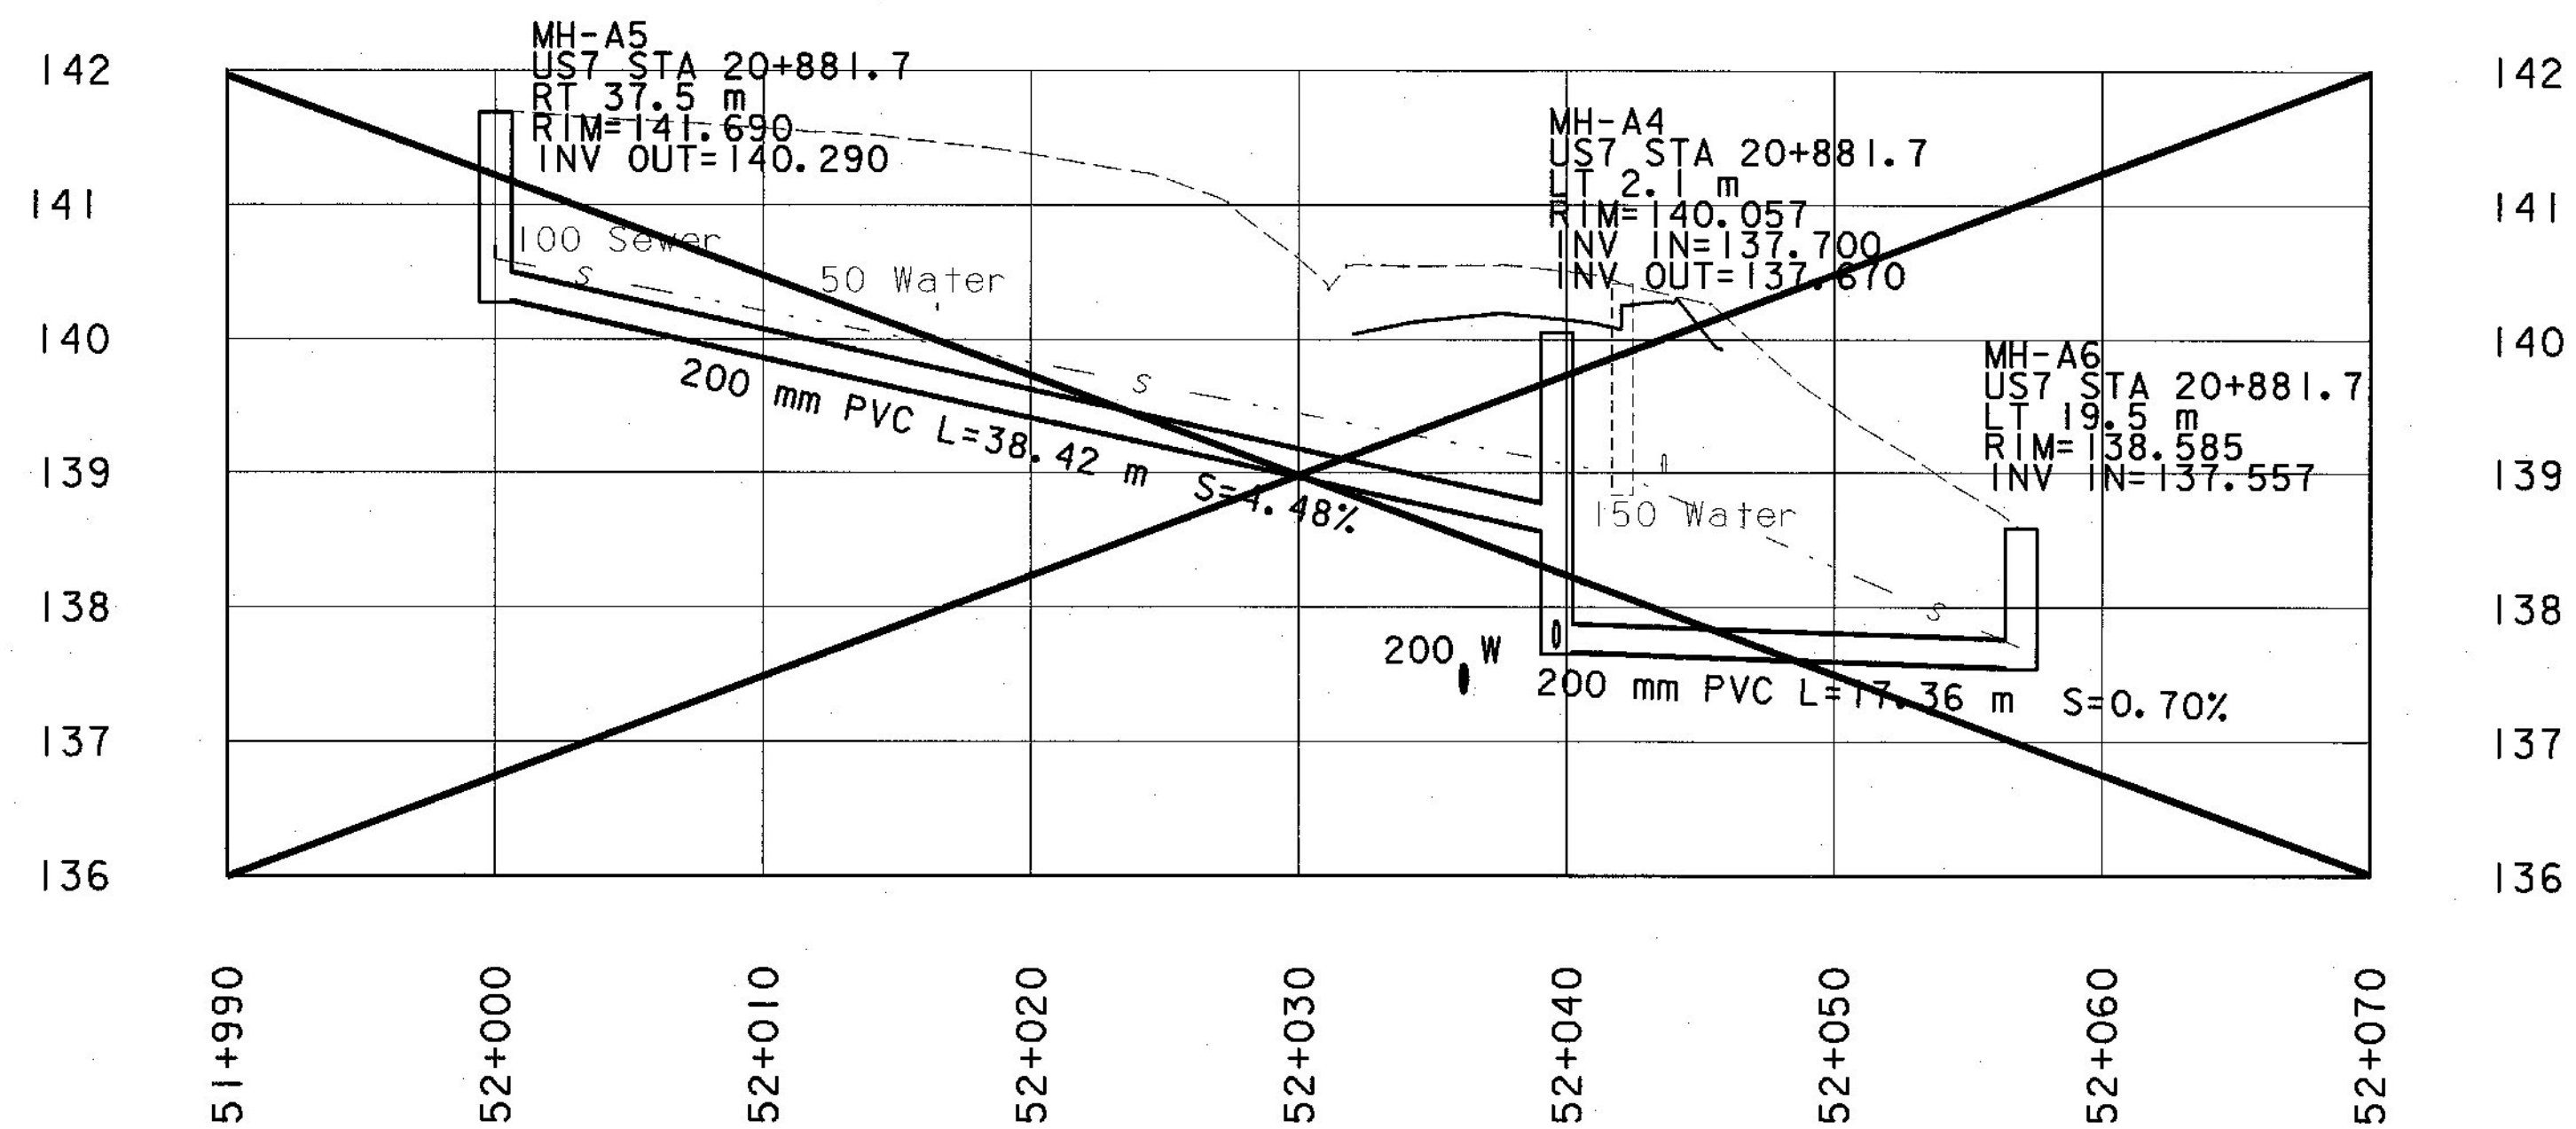

THE PROPOSED WATER MAIN AND EXISTING SEWER LINES HAVE BEEN PROJECTED ON THE PROPOSED SEWER PROFILES. THE PROPOSED WATER MAIN ELEVATIONS SHALL BE ADJUSTED TO AVOID OTHER UNDERGROUND FEATURES, AS NEEDED. SEE PLANS, PROFILES, DETAILS, AND ROADWAY CROSS SECTIONS FOR LOCATIONS OF OTHER UNDERGROUND FEATURES.

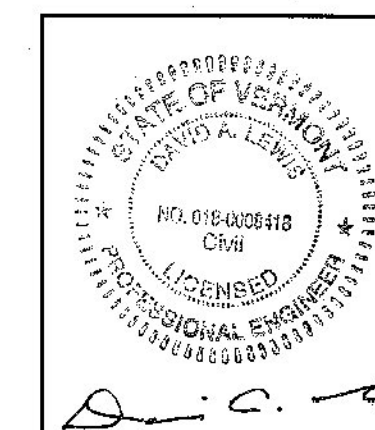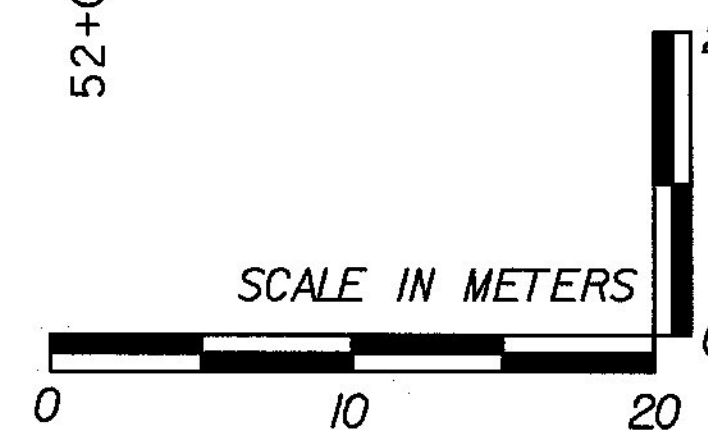

3	AUG. 2009	MODIFIED TO ADDRESS CONTRACT ADMINISTRATIONS COMMENTS
1	MAR. 2009	BRANDON SEGMENT 5 PLAN REVISIONS
SEWER PROFILE 1		
PROJECT NAME: BRANDON		
PROJECT NUMBER: NH 019-3(496)		
FILE NAME: zb008s6-swrpro.dgn	PLOT DATE: 1/9/2006	
PROJECT LEADER: HJM	DRAWN BY: KLS	
DESIGNED BY: DAL	CHECKED BY: DAL	
SHEET 146 OF 546	SHEET 185 OF 437	