

STONE FILL, TYPE I (IN DITCHES)  
 GEOTEXTILE UNDER STONE FILL  
 STA 16+780 - 16+812 RT

TEMPORARY STONE CHECK DAM, TYPE I  
 STA 16+760 RT  
 STA 16+840 RT  
 STA 16+830 - 16+850 LT


TEMPORARY EROSION MATTING (IN DITCHES)  
 STA 16+830 - 16+850 LT

INLET PROTECTION DEVICE, TYPE I  
 STA 16+724 RT

GEOTEXTILE FOR SILT FENCE  
 STA 16+690 - 16+770 LT  
 STA 16+780 - 16+832 LT (5)

PROJECT DEMARCATION FENCE  
 STA 16+690 - 16+727 RT  
 STA 16+690 - 16+772 LT  
 STA 16+820 - 16+850 LT  
 STA 16+840 - 16+850 RT

BARRIER FENCE  
 STA 16+733 - 16+840 RT  
 STA 16+778 - 16+795 LT  
 STA 16+805 - 16+820 LT

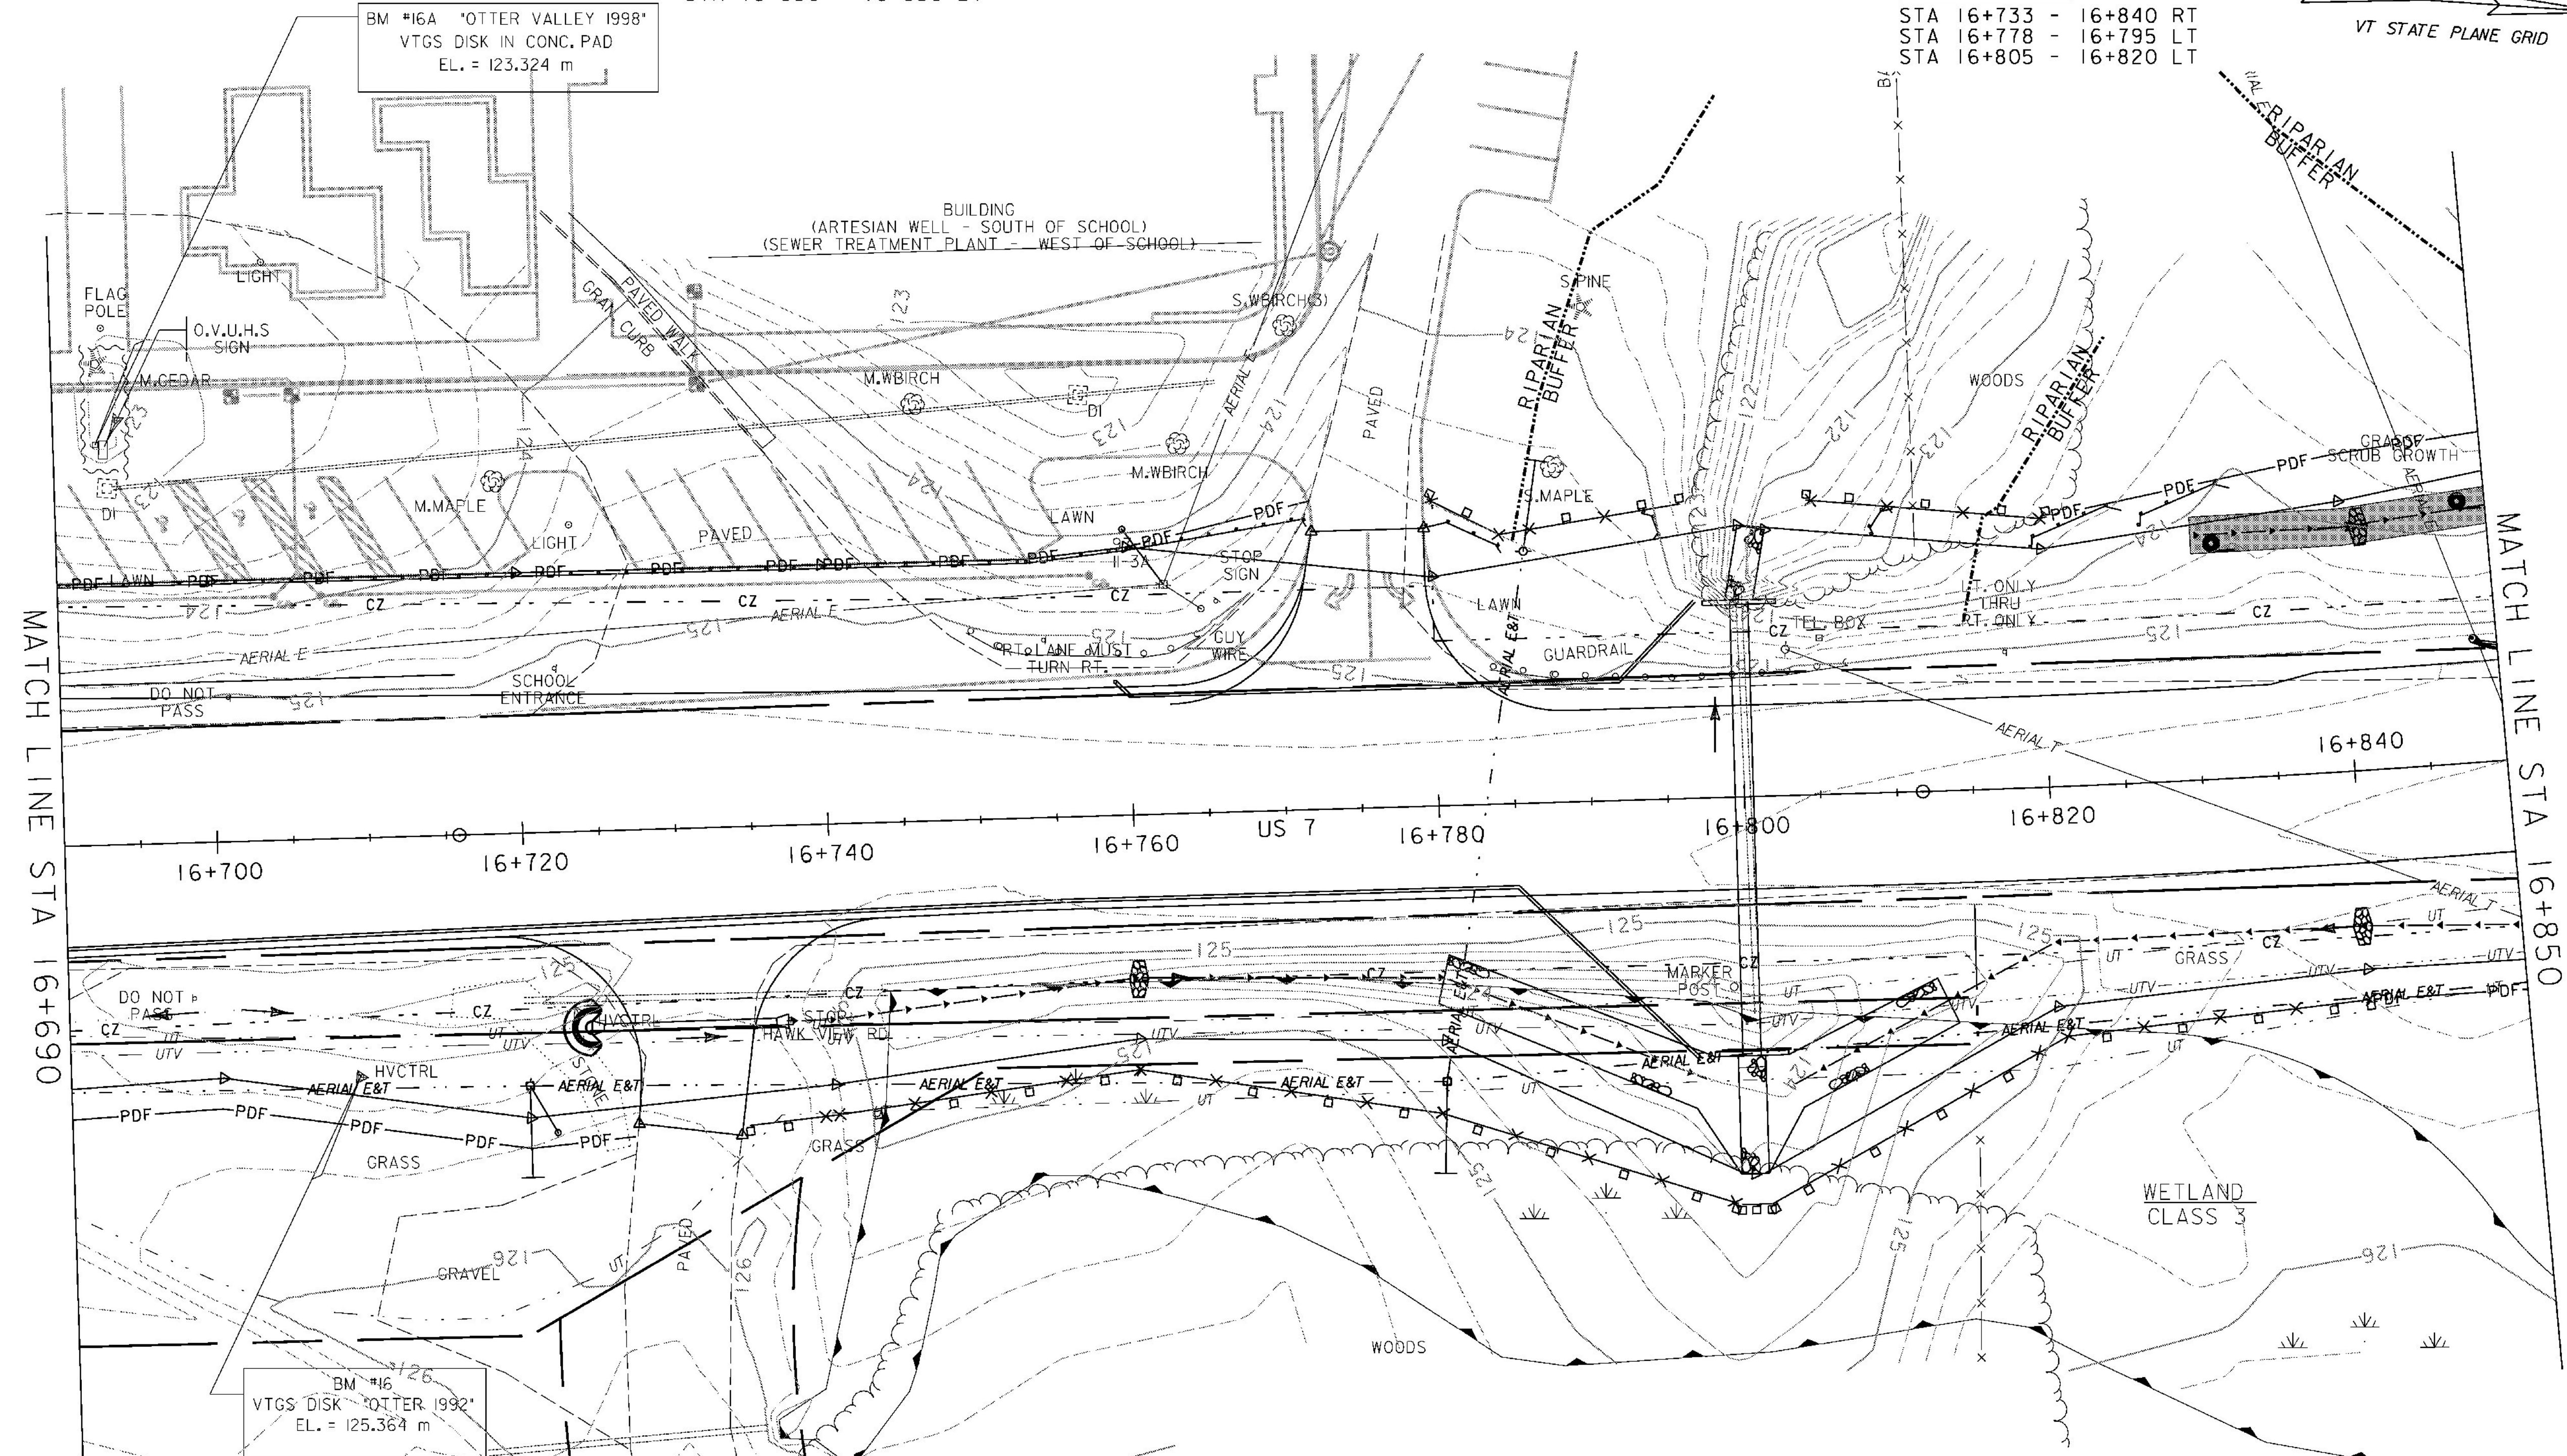

MATCH LINE STA 16+690

MATCH LINE STA 16+850

LEGEND	
	ROADSIDE DITCH/SLOPE PROTECTION
	DETOUR SLOPE LIMITS
	PERMANENT SLOPE LIMITS
	SILT FENCE
	INLET PROTECTION DEVICE, TYPE I
	PIPE INLET PROTECTION
	EROSION MATTING
	CHECK DAM - TEMPORARY
	BARRIER FENCE
	PROJECT DEMARCATION FENCE
	FILTER CURTAIN

**NOTES:**

- SILT FENCE LOCATIONS SHOWN ON THIS DRAWING ARE APPROXIMATE. THE CONTRACTOR IS RESPONSIBLE FOR INSTALLING THE SILT FENCE IN ACCORDANCE WITH THE GUIDELINES SET FORTH IN THE VERMONT GENERAL PERMIT FOR STORMWATER RUNOFF FROM CONSTRUCTION SITES. THE RESIDENT ENGINEER AND ON SITE COORDINATOR SHALL APPROVE ALL SILT FENCE LOCATIONS PRIOR TO PLACEMENT.
- FOR EROSION PREVENTION AND SEDIMENT CONTROL PLAN GENERAL NOTES, SEE SHEETS 147 - 148, AND DETAILS, SEE SHEETS 177 - 180.

**EROSION CONTROL PLAN 3**

PROJECT NAME: BRANDON	PLOT DATE: 9/3/2009
PROJECT NUMBER: NH 019-3(495)	DRAWN BY: NLL
FILE NAME: zb008s5-ec03.dgn	CHECKED BY: PTS
PROJECT LEADER: CRB	SHEET 151 OF 546
DESIGNED BY: NLL	
CLD 02-0149	

