

STONE FILL, TYPE II (IN DITCHES)
 GEOTEXTILE UNDER STONE FILL
 STA 17+005 - 17+010 LT
 TEMPORARY STONE CHECK DAM, TYPE I
 STA 16+850 - 16+880 LT



TEMPORARY EROSION MATTING (IN DITCHES)
 STA 16+850 - 16+900 LT
 TEMPORARY EROSION MATTING (ON SLOPES)
 STA 16+880 - 17+010 LT

PROJECT DEMARCATION FENCE
 STA 16+850 - 16+860 LT
 STA 16+850 - 16+890 RT
 STA 16+910 - 16+958 RT
 STA 16+963 - 17+010 RT
 STA 17+002 - 17+010 LT

INLET PROTECTION DEVICE, TYPE I
 STA 17+008 RT
 SPECIAL PROVISION (PERMANENT)
 STONE CHECK DAM, TYPE I
 STA 16+880 LT
 STA 16+900 LT

GEOTEXTILE FOR SILT FENCE
 STA 16+891 - 16+943 RT (4)
 STA 16+910 - 17+004 LT (11)
 STA 16+965 - 16+990 RT

BARRIER FENCE
 STA 16+860 - 17+002 LT
 STA 16+890 - 16+910 RT

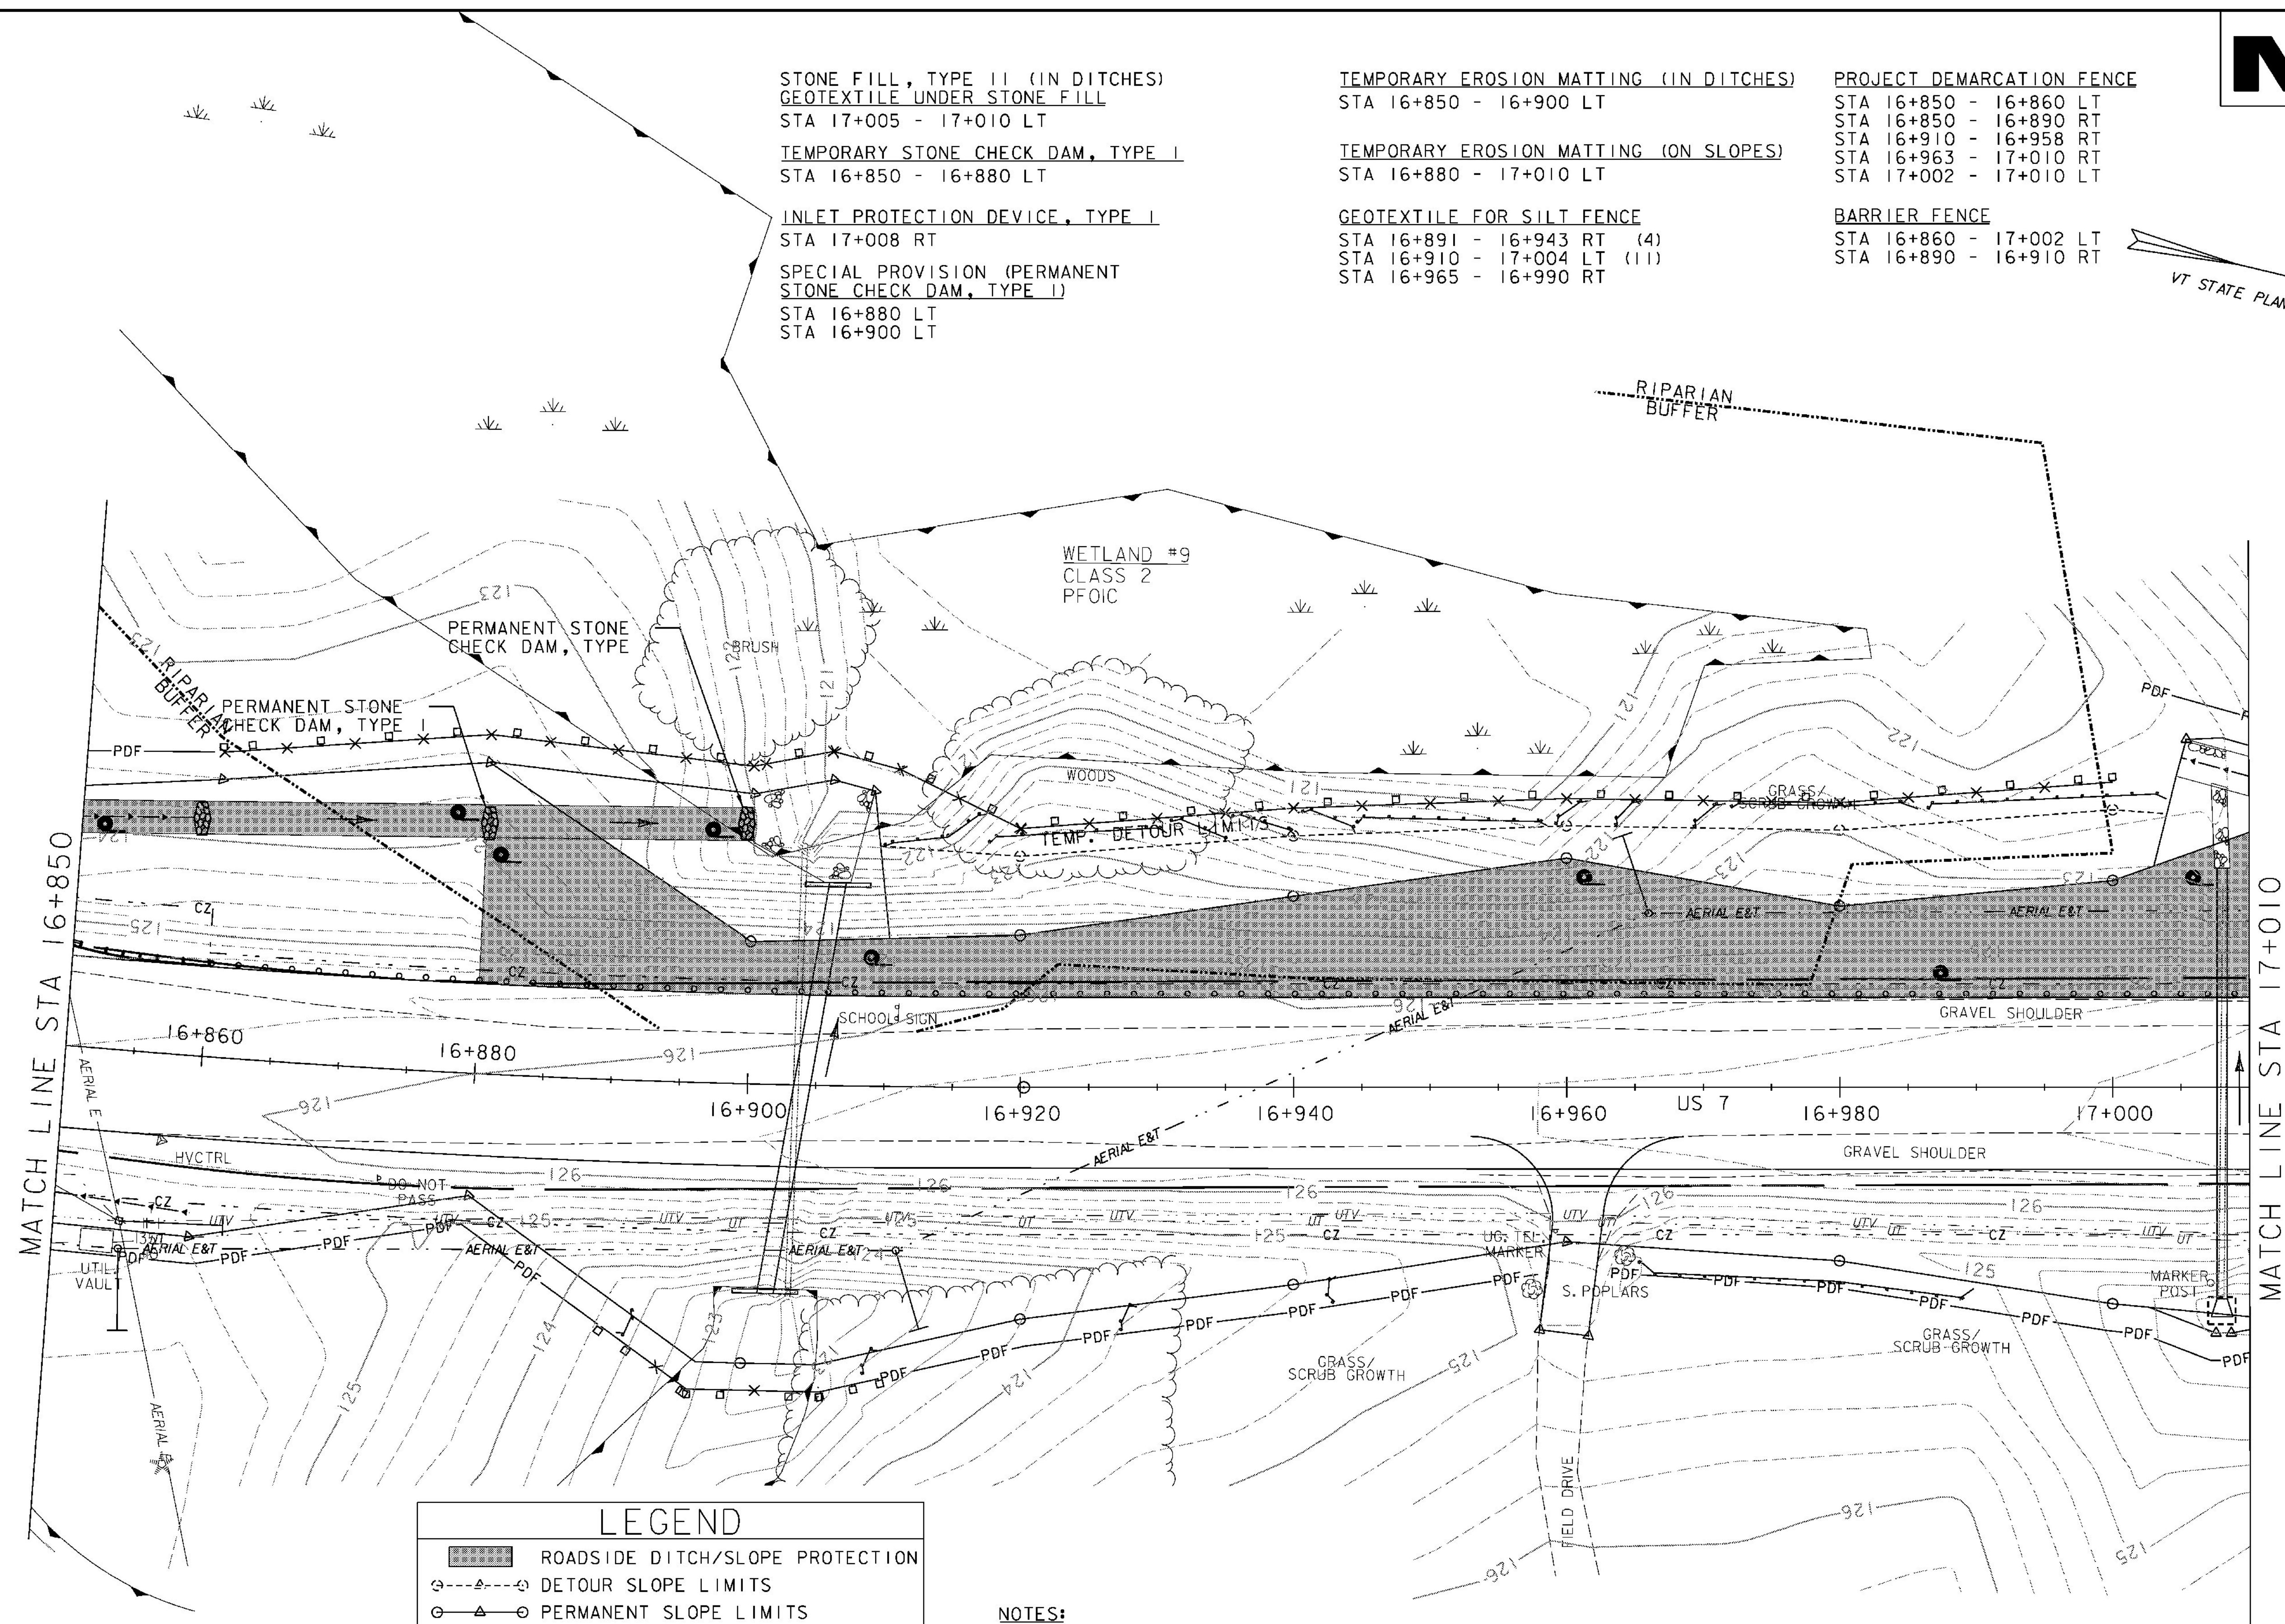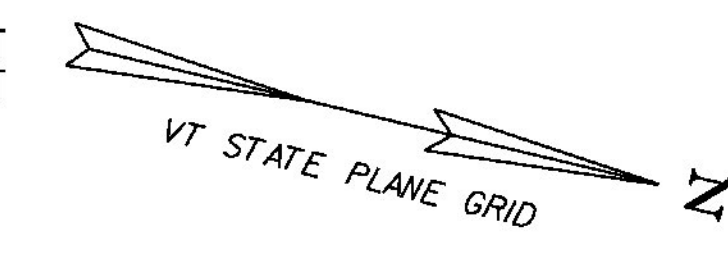

LEGEND

	ROADSIDE DITCH/SLOPE PROTECTION
	DETOUR SLOPE LIMITS
	PERMANENT SLOPE LIMITS
	SILT FENCE
	INLET PROTECTION DEVICE, TYPE I
	PIPE INLET PROTECTION
	EROSION MATTING
	CHECK DAM - TEMPORARY
	BARRIER FENCE
	PROJECT DEMARCATION FENCE
	FILTER CURTAIN

- NOTES:**
- SILT FENCE LOCATIONS SHOWN ON THIS DRAWING ARE APPROXIMATE. THE CONTRACTOR IS RESPONSIBLE FOR INSTALLING THE SILT FENCE IN ACCORDANCE WITH THE GUIDELINES SET FORTH IN THE VERMONT GENERAL PERMIT FOR STORMWATER RUNOFF FROM CONSTRUCTION SITES. THE RESIDENT ENGINEER AND ON SITE COORDINATOR SHALL APPROVE ALL SILT FENCE LOCATIONS PRIOR TO PLACEMENT.
 - FOR EROSION PREVENTION AND SEDIMENT CONTROL PLAN GENERAL NOTES, SEE SHEETS 147 - 148, AND DETAILS, SEE SHEETS 177 - 180.



EROSION CONTROL PLAN 4

PROJECT NAME: BRANDON	PLOT DATE: 9/3/2009
PROJECT NUMBER: NH 019-3(495)	DRAWN BY: NLL
FILE NAME: zb008s5-ec04.dgn	CHECKED BY: PTS
PROJECT LEADER: CRB	SHEET 152 OF 546
DESIGNED BY: NLL	
CLD 02-0149	