

TEMPORARY STONE CHECK DAM, TYPE I
 STA 18+127 - 18+161 LT
 STA 18+177 - 18+270 LT



INLET PROTECTION DEVICE, TYPE I
 STA 18+176 LT

TEMPORARY EROSION MATTING (IN DITCHES)
 STA 18+127 - 18+161 LT
 STA 18+177 - 18+270 LT

GEOTEXTILE FOR SILT FENCE
 STA 18+110 - 18+270 RT (8)

PROJECT DEMARCATION FENCE
 STA 18+110 - 18+167 LT
 STA 18+173 - 18+270 LT
 STA 18+205 - 18+270 RT

BARRIER FENCE
 STA 18+110 - 18+205 RT

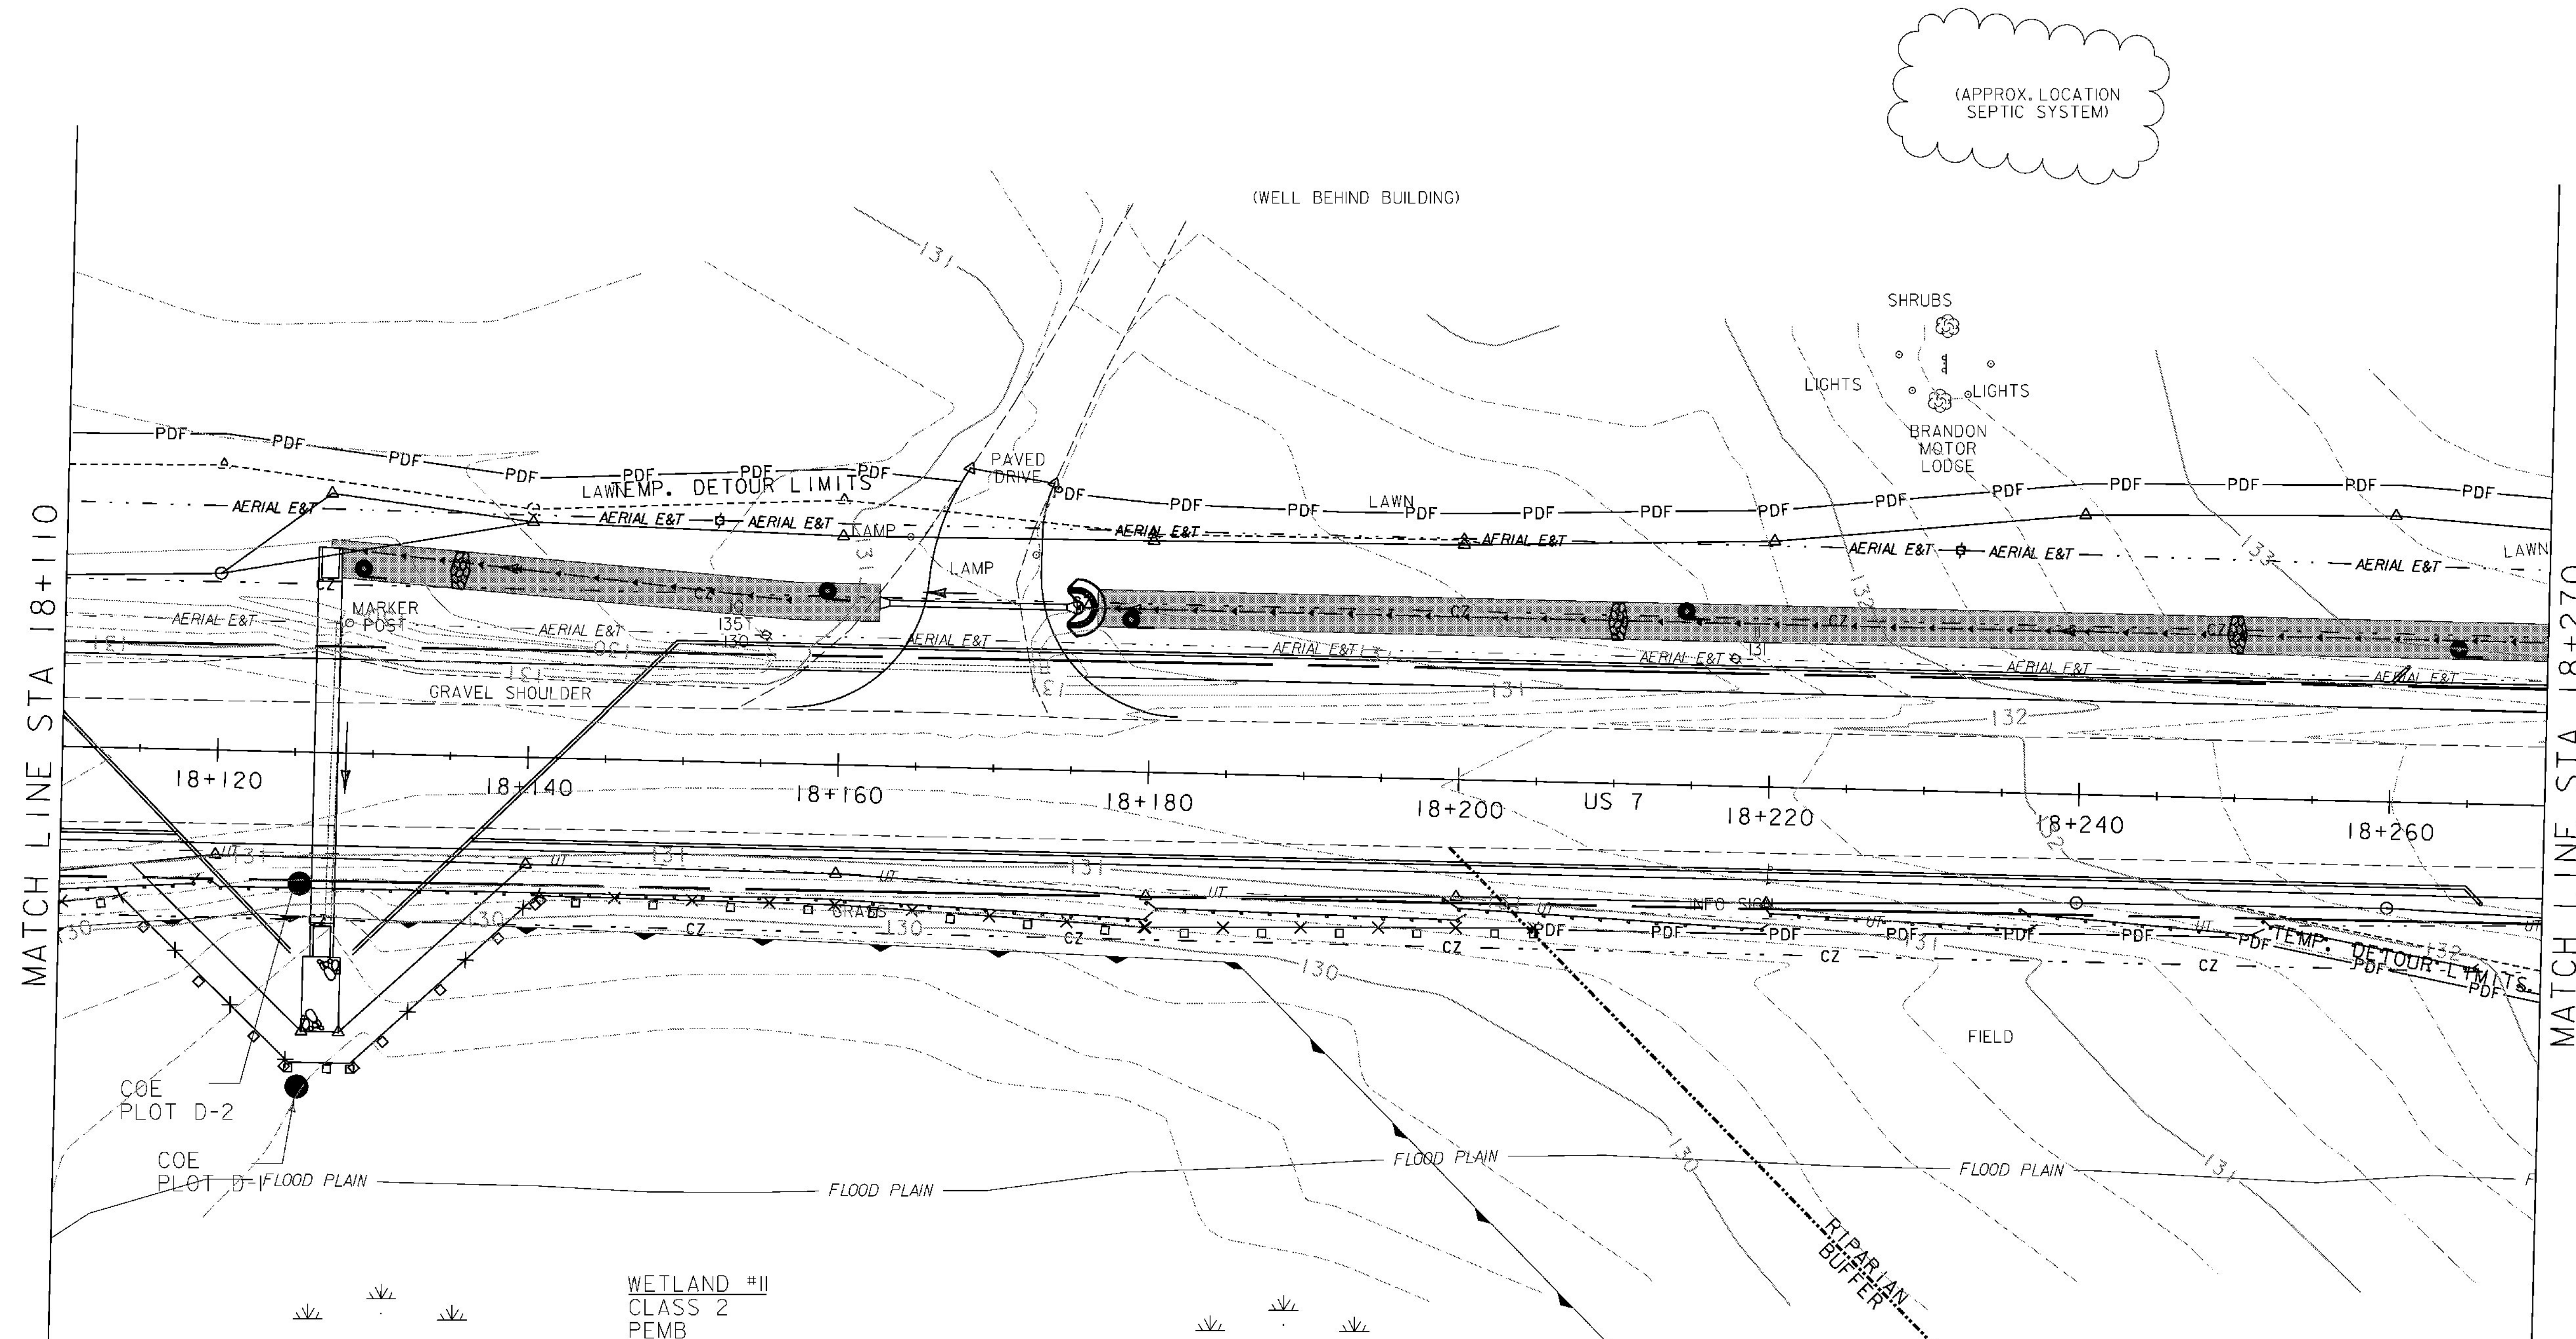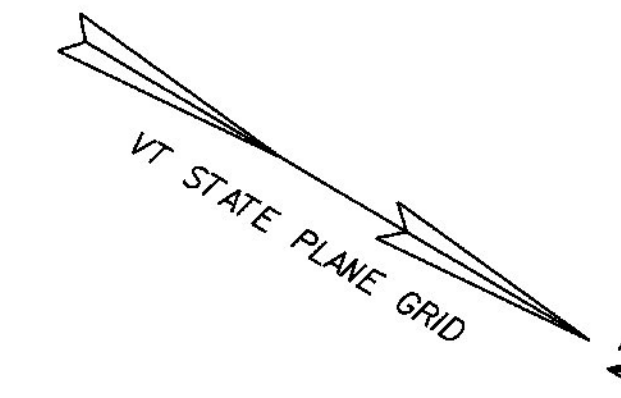

LEGEND	
	ROADSIDE DITCH/SLOPE PROTECTION
	DETOUR SLOPE LIMITS
	PERMANENT SLOPE LIMITS
	SILT FENCE
	INLET PROTECTION DEVICE, TYPE I
	PIPE INLET PROTECTION
	EROSION MATTING
	CHECK DAM - TEMPORARY
	BARRIER FENCE
	PROJECT DEMARCATION FENCE
	ONNO FILTER CURTAIN

NOTES:

- SILT FENCE LOCATIONS SHOWN ON THIS DRAWING ARE APPROXIMATE. THE CONTRACTOR IS RESPONSIBLE FOR INSTALLING THE SILT FENCE IN ACCORDANCE WITH THE GUIDELINES SET FORTH IN THE VERMONT GENERAL PERMIT FOR STORMWATER RUNOFF FROM CONSTRUCTION SITES. THE RESIDENT ENGINEER AND ON SITE COORDINATOR SHALL APPROVE ALL SILT FENCE LOCATIONS PRIOR TO PLACEMENT.
- FOR EROSION PREVENTION AND SEDIMENT CONTROL PLAN GENERAL NOTES, SEE SHEETS 147 - 148, AND DETAILS, SEE SHEETS 177 - 180.



EROSION CONTROL PLAN 12

PROJECT NAME: BRANDON	PLOT DATE: 9/3/2009
PROJECT NUMBER: NH 019-3(495)	DRAWN BY: NLL
FILE NAME: zb008s5-ec12.dgn	CHECKED BY: PTS
PROJECT LEADER: CRB	SHEET 160 OF 546
DESIGNED BY: NLL	
CLD 02-0149	