

TEMPORARY STONE CHECK DAM, TYPE 1
 STA 18+350 LT
 STA 18+360 RT

INLET PROTECTION DEVICE, TYPE 1
 STA 18+298 LT


TEMPORARY EROSION MATTING (IN DITCHES)
 STA 18+270 - 18+283 LT
 STA 18+299 - 18+380 LT
 STA 18+420 - 18+430 LT

TEMPORARY EROSION MATTING (ON SLOPES)
 STA 18+380 - 18+410 RT


GEOTEXTILE FOR SILT FENCE
 STA 18+270 - 18+336 RT (4)
 STA 18+425 - 18+427 RT

PROJECT DEMARCATION FENCE
 STA 18+270 - 18+287 LT
 STA 18+270 - 18+415 RT
 STA 18+292 - 18+430 LT

BARRIER FENCE
 STA 18+415 - 18+430 RT

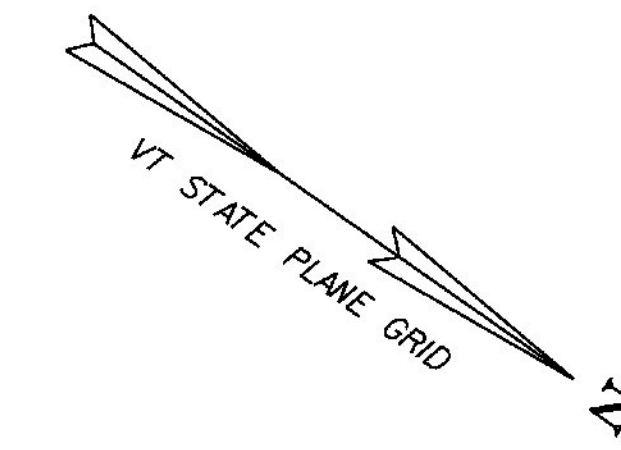

BM #12
 VT SURVEY R-O-W DISK
 STAMPED 'B64 1989'
 ELEV. = 133.788 m

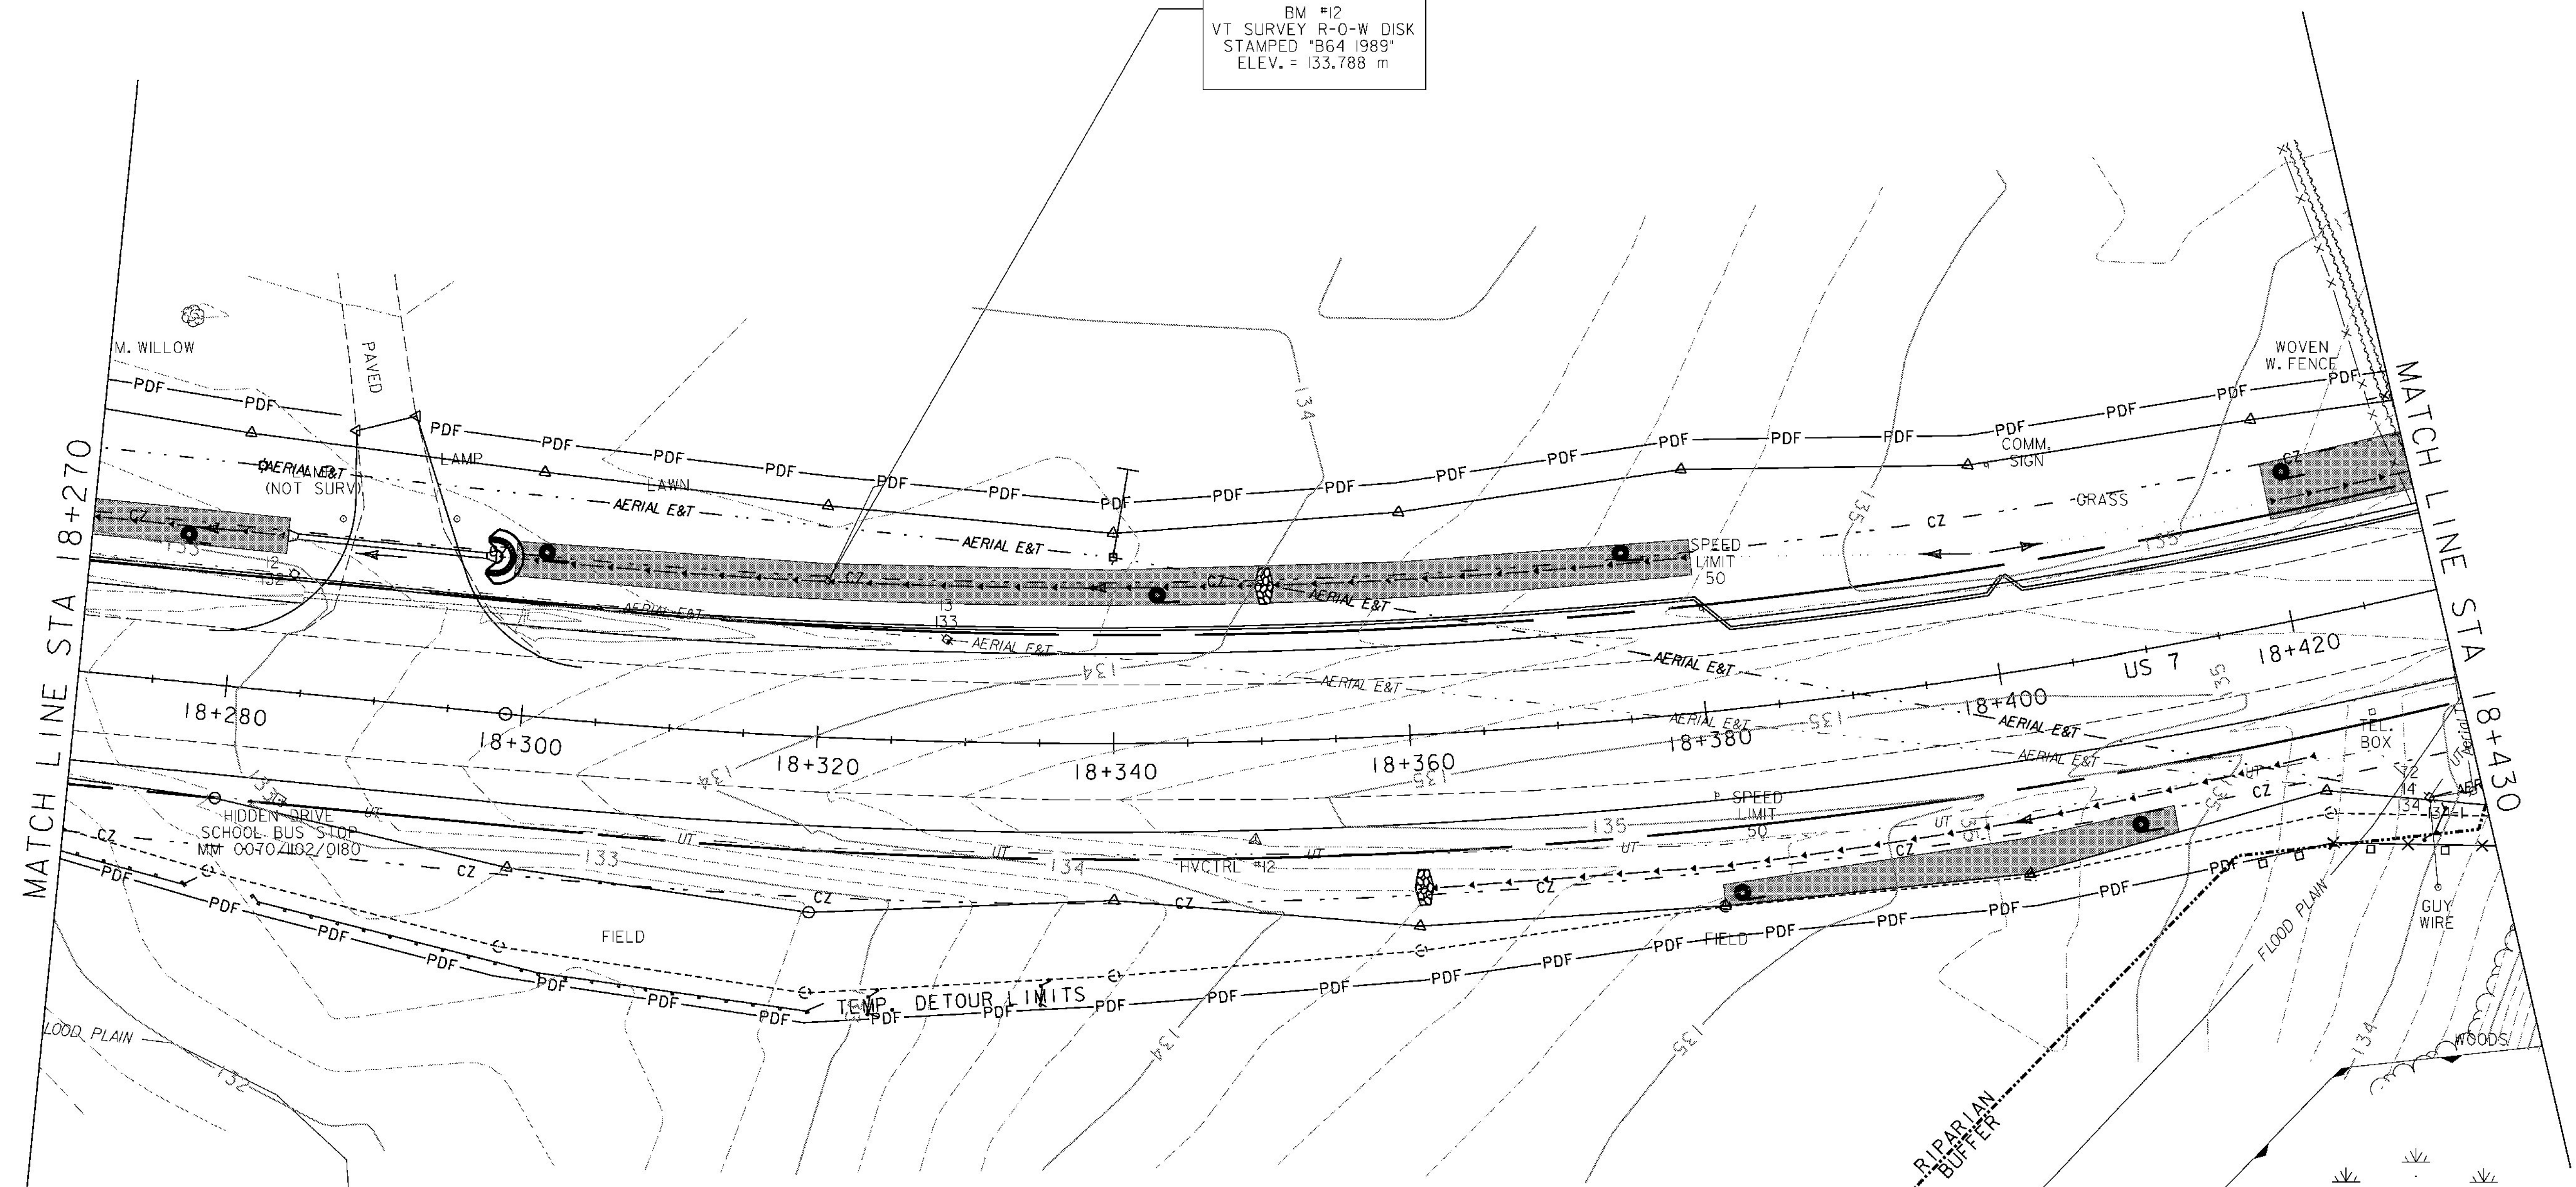

LEGEND	
	ROADSIDE DITCH/SLOPE PROTECTION
	DETOUR SLOPE LIMITS
	PERMANENT SLOPE LIMITS
	SILT FENCE
	INLET PROTECTION DEVICE, TYPE 1
	PIPE INLET PROTECTION
	EROSION MATTING
	CHECK DAM - TEMPORARY
	BARRIER FENCE
	PROJECT DEMARCATION FENCE
	FILTER CURTAIN

- NOTES:
- SILT FENCE LOCATIONS SHOWN ON THIS DRAWING ARE APPROXIMATE. THE CONTRACTOR IS RESPONSIBLE FOR INSTALLING THE SILT FENCE IN ACCORDANCE WITH THE GUIDELINES SET FORTH IN THE VERMONT GENERAL PERMIT FOR STORMWATER RUNOFF FROM CONSTRUCTION SITES. THE RESIDENT ENGINEER AND ON SITE COORDINATOR SHALL APPROVE ALL SILT FENCE LOCATIONS PRIOR TO PLACEMENT.
 - FOR EROSION PREVENTION AND SEDIMENT CONTROL PLAN GENERAL NOTES, SEE SHEETS 147 - 148, AND DETAILS, SEE SHEETS 177 - 180.

WETLAND #12
 CLASS 2
 PSSI/EMY

EROSION CONTROL PLAN 13

PROJECT NAME: BRANDON	PLOT DATE: 9/3/2009
PROJECT NUMBER: NH 019-3(495)	DRAWN BY: NLL
FILE NAME: zb008s5-ec13.dgn	CHECKED BY: PTS
PROJECT LEADER: CRB	SHEET 161 OF 546
DESIGNED BY: NLL	
CLD 02-0149	

