
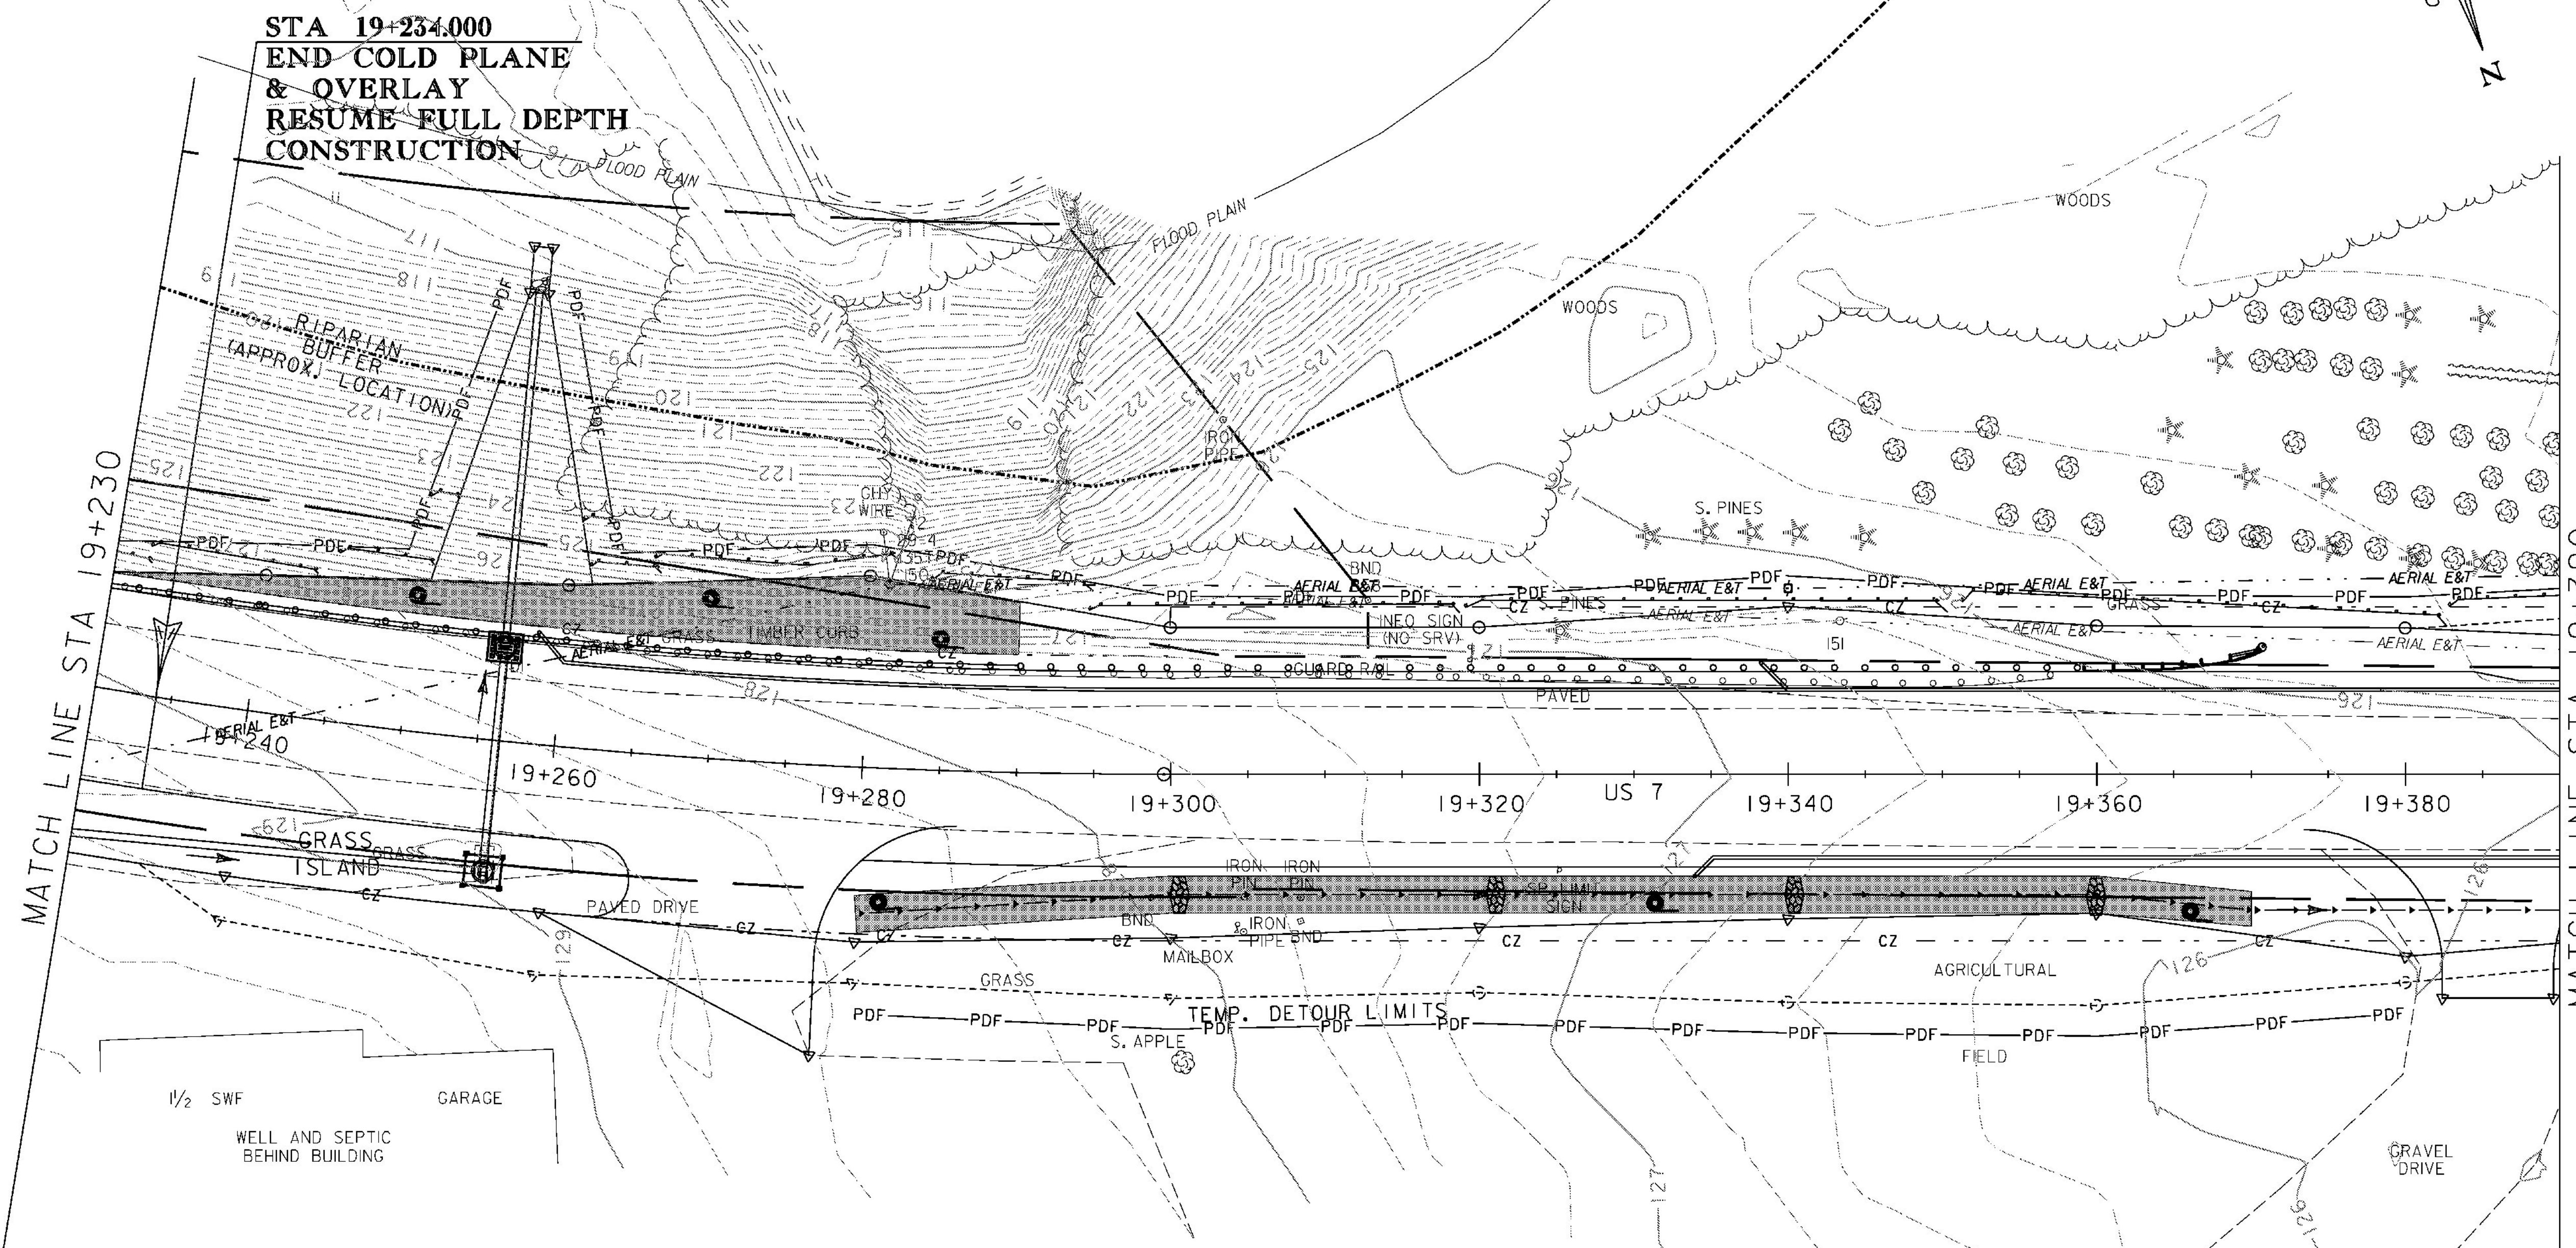


TEMPORARY STONE CHECK DAM, TYPE I  
 STA 19+280 - 19+390 RT  
 INLET PROTECTION DEVICE, TYPE I  
 STA 19+256 RT  
 STA 19+256 LT

TEMPORARY EROSION MATTING (IN DITCHES)  
 STA 19+280 - 19+370 RT  
 TEMPORARY EROSION MATTING (ON SLOPES)  
 STA 19+230 - 19+290 LT

PROJECT DEMARCATION FENCE  
 STA 19+230 - 19+254 LT  
 STA 19+258 - 19+390 LT  
 STA 19+280 - 19+380 RT

GEOTEXTILE FOR SILT FENCE  
 STA 19+230 - 19+390 LT (10)

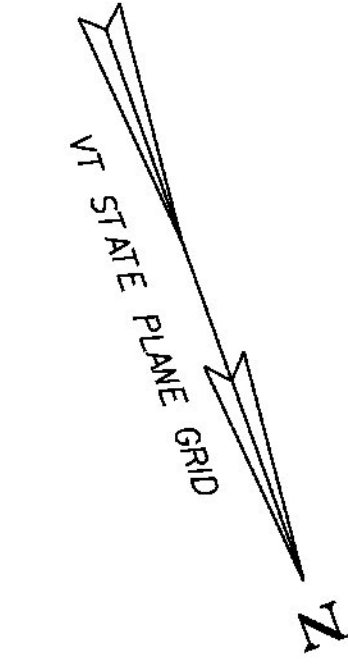

MATCH LINE STA 19+230

MATCH LINE STA 19+390

**STA 19+234.000**  
**END COLD PLANE & OVERLAY**  
**RESUME FULL DEPTH CONSTRUCTION**

LEGEND	
	ROADSIDE DITCH/SLOPE PROTECTION
	DETOUR SLOPE LIMITS
	PERMANENT SLOPE LIMITS
	SILT FENCE
	INLET PROTECTION DEVICE, TYPE I
	PIPE INLET PROTECTION
	EROSION MATTING
	CHECK DAM - TEMPORARY
	BARRIER FENCE
	PROJECT DEMARCATION FENCE
	FILTER CURTAIN

**NOTES:**

- SILT FENCE LOCATIONS SHOWN ON THIS DRAWING ARE APPROXIMATE. THE CONTRACTOR IS RESPONSIBLE FOR INSTALLING THE SILT FENCE IN ACCORDANCE WITH THE GUIDELINES SET FORTH IN THE VERMONT GENERAL PERMIT FOR STORMWATER RUNOFF FROM CONSTRUCTION SITES. THE RESIDENT ENGINEER AND ON SITE COORDINATOR SHALL APPROVE ALL SILT FENCE LOCATIONS PRIOR TO PLACEMENT.
- FOR EROSION PREVENTION AND SEDIMENT CONTROL PLAN GENERAL NOTES, SEE SHEETS 147 - 148, AND DETAILS, SEE SHEETS 177 - 180.



**EROSION CONTROL PLAN 19**

PROJECT NAME: BRANDON	PLOT DATE: 9/3/2009
PROJECT NUMBER: NH 019-3(495)	DRAWN BY: NLL
FILE NAME: zb008s5-ec19.dgn	CHECKED BY: PTS
PROJECT LEADER: CRB	SHEET 167 OF 546
DESIGNED BY: NLL	
CLD 02-0149	