

STONE FILL, TYPE II (IN DITCHES)
 GEOTEXTILE UNDER STONE FILL
 STA 20+640 - 20+650 LT


STONE FILL, TYPE I (IN DITCHES)
 GEOTEXTILE UNDER STONE FILL
 STA 20+510 - 20+550 RT

TEMPORARY STONE CHECK DAM, TYPE I
 STA 20+510 - 20+640 LT

TEMPORARY EROSION MATTING (IN DITCHES)
 STA 20+510 - 20+640 LT

TEMPORARY EROSION MATTING (ON SLOPES)
 STA 20+510 - 20+530 LT
 STA 20+510 - 20+550 RT

PROJECT DEMARCATION FENCE
 STA 20+510 - 20+650 LT
 STA 20+510 - 20+575 RT
 STA 20+594 - 20+613 RT

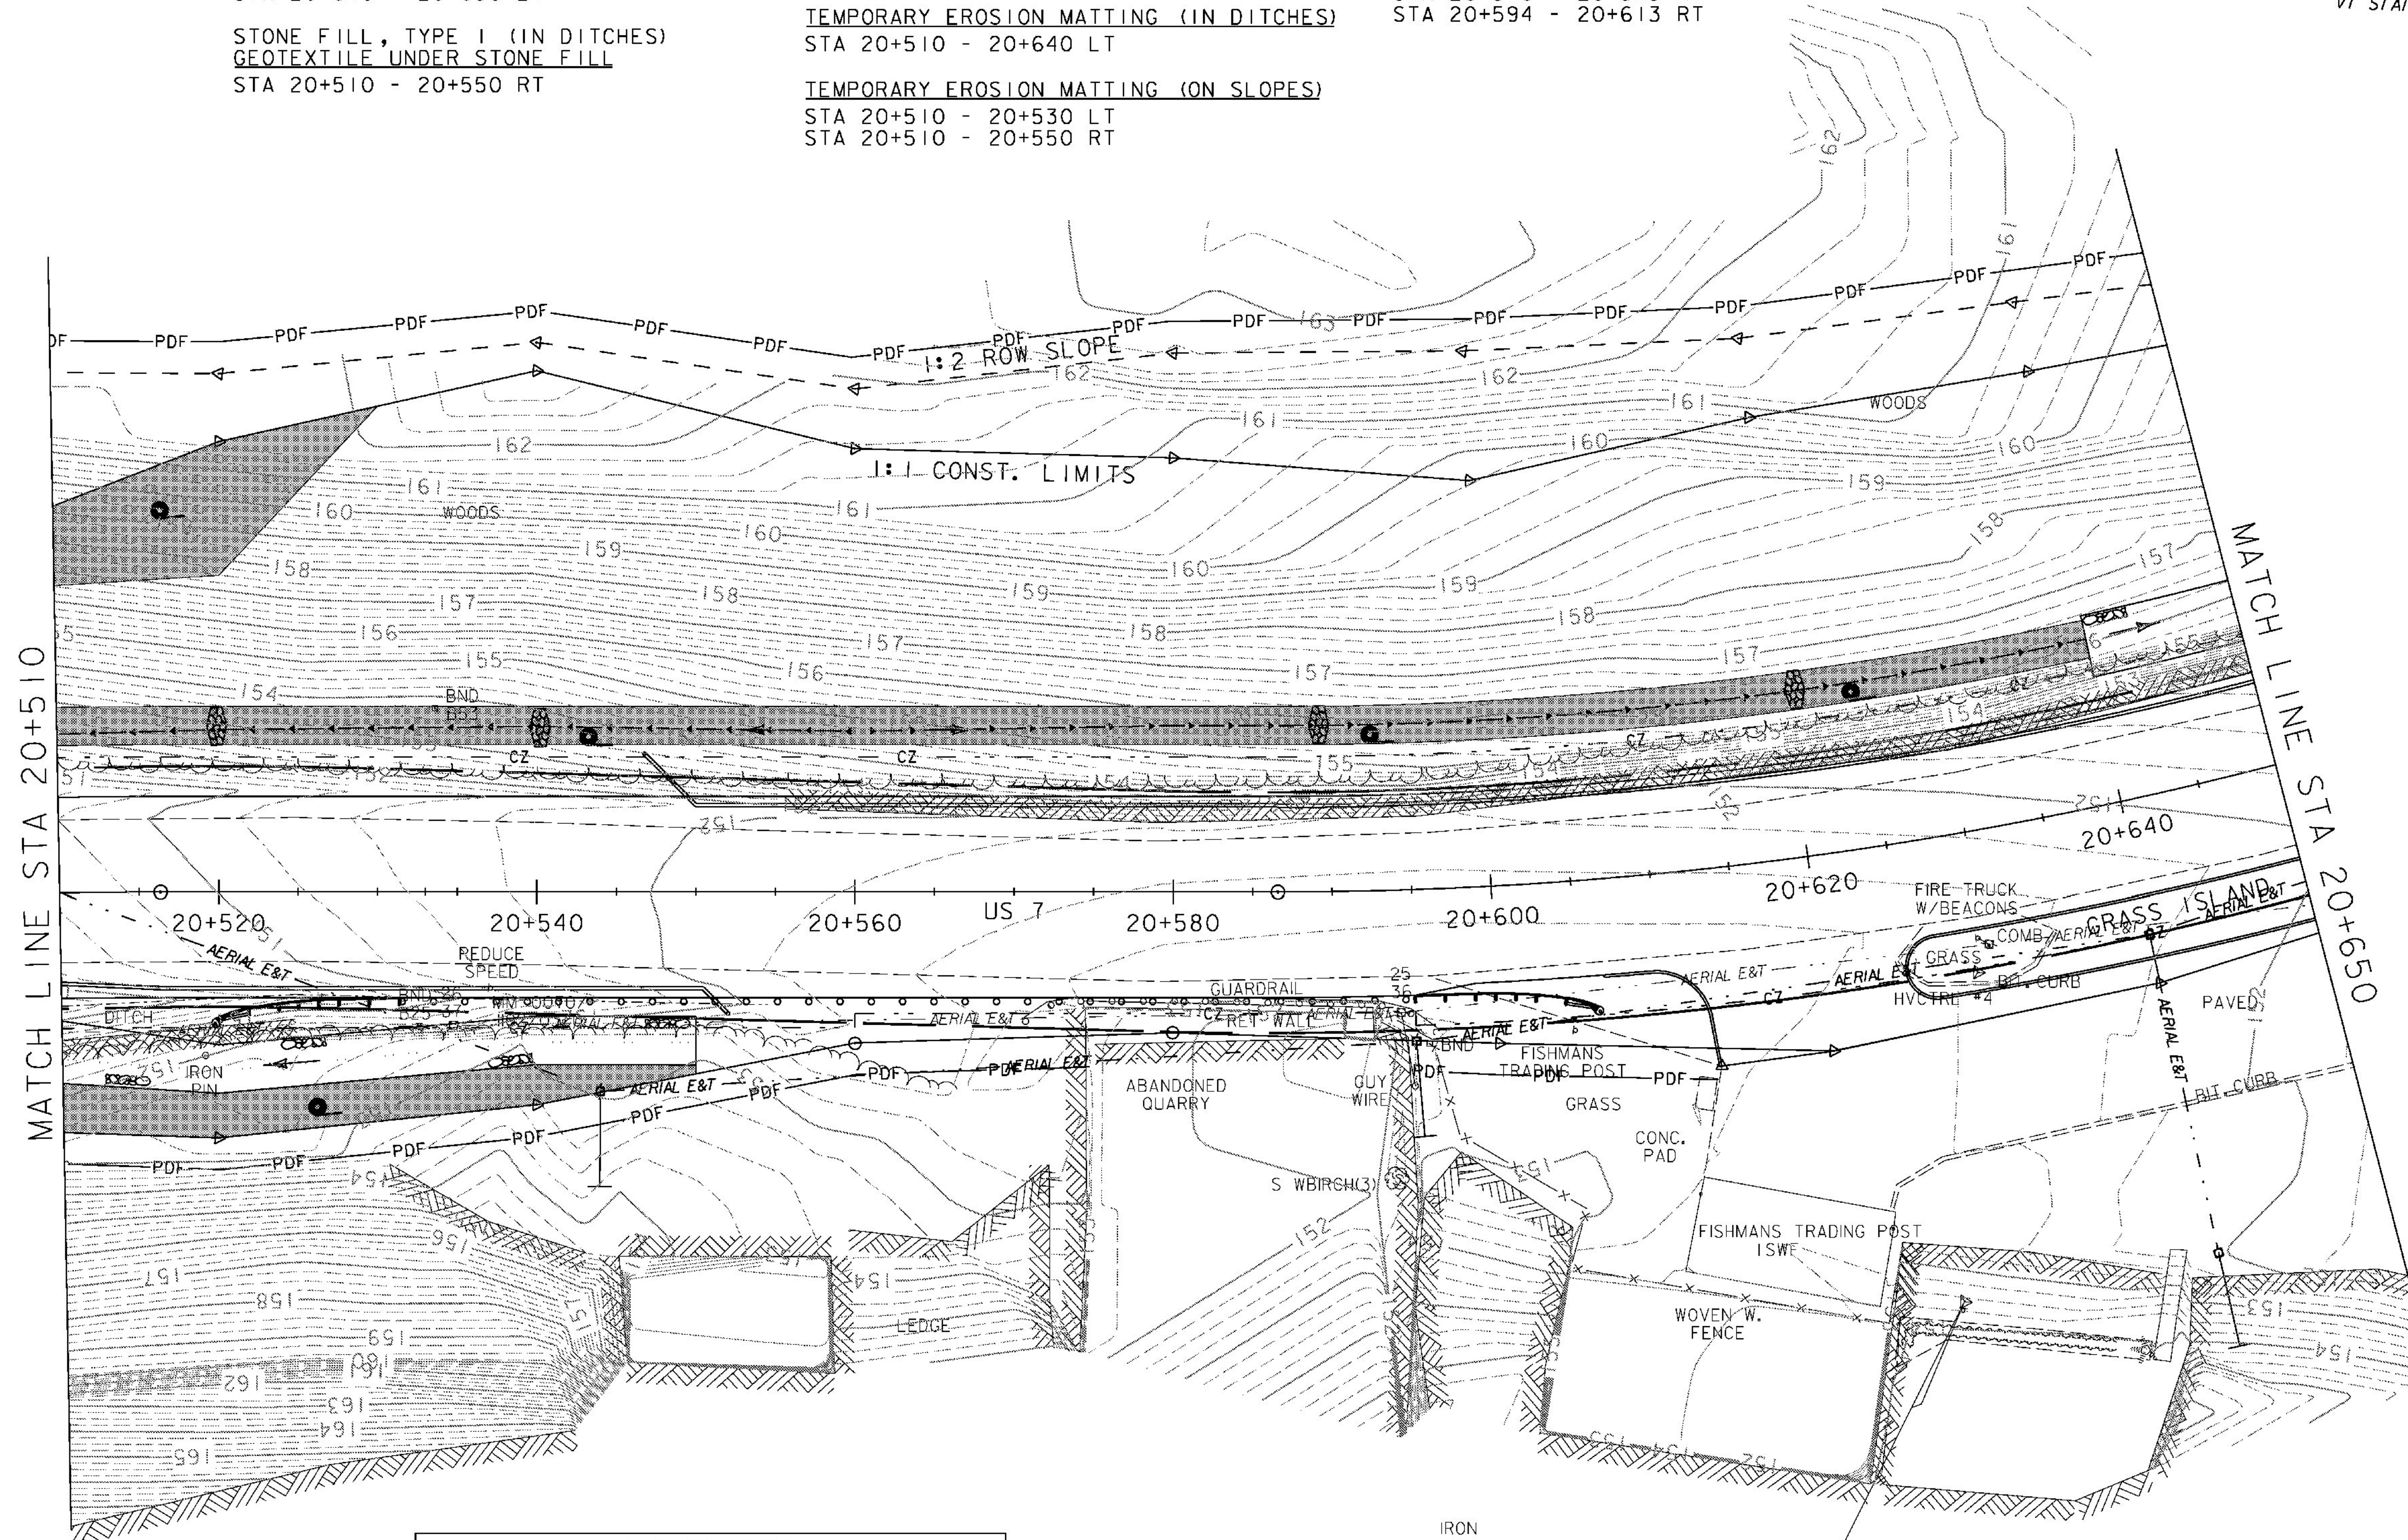


LEGEND	
	ROADSIDE DITCH/SLOPE PROTECTION
	DETOUR SLOPE LIMITS
	PERMANENT SLOPE LIMITS
	SILT FENCE
	INLET PROTECTION DEVICE, TYPE I
	PIPE INLET PROTECTION
	EROSION MATTING
	CHECK DAM - TEMPORARY
	BARRIER FENCE
	PROJECT DEMARCATION FENCE
	FILTER CURTAIN

NOTES:

1. SILT FENCE LOCATIONS SHOWN ON THIS DRAWING ARE APPROXIMATE. THE CONTRACTOR IS RESPONSIBLE FOR INSTALLING THE SILT FENCE IN ACCORDANCE WITH THE GUIDELINES SET FORTH IN THE VERMONT GENERAL PERMIT FOR STORMWATER RUNOFF FROM CONSTRUCTION SITES. THE RESIDENT ENGINEER AND ON SITE COORDINATOR SHALL APPROVE ALL SILT FENCE LOCATIONS PRIOR TO PLACEMENT.
2. FOR EROSION PREVENTION AND SEDIMENT CONTROL PLAN GENERAL NOTES, SEE SHEETS 147 - 148, AND DETAILS, SEE SHEETS 177 - 180.

TRAV. PT. #1
 VTGS DISK IN LEDGE
 GRIFFIN AZ MK 1997

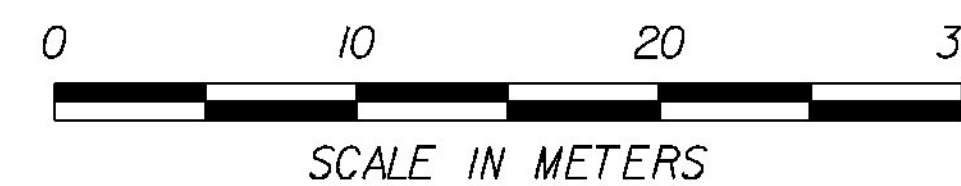

EROSION CONTROL PLAN 27

PROJECT NAME:	BRANDON	PLOT DATE:	9/3/2009
PROJECT NUMBER:	NH 019-3(495)	DRAWN BY:	NLL
FILE NAME:	zb008s5-ec27.dgn	CHECKED BY:	PTS
PROJECT LEADER:	CRB	SHEET	175 OF 546
DESIGNED BY:	NLL		