


MATCH LINE STA 17+490

MATCH LINE STA 17+650

**LIMIT OF WORK**  
STA 1+068.000

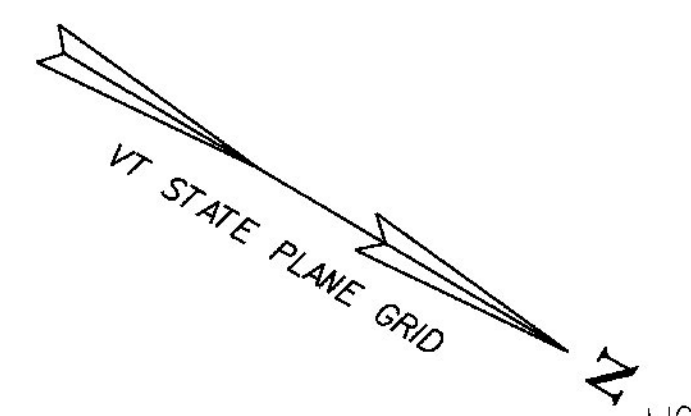

**DRAINAGE & UTILITY LAYOUT 8**

PROJECT NAME:	BRANDON	PLOT DATE:	9/3/2009
PROJECT NUMBER:	NH 019-3(495)	DRAWN BY:	NLL
FILE NAME:	zb008s5-drn08.dgn	CHECKED BY:	PTS
PROJECT LEADER:	CRB	SHEET	188 OF 546
DESIGNED BY:	DAM		

