



BM #13
RRSR S.PINE
EL. = 135.931m

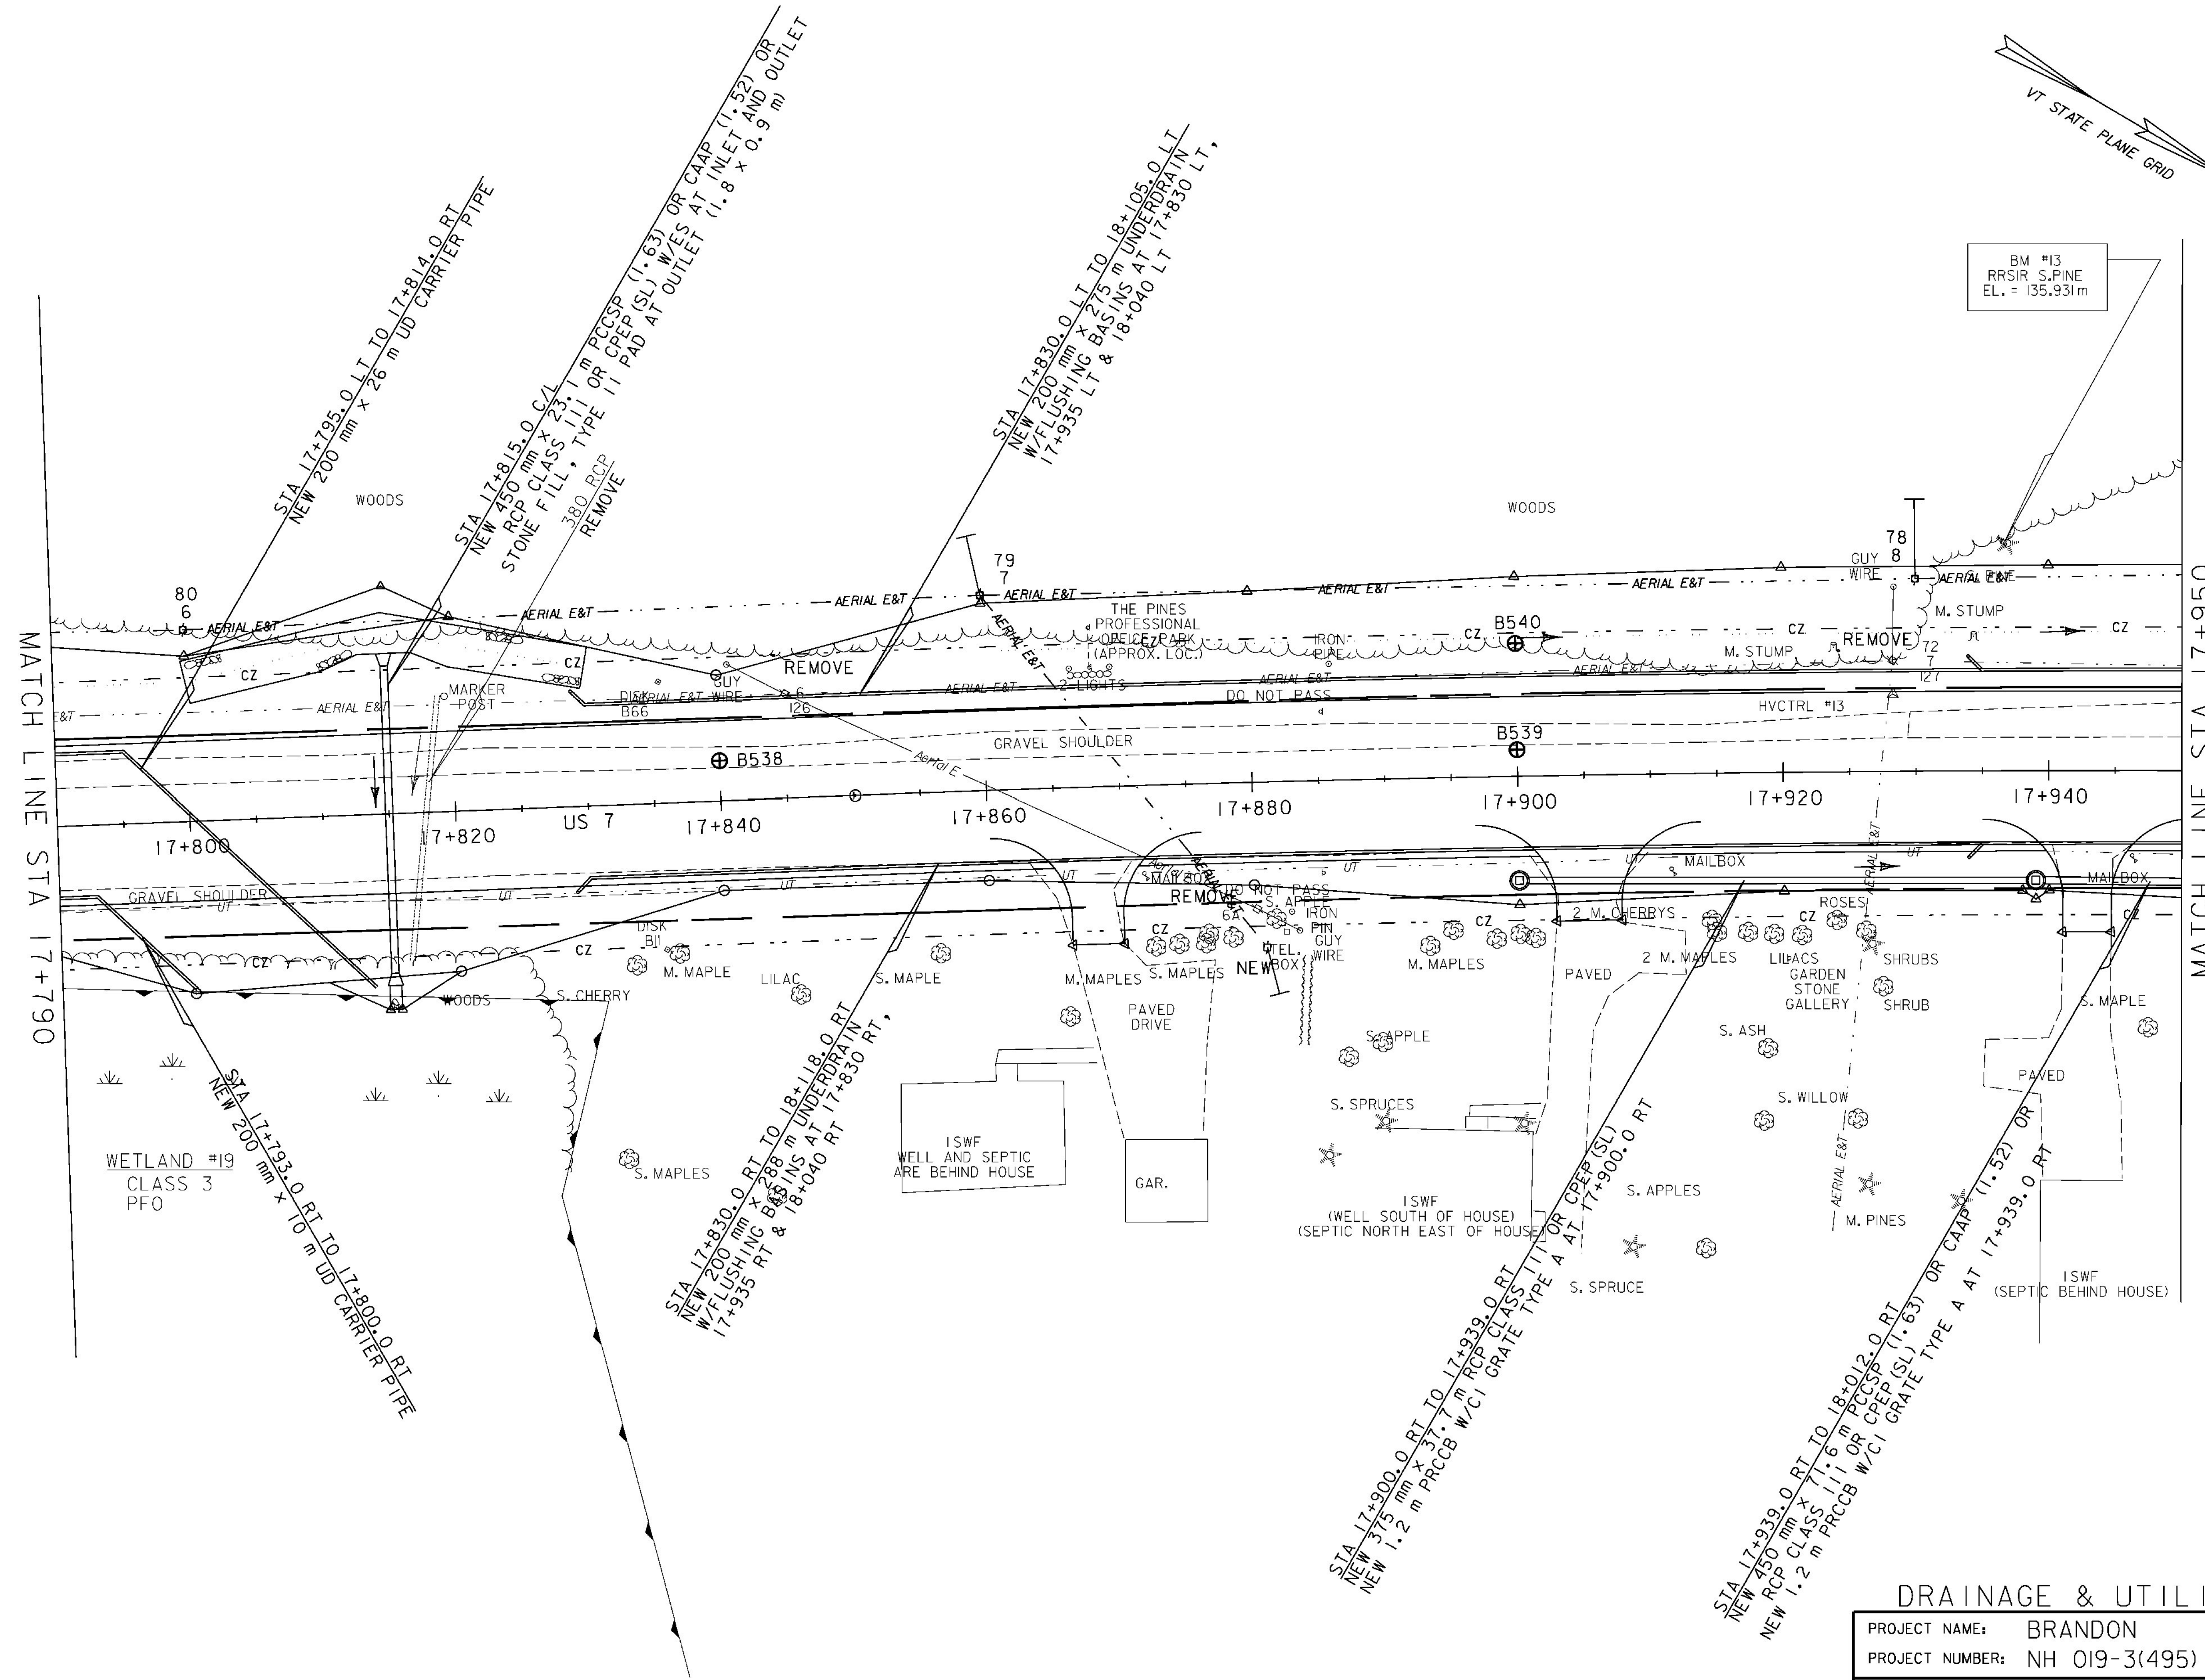

MATCH LINE STA 17+790

MATCH LINE STA 17+950

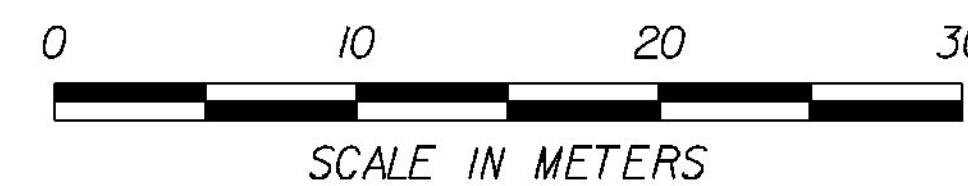

DRAINAGE & UTILITY LAYOUT 10

PROJECT NAME:	BRANDON	FILE NAME:	zb008s5-drrn10.dgn	PLOT DATE:	9/3/2009
PROJECT NUMBER:	NH 019-3(495)	PROJECT LEADER:	CRB	DRAWN BY:	NLL
		DESIGNED BY:	DAM	CHECKED BY:	PTS
		CLD 02-0149		SHEET 190	OF 546