


MATCH LINE STA 18+590

MATCH LINE STA 18+750

STA 18+593.0 RT
NEW 150 mm x 3.6 m RCP CLASS IV
STONE FILL, TYPE 11 PAD AT OUTLET (1.1 x 3.0 m)

JONES MILL POND
WETLAND #12
CLASS 2
PSSI/EMY

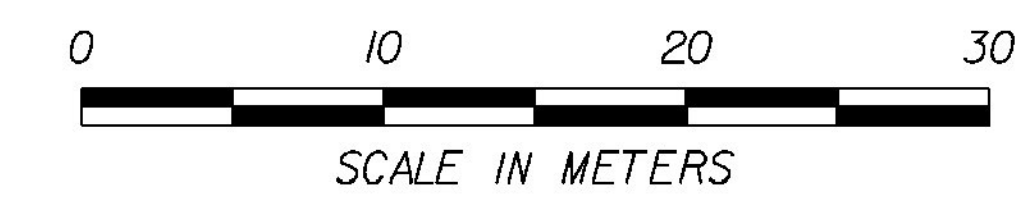

DRAINAGE & UTILITY LAYOUT 15	
PROJECT NAME:	BRANDON
PROJECT NUMBER:	NH 019-3(495)
FILE NAME:	zb008s5-drrnl5.dgn
PROJECT LEADER:	CRB
DESIGNED BY:	DAM
CLD 02-0149	
PLOT DATE:	9/3/2009
DRAWN BY:	NLL
CHECKED BY:	PTS
	SHEET 195 OF 546