
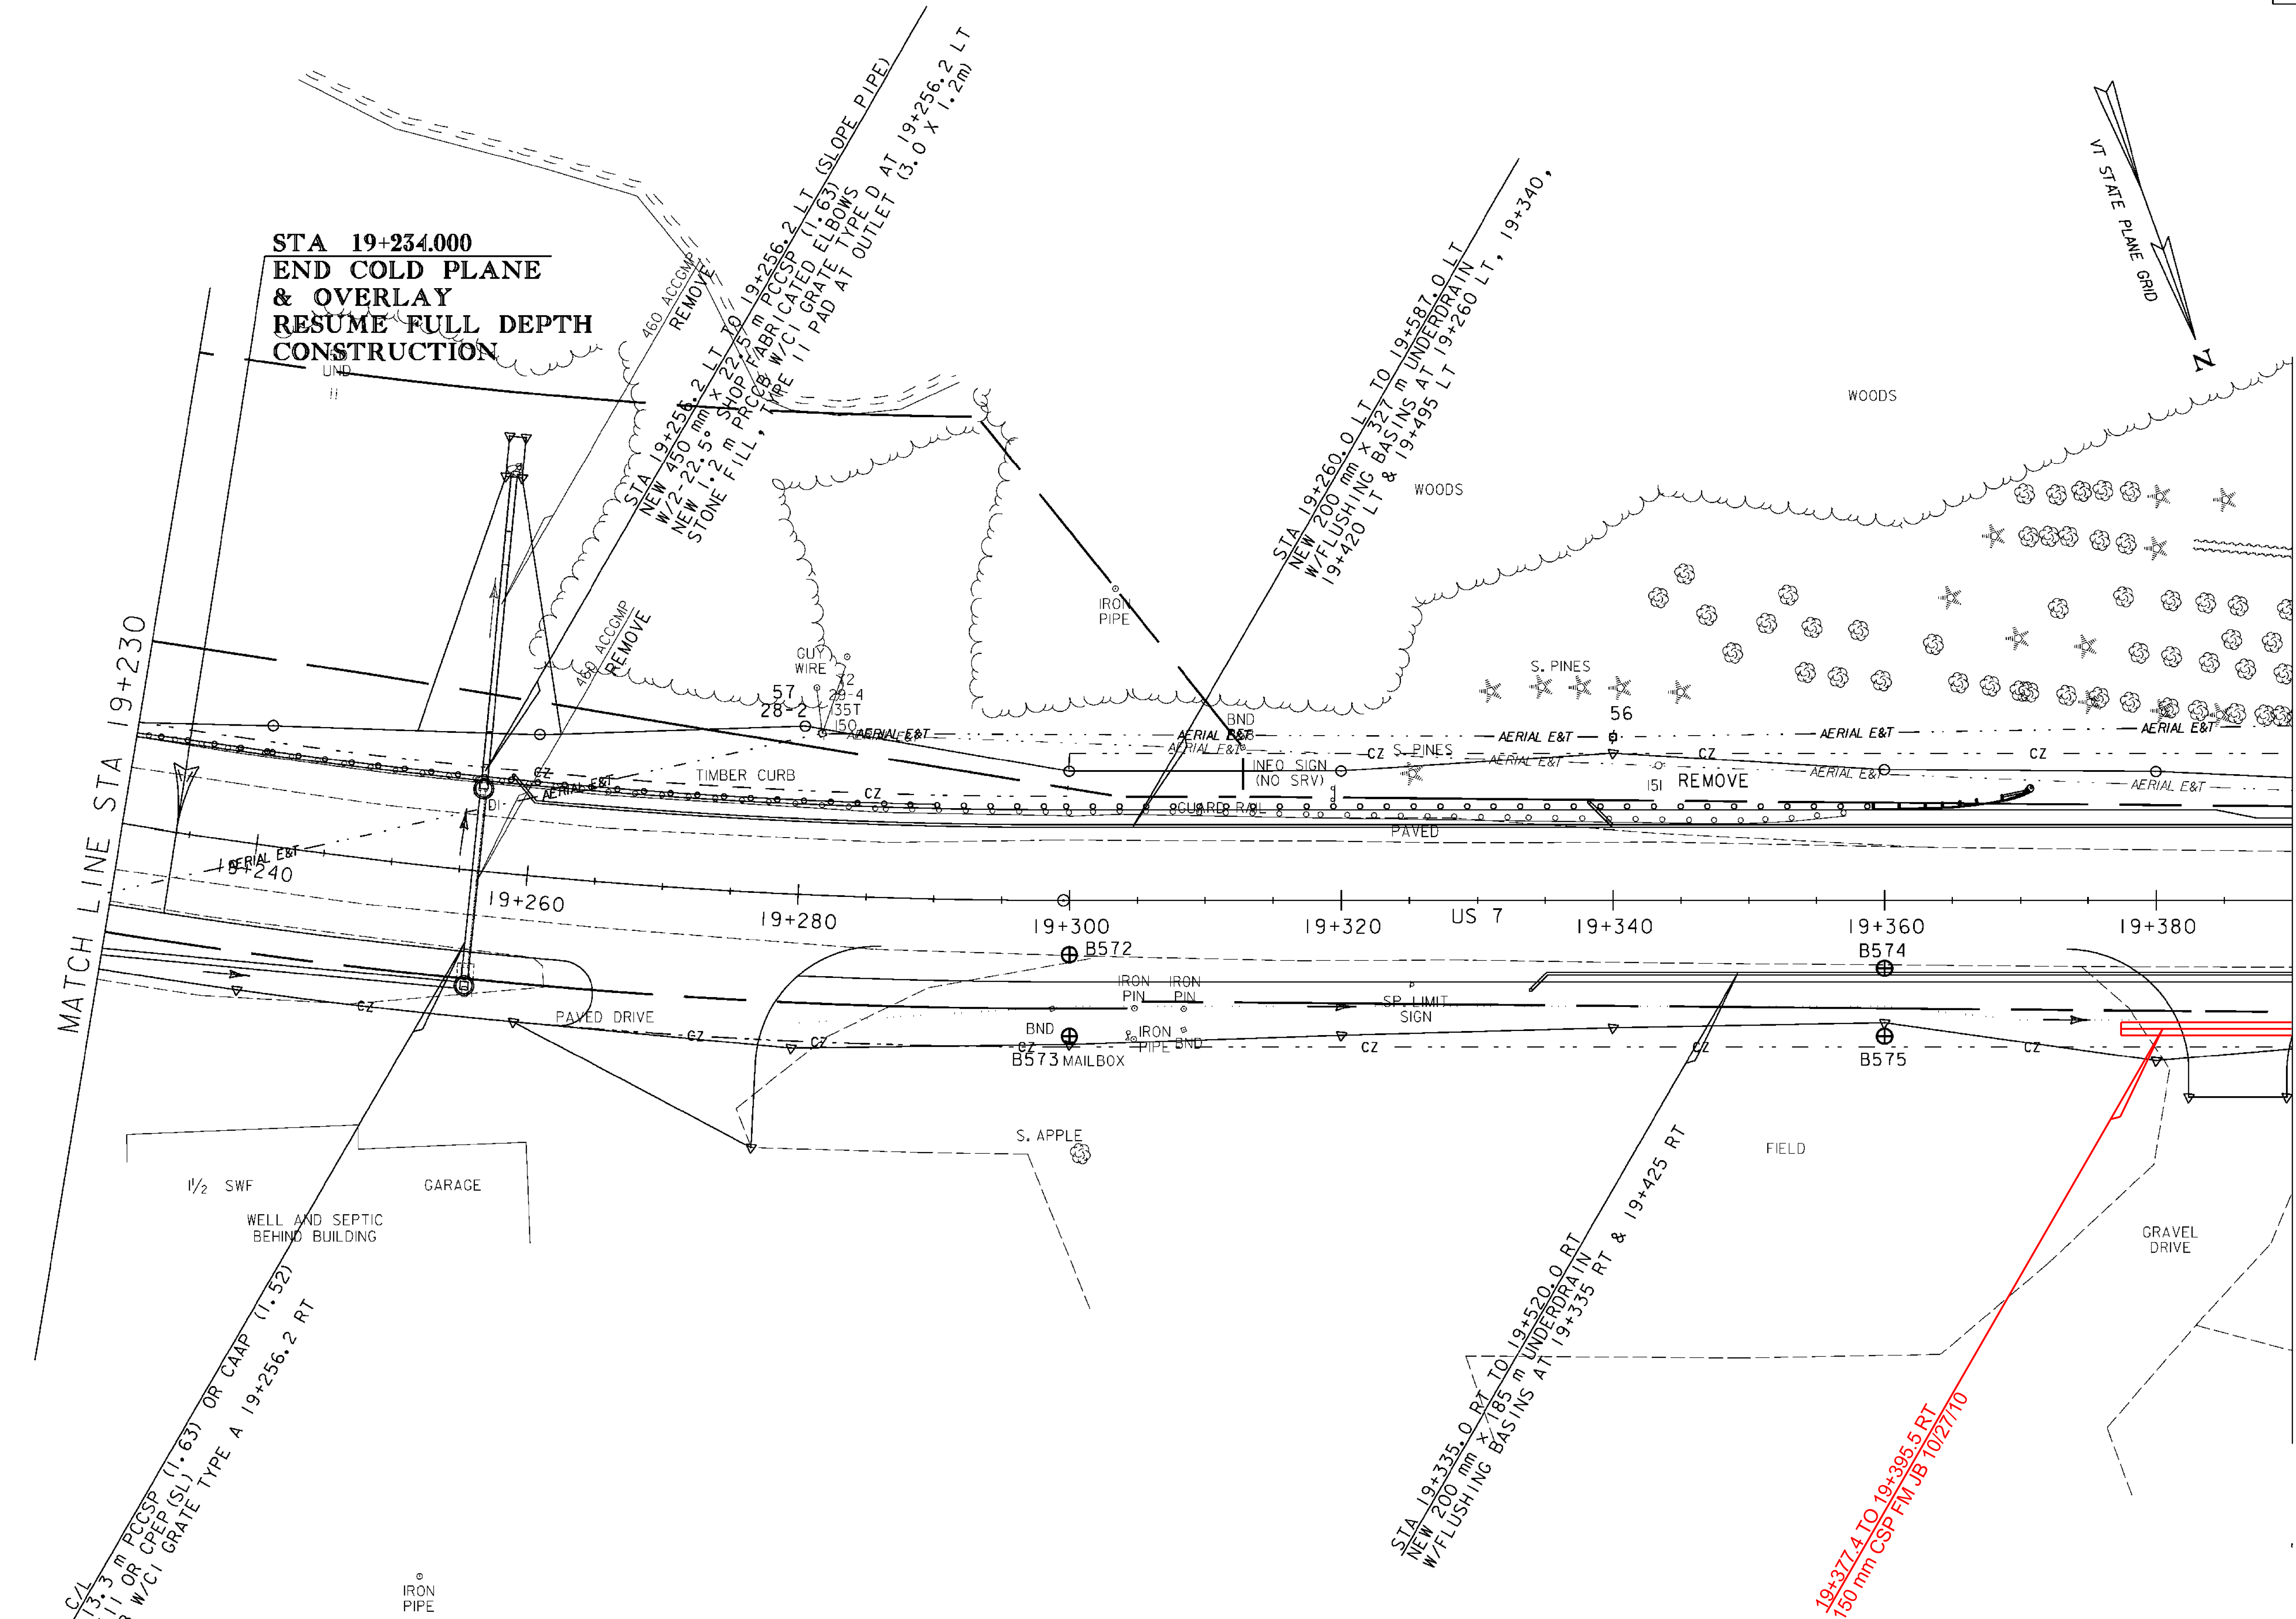


**STA 19+234.000
END COLD PLANE
& OVERLAY
RESUME FULL DEPTH
CONSTRUCTION**

MATCH LINE STA 19+230

MATCH LINE STA 19+390

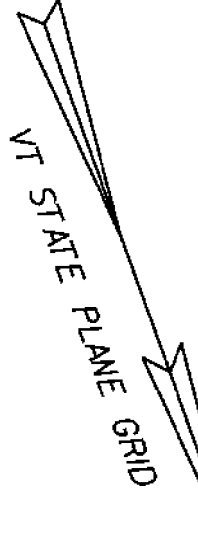

STA 19+236.2 C/L
NEW 450 mm X 1.3 m PCCSP (1.63) OR CAAP (1.52)
OR RCP CLASS 111 OR CPAP (SL) OR CPAP (SL) GRATE TYPE A 19+256.2 RT
NEW 1.2 m PCCCB W/CI GRATE TYPE A 19+256.2 RT

STA 19+256.2 LT TO 19+256.2 LT (SLOPE PIPE)
NEW 22.5 mm X 327 m UNDERDRAIN
W/FLUSHING BASINS AT 19+260 LT, 19+340,
19+420 LT & 19+495 LT

STA 19+256.2 LT TO 19+256.2 LT (SLOPE PIPE)
NEW 22.5 mm X 327 m UNDERDRAIN
W/FLUSHING BASINS AT 19+260 LT, 19+340,
19+420 LT & 19+495 LT

STA 19+335.0 RT TO 19+520.0 RT
NEW 200 mm X 185 m UNDERDRAIN
W/FLUSHING BASINS AT 19+335 RT & 19+425 RT

19+377.4 TO 19+395.5 RT
150 mm CSP FM JB 10/2/10

DRAINAGE & UTILITY LAYOUT 19

PROJECT NAME:	BRANDON	FILE NAME:	zb008s5-drn19.dgn	PLOT DATE:	9/3/2009
PROJECT NUMBER:	NH 019-3(495)	PROJECT LEADER:	CRB	DRAWN BY:	NLL
		DESIGNED BY:	DAM	CHECKED BY:	PTS
		CLD 02-019		SHEET	199 OF 546

