


MATCH LINE STA 19+390

MATCH LINE STA 19+550

19+400 19+420 B576 19+440 19+460 US 7 19+480 B578 19+500 19+520 19+540

**DRAINAGE & UTILITY LAYOUT 20**

PROJECT NAME:	BRANDON
PROJECT NUMBER:	NH 019-3(495)
FILE NAME:	zb008s5-drn20.dgn
PROJECT LEADER:	CRB
DESIGNED BY:	DAM
CLD 02-0149	
PLOT DATE:	9/3/2009
DRAWN BY:	NLL
CHECKED BY:	PTS
SHEET	200 OF 546

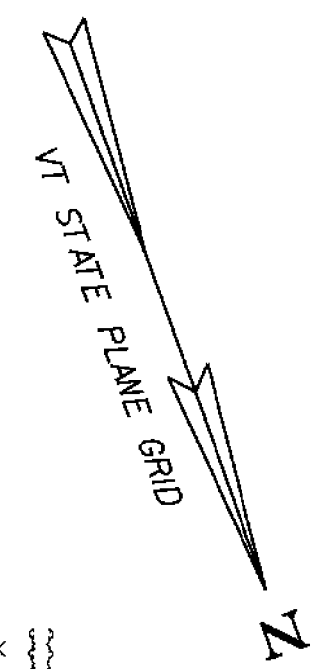

(COMMUNITY WELL)  
(SEPTIC BEHIND HOUSE)

(WELL-SOUTH WEST CORNER OF BUILDING)  
(SEPTIC-NORTH WEST CORNER OF PROPERTY)