


LANDSCAPE BACKFILL, TRUCK MEASUREMENT
 STA 17+975 TO 18+013 RT - 38 m x 3 m x 0.3 m

DECIDUOUS SHRUBS DECIDUOUS TREES EVERGREEN TREES
 10 PO 3 BP, 2 AG 18 PG, 7 TO

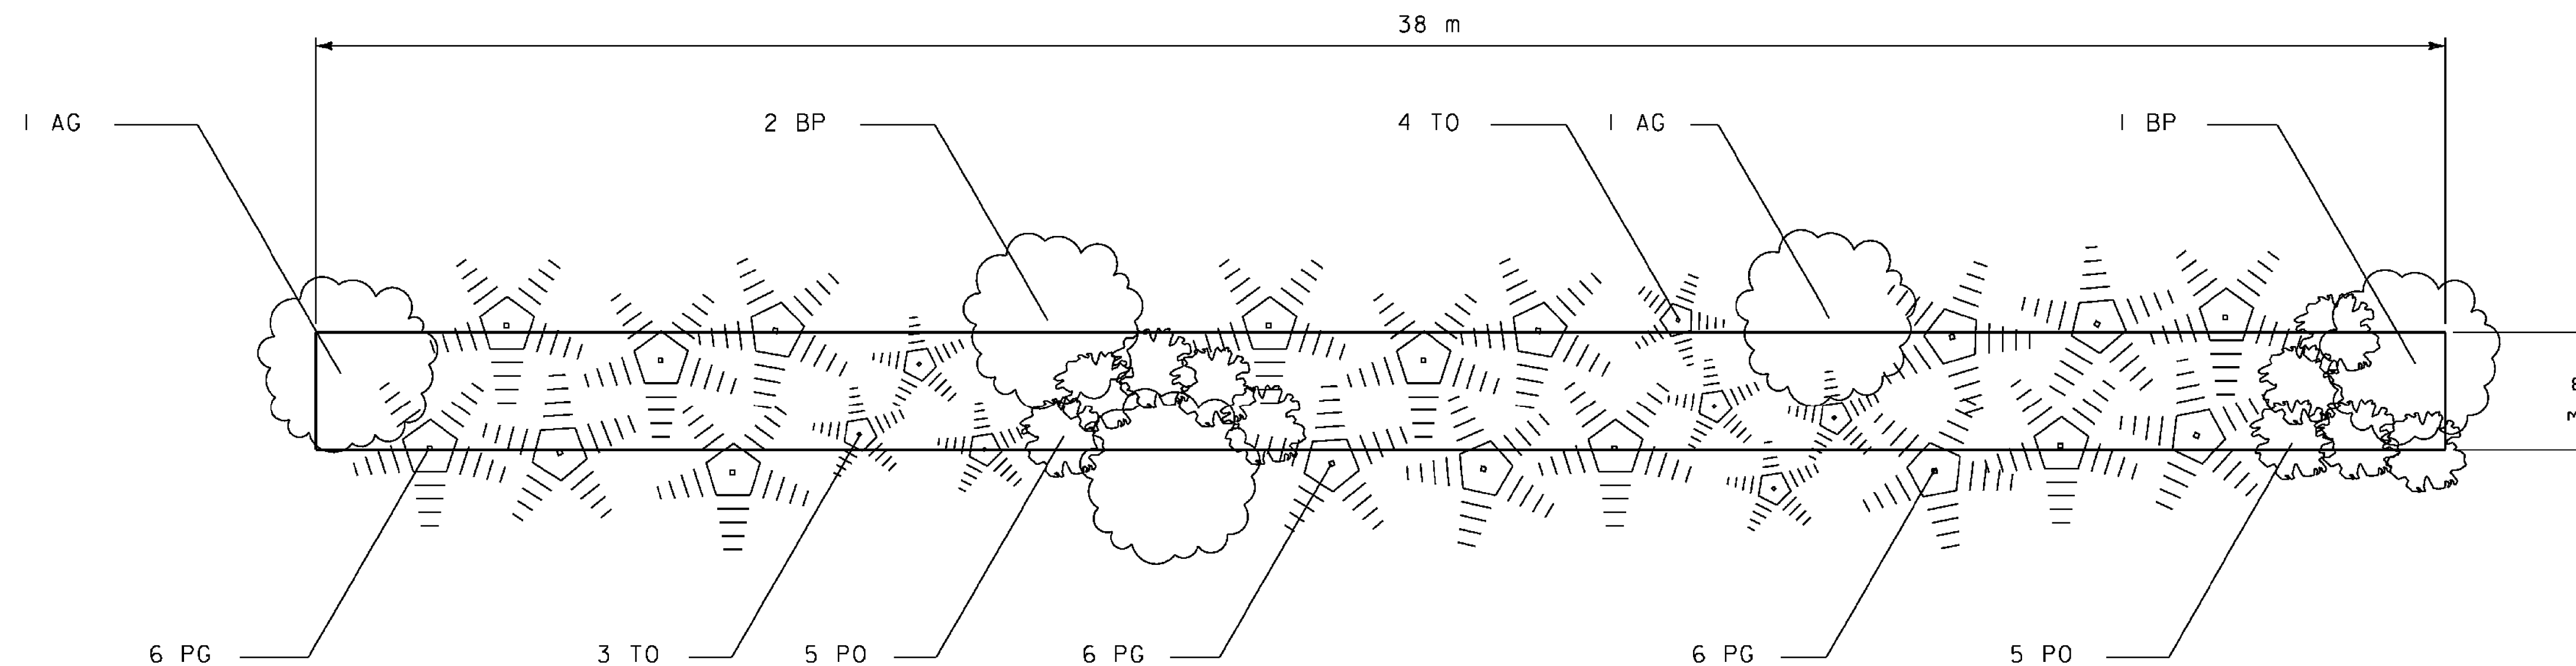

- NOTE
 1. SEE PLANT LIST FOR ADDITIONAL INFORMATION.
 2. MULCH ENTIRE BED.

NOTE:
 WORK NOT DONE.
 MATTHEW PHILO SIGNED OFF ON THIS ON 09/29/10
 AS WE ADJUSTED THE PIPE RUN IN THIS AREA
 TO LEAVE THE EXISTING HEDGE ROW.

STA 17+975 - 18+013 RT
LANDSCAPE DETAIL
 (NOT TO SCALE)

PLANT LIST

QTY	KEY	BOTANICAL NAME	COMMON NAME	SIZE	CONTAINER	SPACING, REMARKS ITEMS#
DECIDUOUS SHRUBS						
ITEM No. 656.35						
87	PO	PHYSOCARPUS OPULIFOLIUS	NINEBARK	750-900 HEIGHT	CONTAINER	1330 o.c. - SPRING PLANTING
56	RR	ROSA RUGOSA	RUGOSA ROSE	750-900 HEIGHT	CONTAINER	1330 o.c. - SPRING PLANTING
206	RT	RHUS TYPHINA	STAGHORN SUMAC	750-900 HEIGHT	CONTAINER	1330 o.c. - SPRING PLANTING
34	SPA	SYRINGA PATULA 'MISS KIM'	MISS KIM DWARF LILAC	750-900 HEIGHT	CONTAINER	1330 o.c. - SPRING PLANTING
22	SP	SALIX PURPUREA	BLUE ARCTIC WILLOW	750-900 HEIGHT	CONTAINER	1330 o.c. - SPRING PLANTING
49	CR	CORNUS RACEMOSA	GRAY DOGWOOD	750-900 HEIGHT	CONTAINER	1330 o.c. - SPRING PLANTING
DECIDUOUS TREES						
ITEM No. 656.30						
6	MHG	MALUS 'HARVEST GOLD'	HARVEST GOLD CRABAPPLE	25-40 CAL.	B&B	AS SHOWN - SPRING PLANTING
3	BP	BETULA Papyrifera	PAPER BIRCH	2440-3050 HEIGHT-3 STEM	B&B	AS SHOWN - SPRING PLANTING
8	GT	GLEDITSIA TRIACANTHOS INERMIS 'SHADEMASTER'	SHADEMASTER HONEYLOCUST	50-65 CAL.	B&B	AS SHOWN - SPRING PLANTING
9	AF	ACER X FREEMANII 'AUTUMN BLAZE'	AUTUMN BLAZE MAPLE	50-65 CAL.	B&B	AS SHOWN - SPRING PLANTING
5	UC	ULMUS CARPINIFOLIA 'ACCOLADE'	ACCOLADE ELM	50-65 CAL.	B&B	AS SHOWN - SPRING PLANTING
2	AG	ACER GINNALA	AMUR MAPLE	25-40 CAL.	B&B	AS SHOWN - SPRING PLANTING
2	QR	QUERCUS RUBRA	RED OAK	50-65 CAL.	B&B	AS SHOWN - SPRING PLANTING
3	S. MAPLE	ACER SACCHARUM - SUGAR MAPLE (50-65 CaL)(BEB)	SUGAR MAPLE	50 - 60 CAL	B&B	
EVERGREEN TREES						
ITEM No. 656.20						
22	PG	PICEA GLAUCA	WHITE SPRUCE	1830-2130 HEIGHT	B&B	AS SHOWN - SPRING PLANTING
7	TO	THUJA OCCIDENTALIS	NORTHERN WHITE CEDAR	910-1220 HEIGHT	CONTAINER	AS SHOWN - SPRING PLANTING
13	CRAB	SUGAR TYME - CRAB APPLE	CRAB APPLE	25 - 40 CAL	B&B	

LANDSCAPE DETAIL SHEET 1

PROJECT NAME:	BRANDON
PROJECT NUMBER:	NH 019-3(495)
FILE NAME:	zb008ldscDe+01-5.dgn
PROJECT LEADER:	CRB
DESIGNED BY:	VTRANS
CLD 02-0149	
PLOT DATE:	9/3/2009
DRAWN BY:	JCS
CHECKED BY:	PTS
SHEET	210 OF 546