


DECIDUOUS TREES
 STA 17+110 TO 17+128 RT - 1 GT, 1 UC
 STA 17+142 TO 17+160 RT - 1 GT, 1 UC

TREE PROTECTION
 STA 17+130 TO 17+142 RT - 1 TREE

LANDSCAPE BACKFILL, TRUCK MEASUREMENT
 STA 17+110 TO 17+128 RT - 18 m x 3 m x 1 m
 STA 17+142 TO 17+160 RT - 18 m x 3 m x 1 m

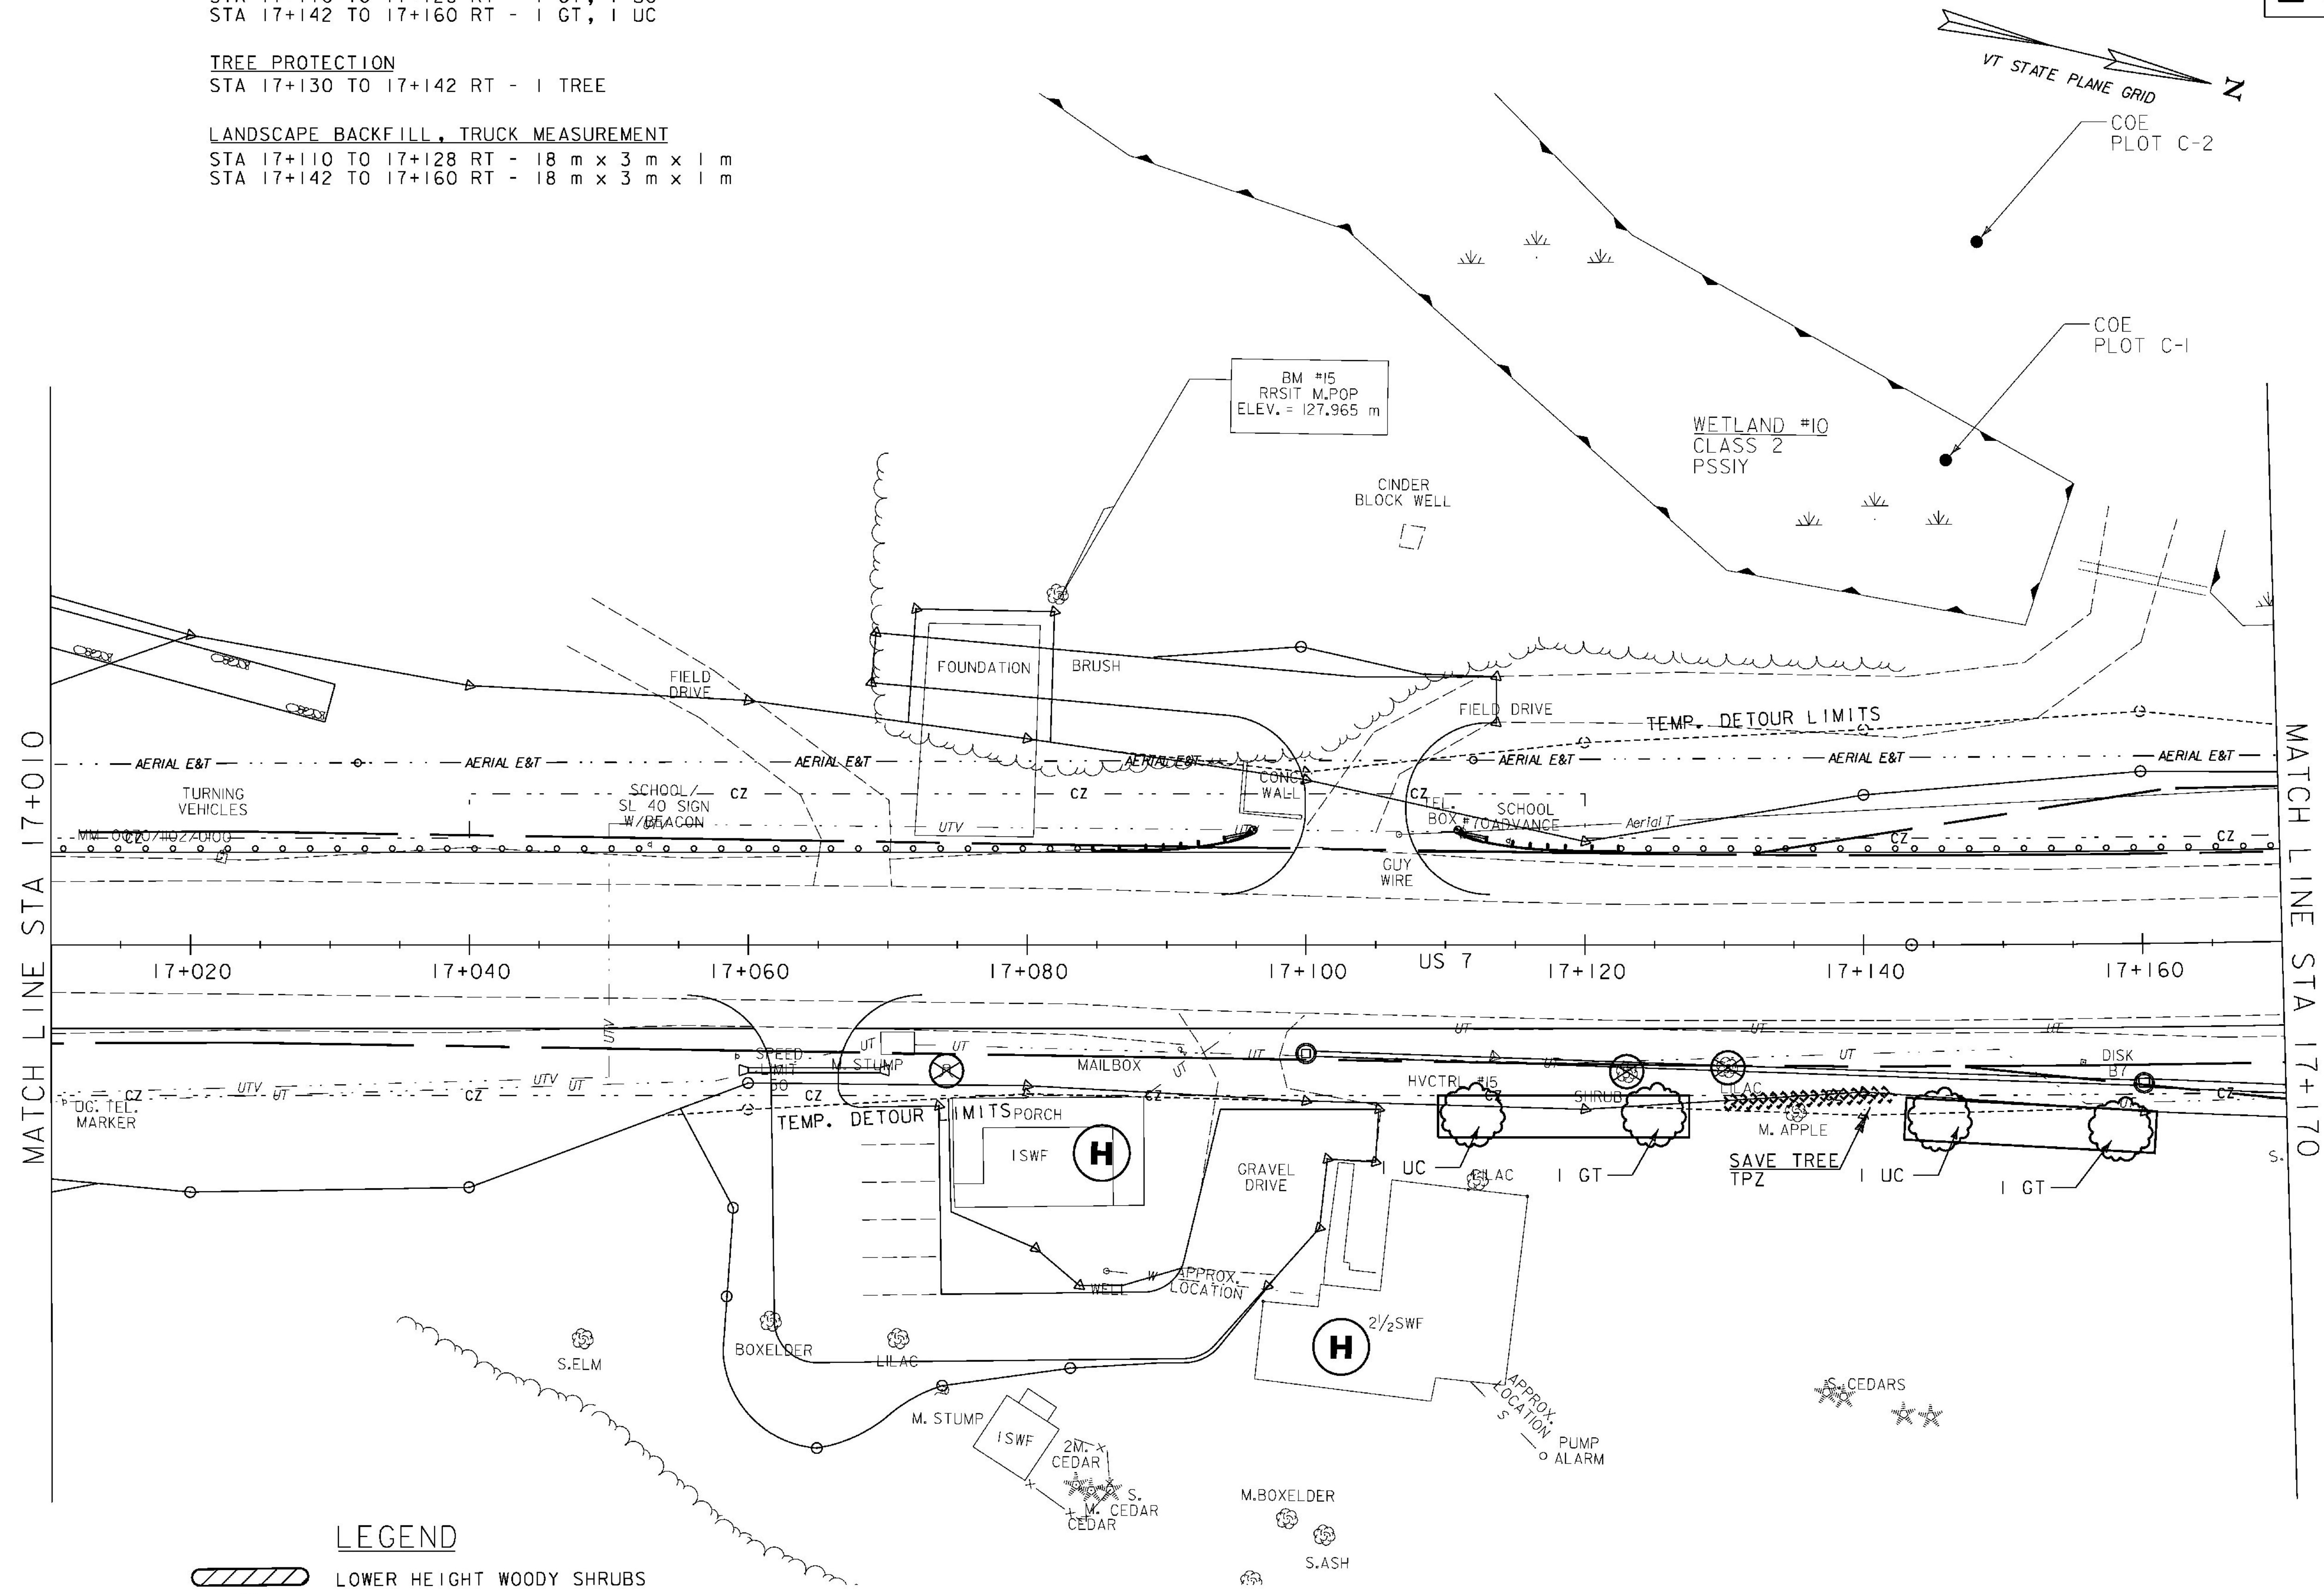

MATCH LINE STA 17+010

MATCH LINE STA 17+170

17+020 17+040 17+060 17+080 17+100 US 7 17+120 17+140 17+160

- LEGEND**
- LOWER HEIGHT WOODY SHRUBS
 - PROPOSED DECIDUOUS TREE
 - PROPOSED CONIFEROUS TREE
 - SAVE TREE / TREE PROTECTION ZONE WITH FENCING (TPZ)
 - LIMIT OF CUT & FILL / GRASS SEEDING OF DISTURBED AREAS
 - LANDSCAPE BACKFILL
 - DENOTES TREE OR STUMP REMOVAL



LANDSCAPE PLAN 5	
PROJECT NAME:	BRANDON
PROJECT NUMBER:	NH 019-3(495)
FILE NAME:	zb008s5-ldsc05.dgn
PROJECT LEADER:	VTRANS
DESIGNED BY:	VTRANS
CLD 02-0149	
PLOT DATE:	9/3/2009
DRAWN BY:	JCS
CHECKED BY:	VTRANS
	SHEET 217 OF 546