

**DECIDUOUS TREES**


STA 17+330 LT - 1 GT  
 STA 17+374 LT - 1 QR  
 STA 17+381 LT - 1 GT  
 STA 17+388 LT - 1 QR

**LANDSCAPE BACKFILL, TRUCK MEASUREMENT**

STA 17+330 RT - 5 m x 3 m x 1 m  
 STA 17+374 - 17+388 LT - 17 m x 3 m x 1 m


**TREE PROTECTION**

STA 17+360 TO 17+372 LT - 1 TREE  
 STA 17+390 TO 17+405 LT - 1 TREE

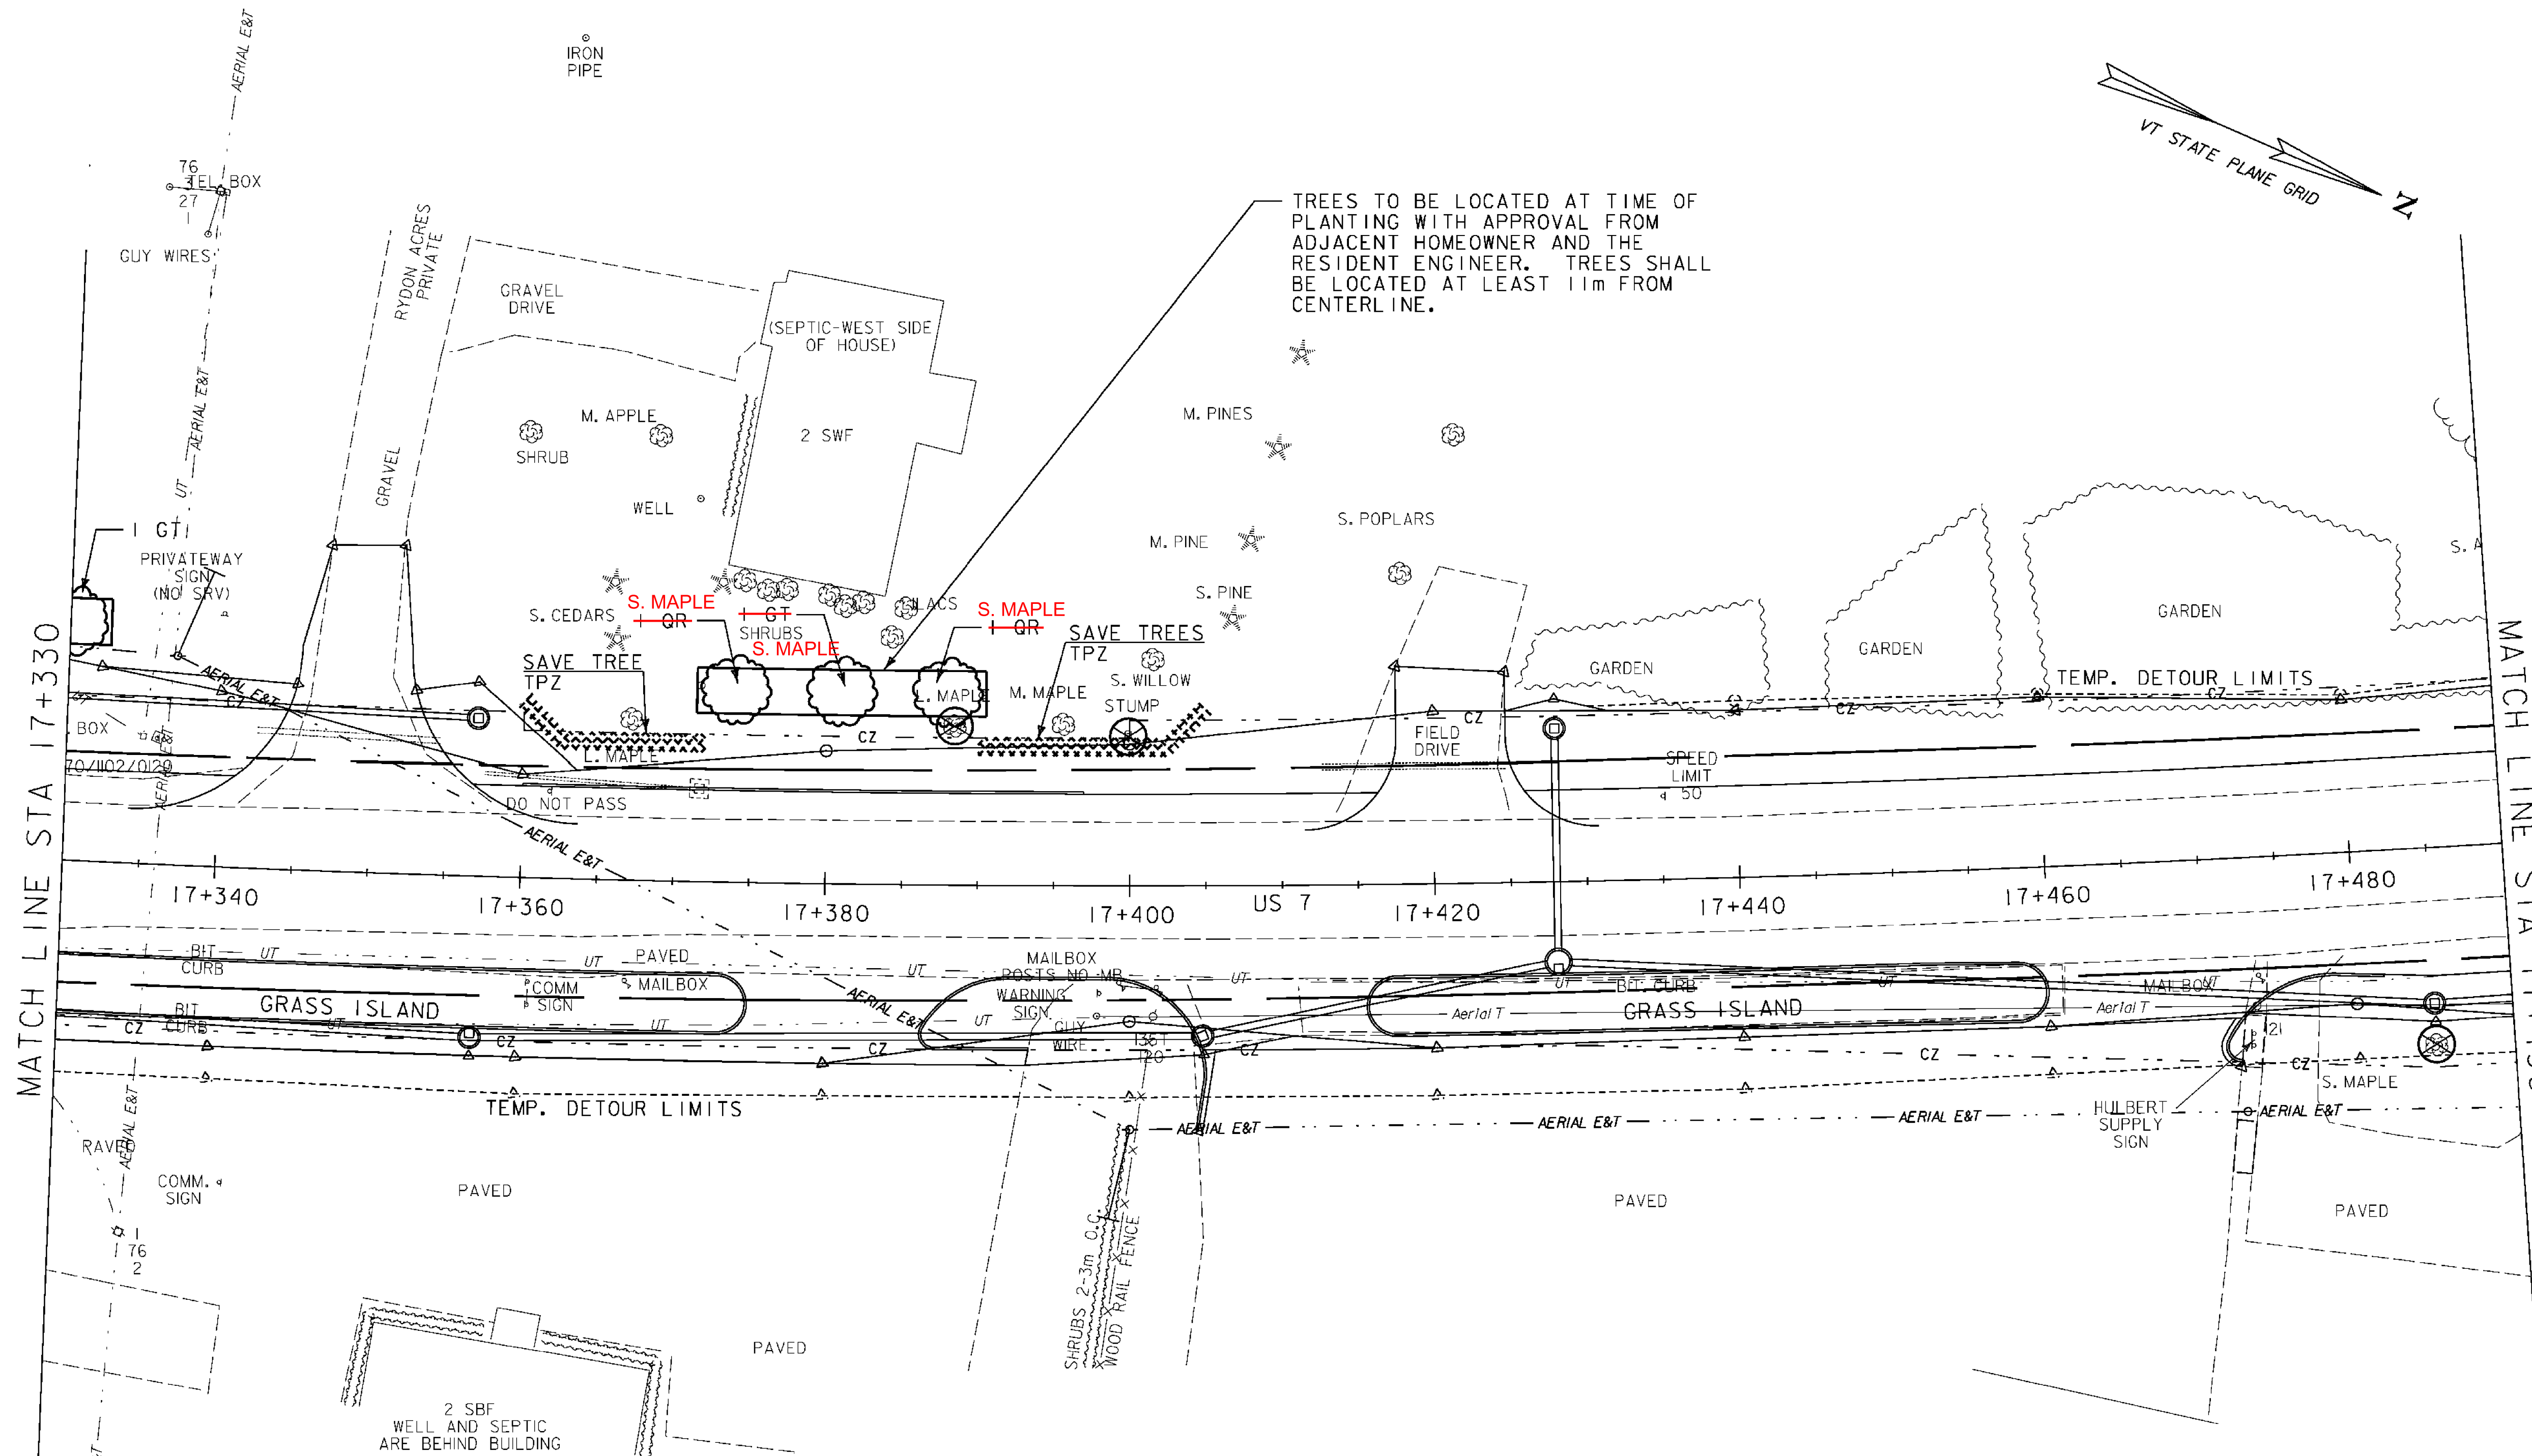

MATCH LINE STA 17+330

MATCH LINE STA 17+490

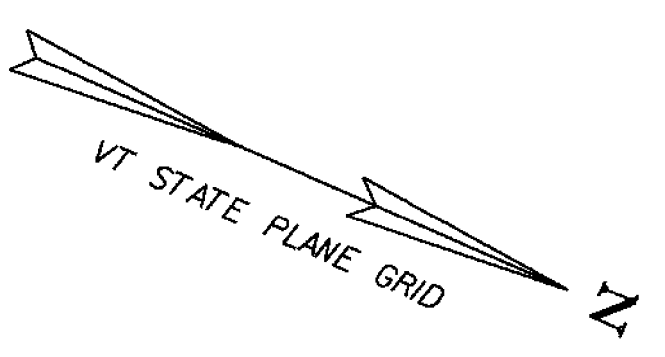

- LEGEND**
- LOWER HEIGHT WOODY SHRUBS
  - PROPOSED DECIDUOUS TREE
  - PROPOSED CONIFEROUS TREE
  - SAVE TREE / TREE PROTECTION ZONE WITH FENCING (TPZ)
  - LIMIT OF CUT & FILL / GRASS SEEDING OF DISTURBED AREAS
  - LANDSCAPE BACKFILL
  - DENOTES TREE OR STUMP REMOVAL



<b>LANDSCAPE PLAN 7</b>	
PROJECT NAME:	BRANDON
PROJECT NUMBER:	NH 019-3(495)
FILE NAME:	zb008s5-ldsc07.dgn
PROJECT LEADER:	VTRANS
DESIGNED BY:	VTRANS
CLD 02-0149	
PLOT DATE:	9/3/2009
DRAWN BY:	JCS
CHECKED BY:	VTRANS
SHEET	219 OF 546

WELL IS NORTH OF BUILDING  
 SEPTIC IS BEHIND BUILDING