

DECIDUOUS SHRUBS

STA 17+950 TO 17+975 LT - 44 RT
 STA 17+975 TO 18+013 RT - 10 PO
 STA 18+080 TO 18+110 LT - 44 RT

LANDSCAPE BACKFILL, TRUCK MEASUREMENT

STA 17+950 TO 17+975 LT - 30 m x 3 m x 0.3 m
 STA 18+080 TO 18+110 LT - 30 m x 3 m x 0.3 m
 STA 18+060 TO 18+090 RT - 30 m x 3 m x 1 m

DECIDUOUS TREES


STA 17+975 TO 18+013 RT - 3 BP, 2 AG
 STA 18+065 TO 18+090 RT - 3 AF

EVERGREEN TREES

STA 17+975 TO 18+013 RT - 18 PG, 7 TO

TREE PROTECTION

STA 17+970 TO 17+980 RT - 1 TREE
 STA 17+990 TO 18+000 LT - 1 TREE

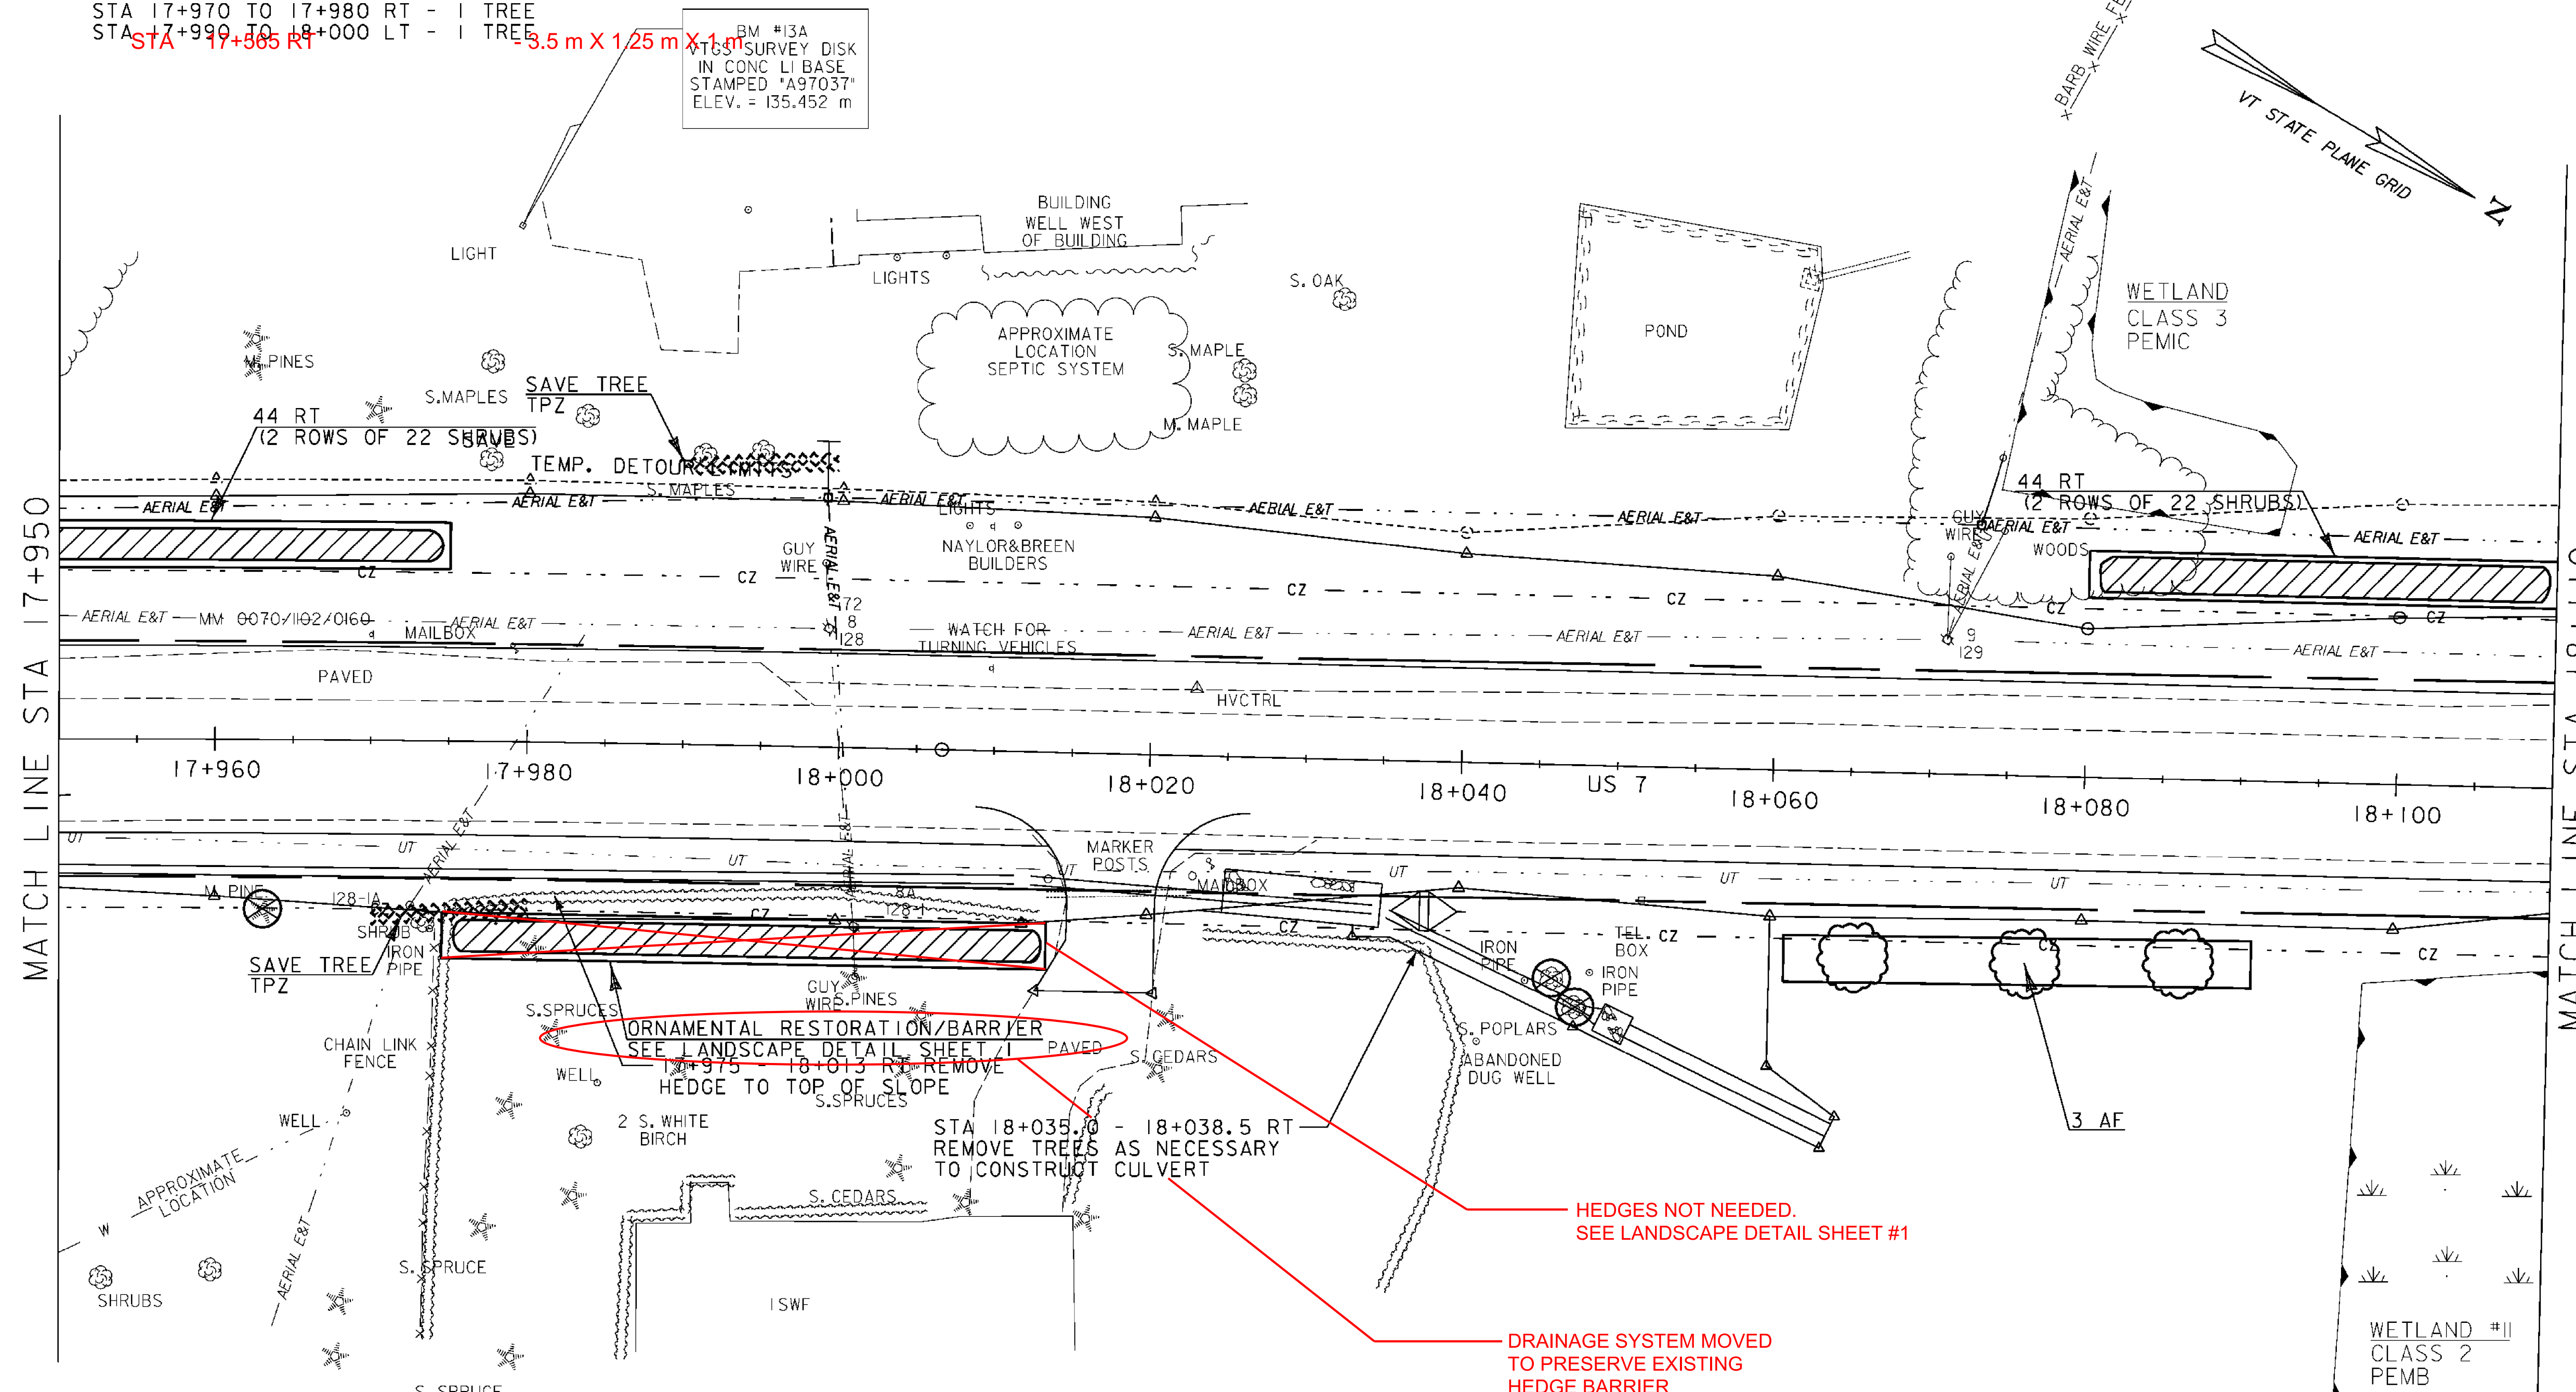

LEGEND

- LOWER HEIGHT WOODY SHRUBS
- PROPOSED DECIDUOUS TREE
- PROPOSED CONIFEROUS TREE
- SAVE TREE / TREE PROTECTION ZONE WITH FENCING (TPZ)
- LIMIT OF CUT & FILL / GRASS SEEDING OF DISTURBED AREAS
- LANDSCAPE BACKFILL
- DENOTES TREE OR STUMP REMOVAL



LANDSCAPE PLAN II

PROJECT NAME:	BRANDON	PLOT DATE:	9/3/2009
PROJECT NUMBER:	NH 019-3(495)	DRAWN BY:	JCS
FILE NAME:	zb008s5-ldsc11.dgn	CHECKED BY:	VTRANS
PROJECT LEADER:	VTRANS	SHEET	223 OF 546
DESIGNED BY:	VTRANS		
CLD 02-0149			