
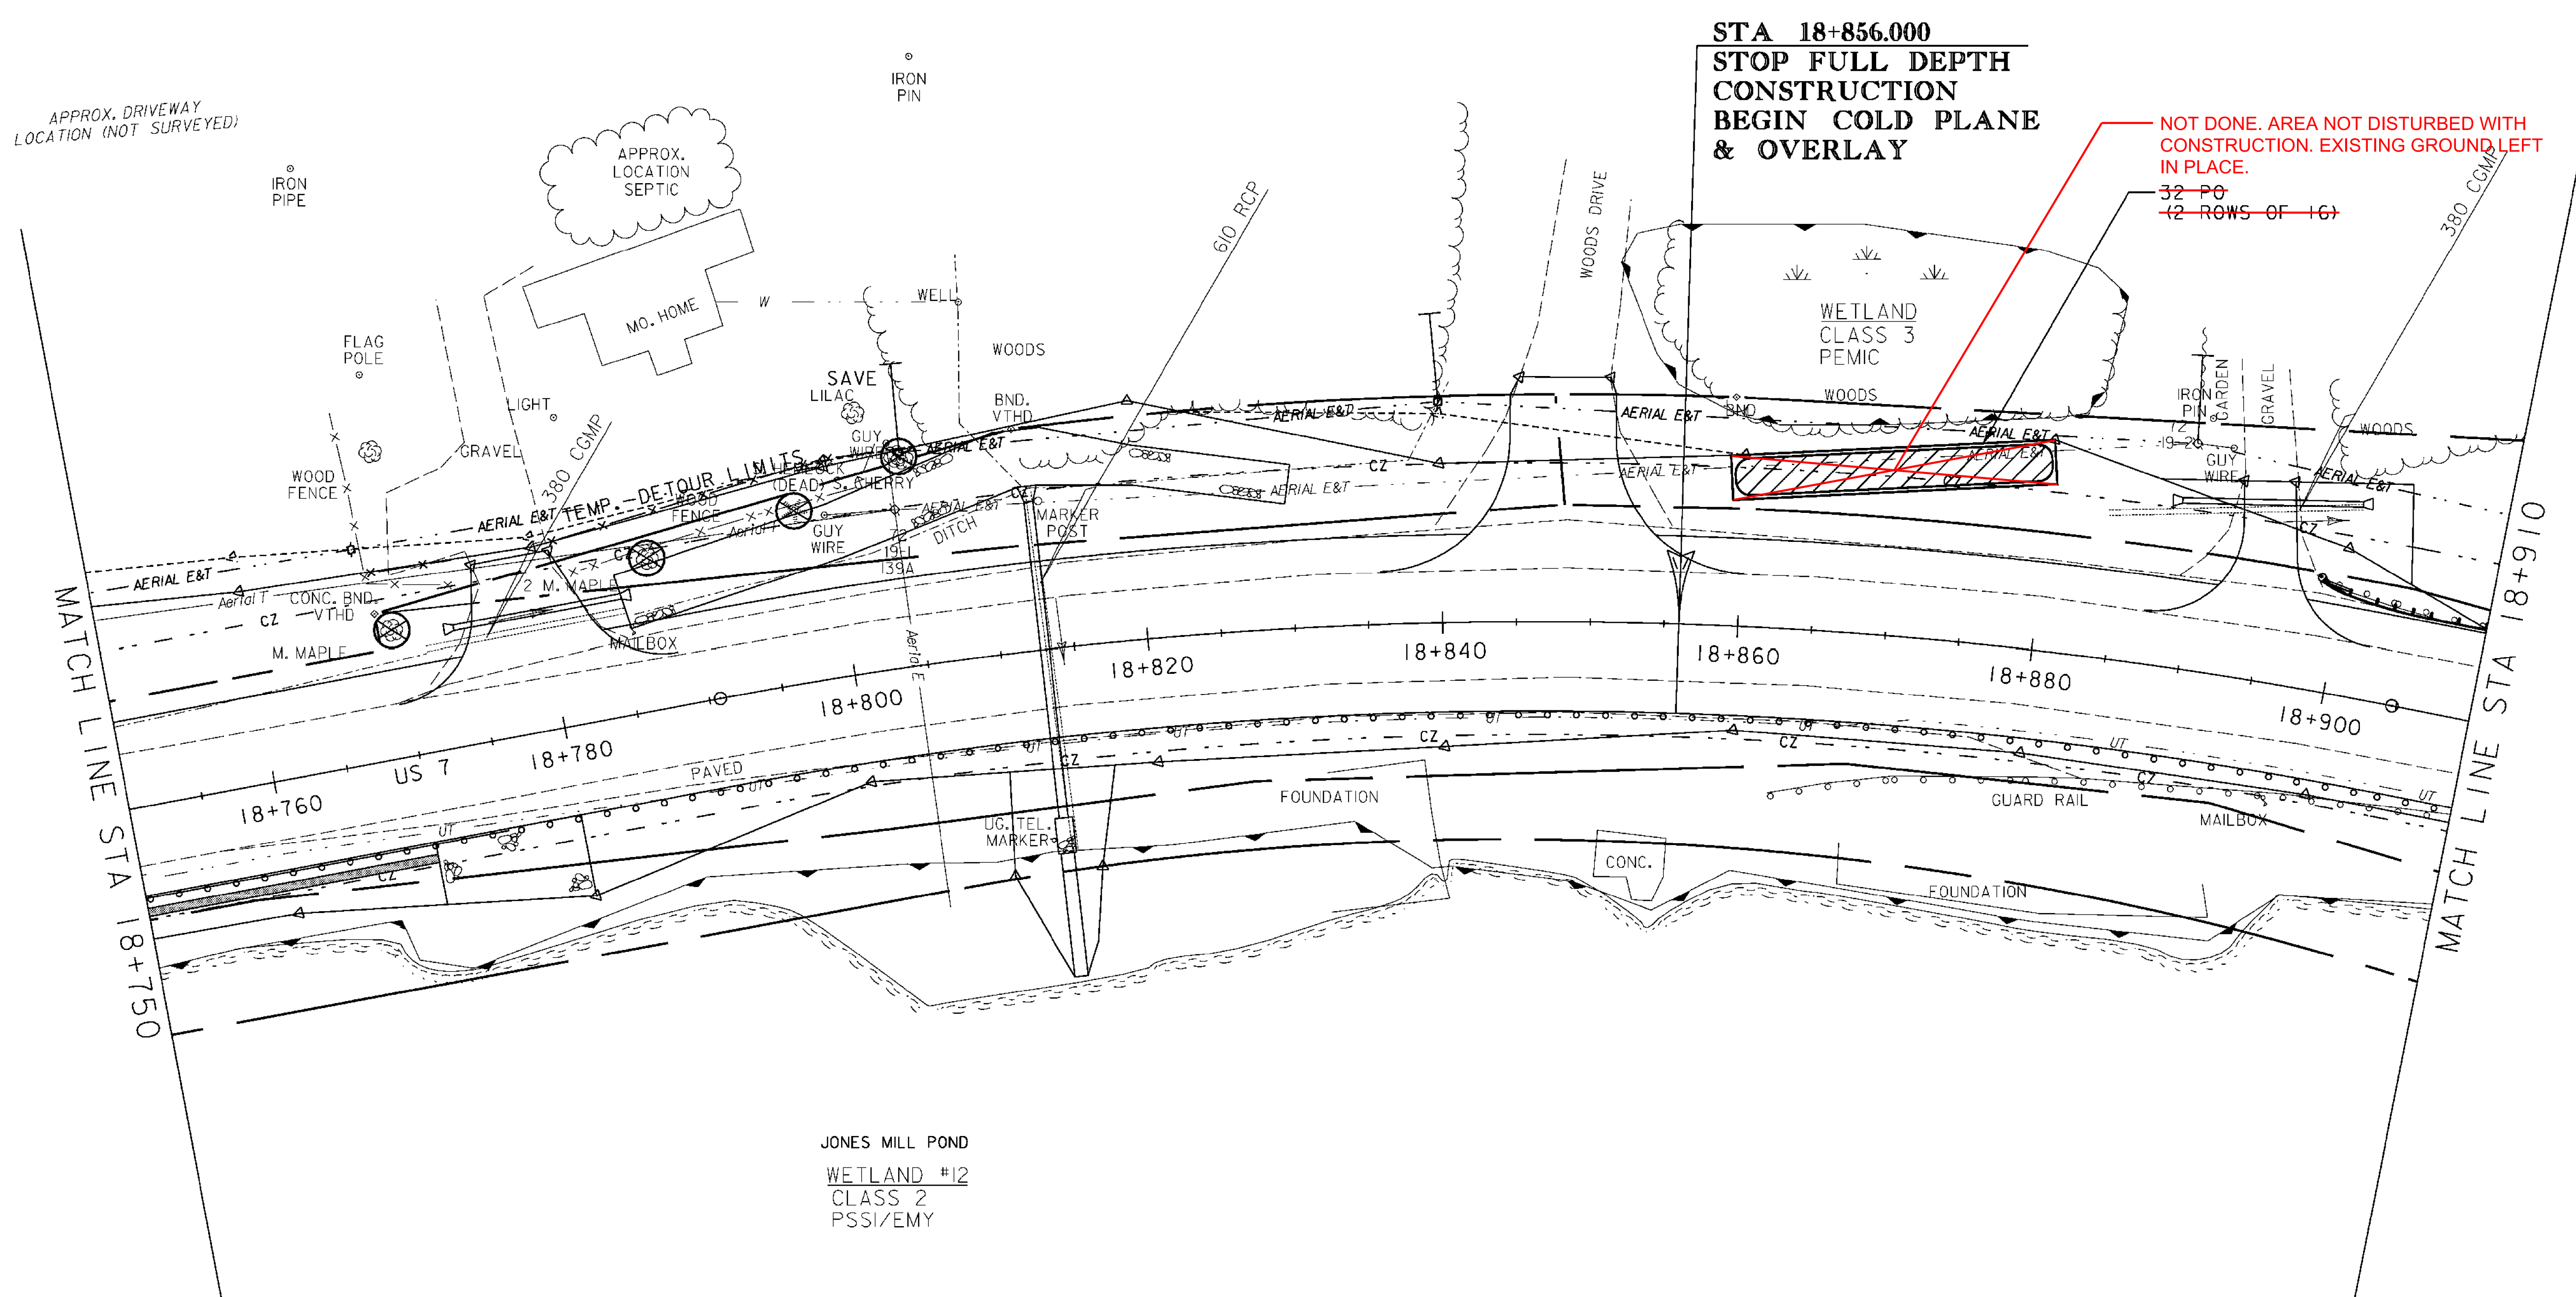


DECIDUOUS SHRUBS
STA 18+860 to 18+880 LT - 32 PO

LANDSCAPE BACKFILL, TRUCK MEASUREMENT
STA 18+860 TO 18+880 LT - 22 m x 3 m x 1 m

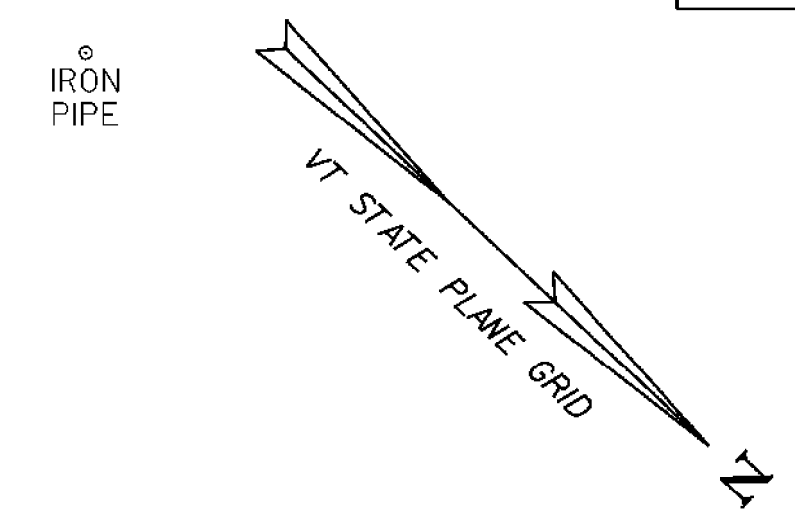

NOT DONE. AREA NOT DISTURBED WITH CONSTRUCTION. EXISTING GROUND LEFT IN PLACE.
32 PO
~~42 ROWS OF 16~~

LEGEND

- LOWER HEIGHT WOODY SHRUBS
- PROPOSED DECIDUOUS TREE
- PROPOSED CONIFEROUS TREE
- SAVE TREE / TREE PROTECTION ZONE WITH FENCING (TPZ)
- LIMIT OF CUT & FILL / GRASS SEEDING OF DISTURBED AREAS
- LANDSCAPE BACKFILL
- DENOTES TREE OR STUMP REMOVAL



LANDSCAPE PLAN 16

PROJECT NAME:	BRANDON	PLLOT DATE:	9/3/2009
PROJECT NUMBER:	NH 019-3(495)	DRAWN BY:	JCS
FILE NAME:	zb008s5-ldsc16.dgn	CHECKED BY:	VTRANS
PROJECT LEADER:	VTRANS	SHEET	228 OF 546
DESIGNED BY:	VTRANS		
CLD 02-0149			