
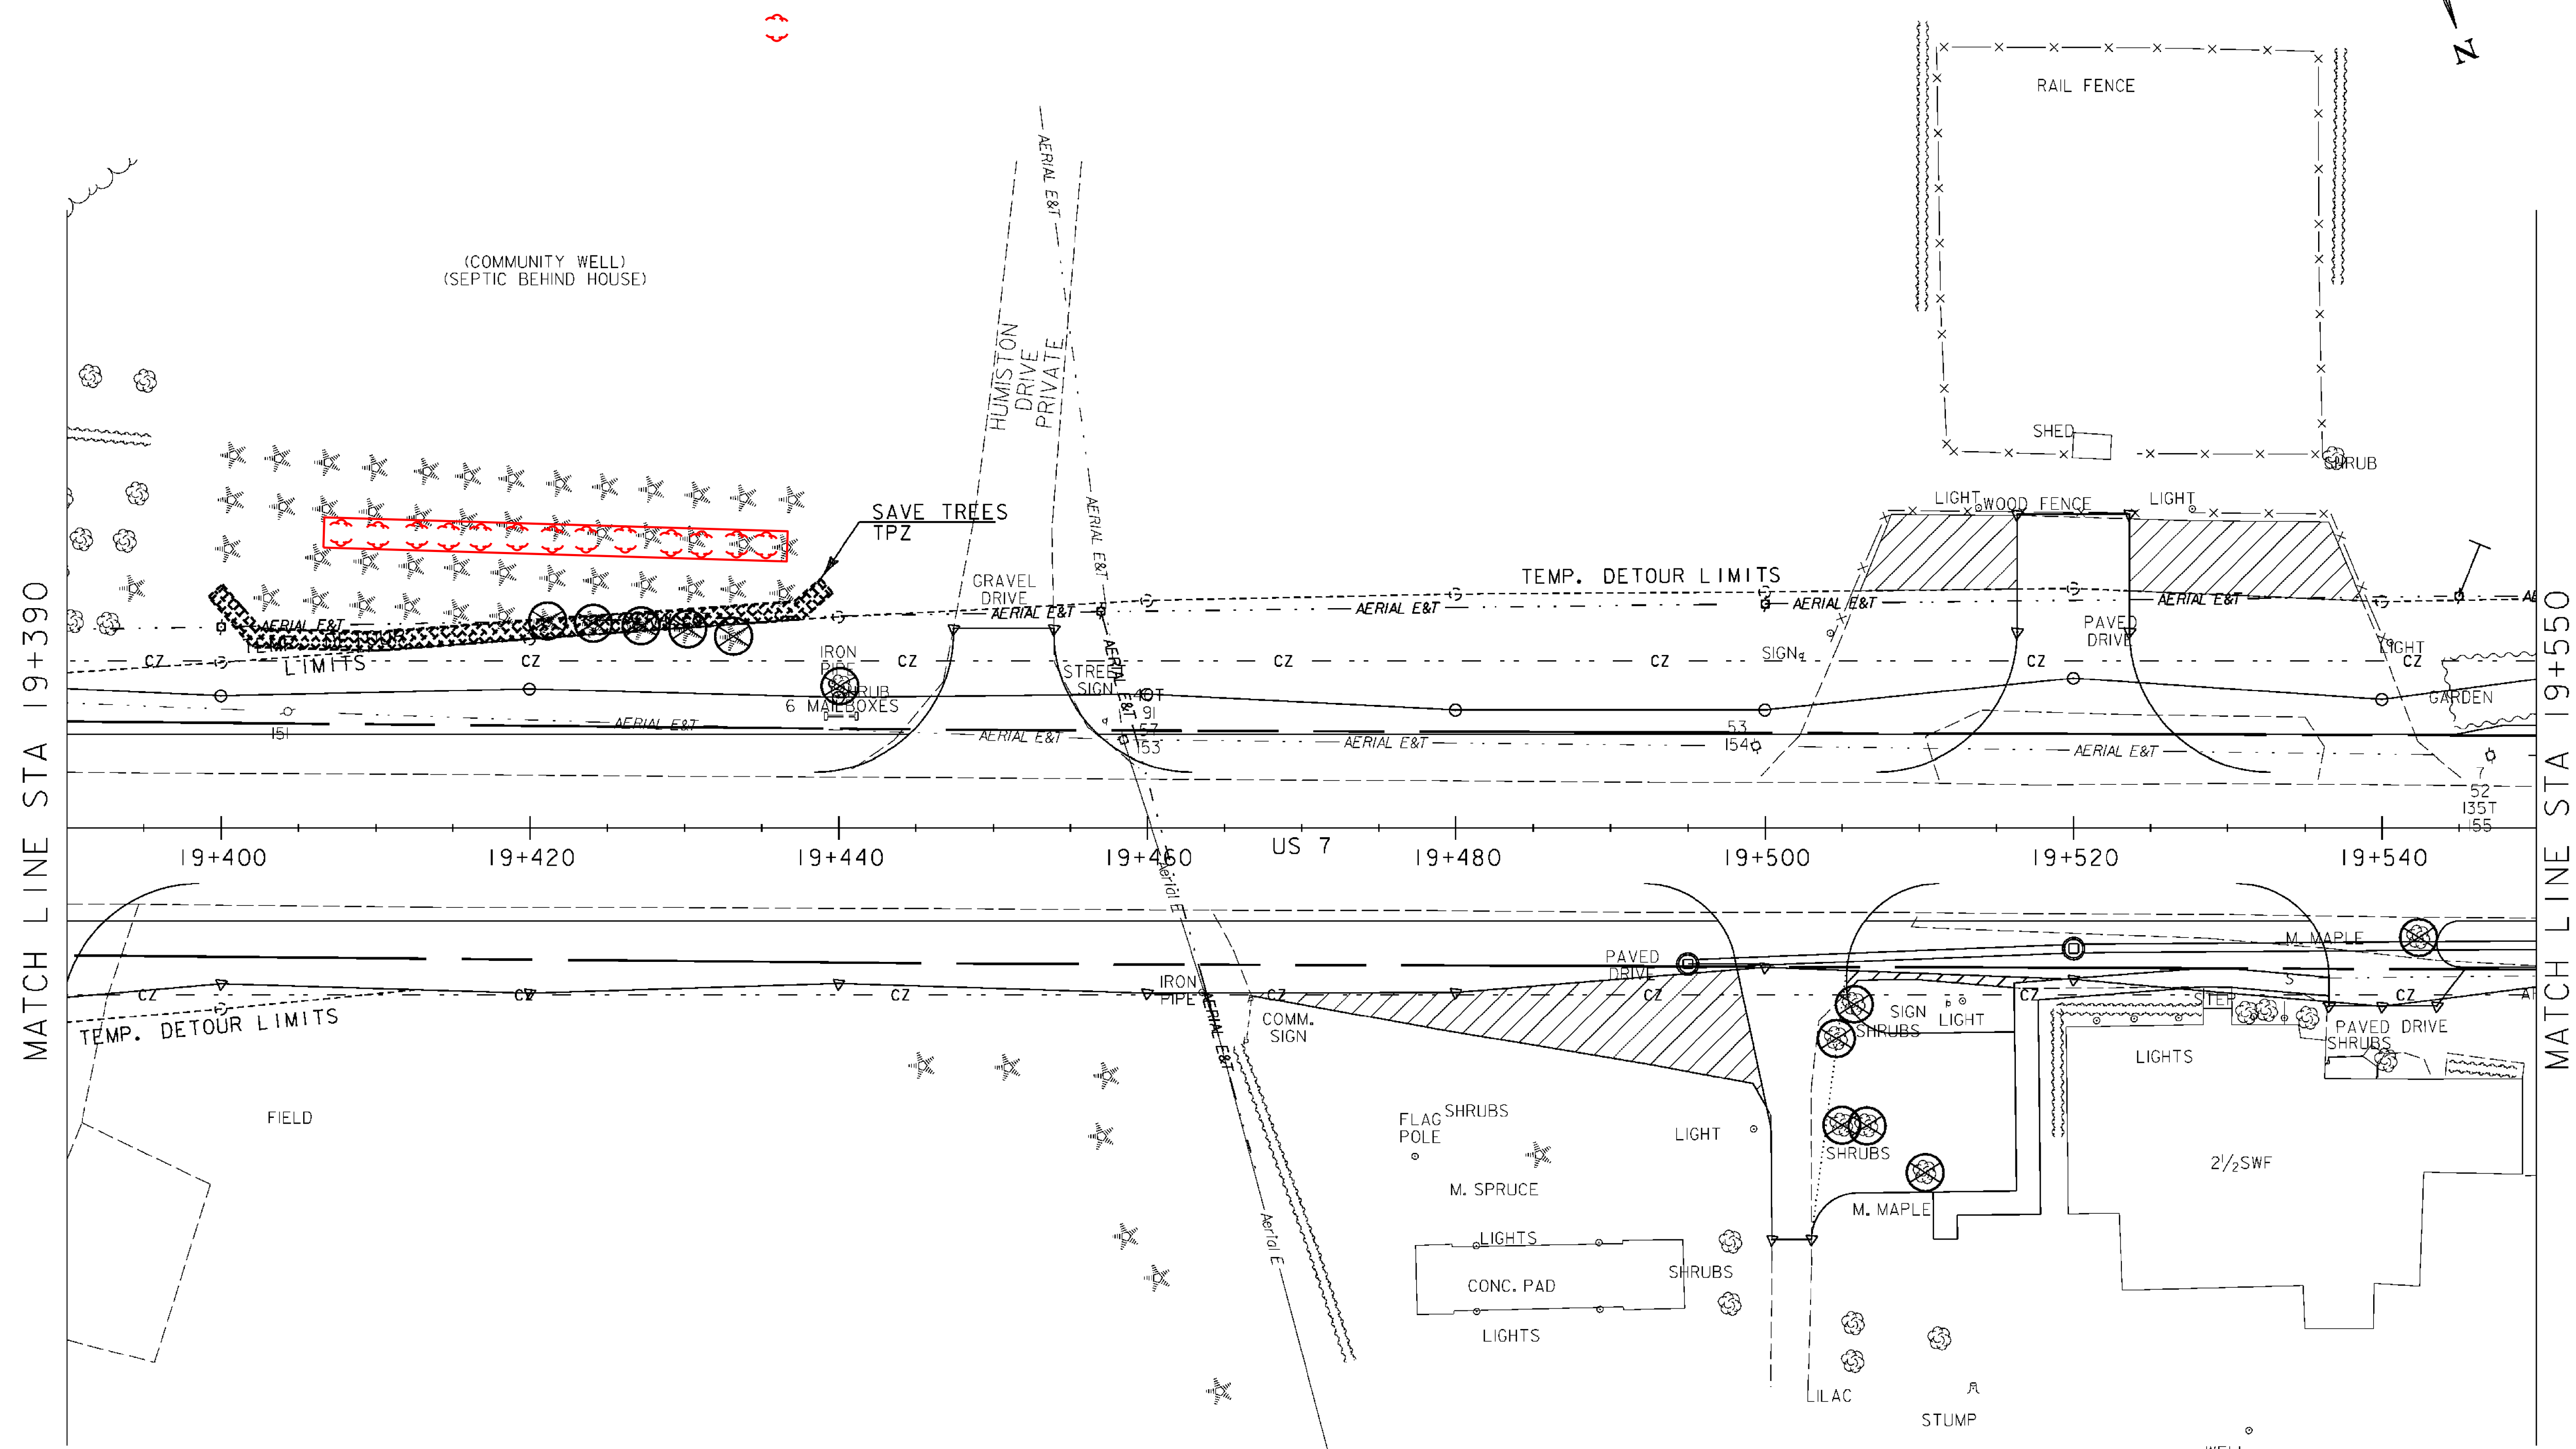
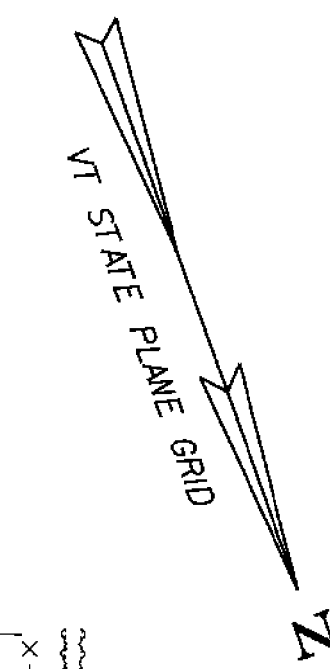



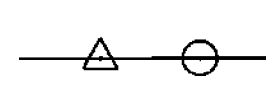
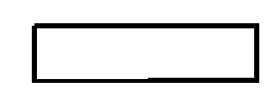



TREE PROTECTION
~~STA 19+399 TO 19+439 LT - 12 TREES~~

DECIDUOUS SHRUBS
 19+400 TO 19+420 LT - 13 - CRAB

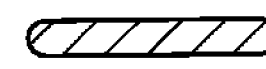

LEGEND

-  LOWER HEIGHT WOODY SHRUBS
-  PROPOSED DECIDUOUS TREE
-  PROPOSED CONIFEROUS TREE
-  SAVE TREE / TREE PROTECTION ZONE WITH FENCING (TPZ)
-  LIMIT OF CUT & FILL / GRASS SEEDING OF DISTURBED AREAS
-  LANDSCAPE BACKFILL
-  DENOTES TREE OR STUMP REMOVAL



LANDSCAPE PLAN 20

PROJECT NAME:	BRANDON	FILE NAME:	zb008s5-ldsc20.dgn	PLOT DATE:	9/3/2009
PROJECT NUMBER:	NH 019-3(495)	PROJECT LEADER:	VTRANS	DRAWN BY:	JCS
		DESIGNED BY:	VTRANS	CHECKED BY:	VTRANS
		CLD 02-0149		SHEET	232 OF 546