


DECIDUOUS TREES  
 STA 20+193 LT - 1 AF  
 LANDSCAPE BACKFILL, TRUCK MEASUREMENT  
 STA 20+190 to 20+196 LT - 6 m x 3 m x 1 m

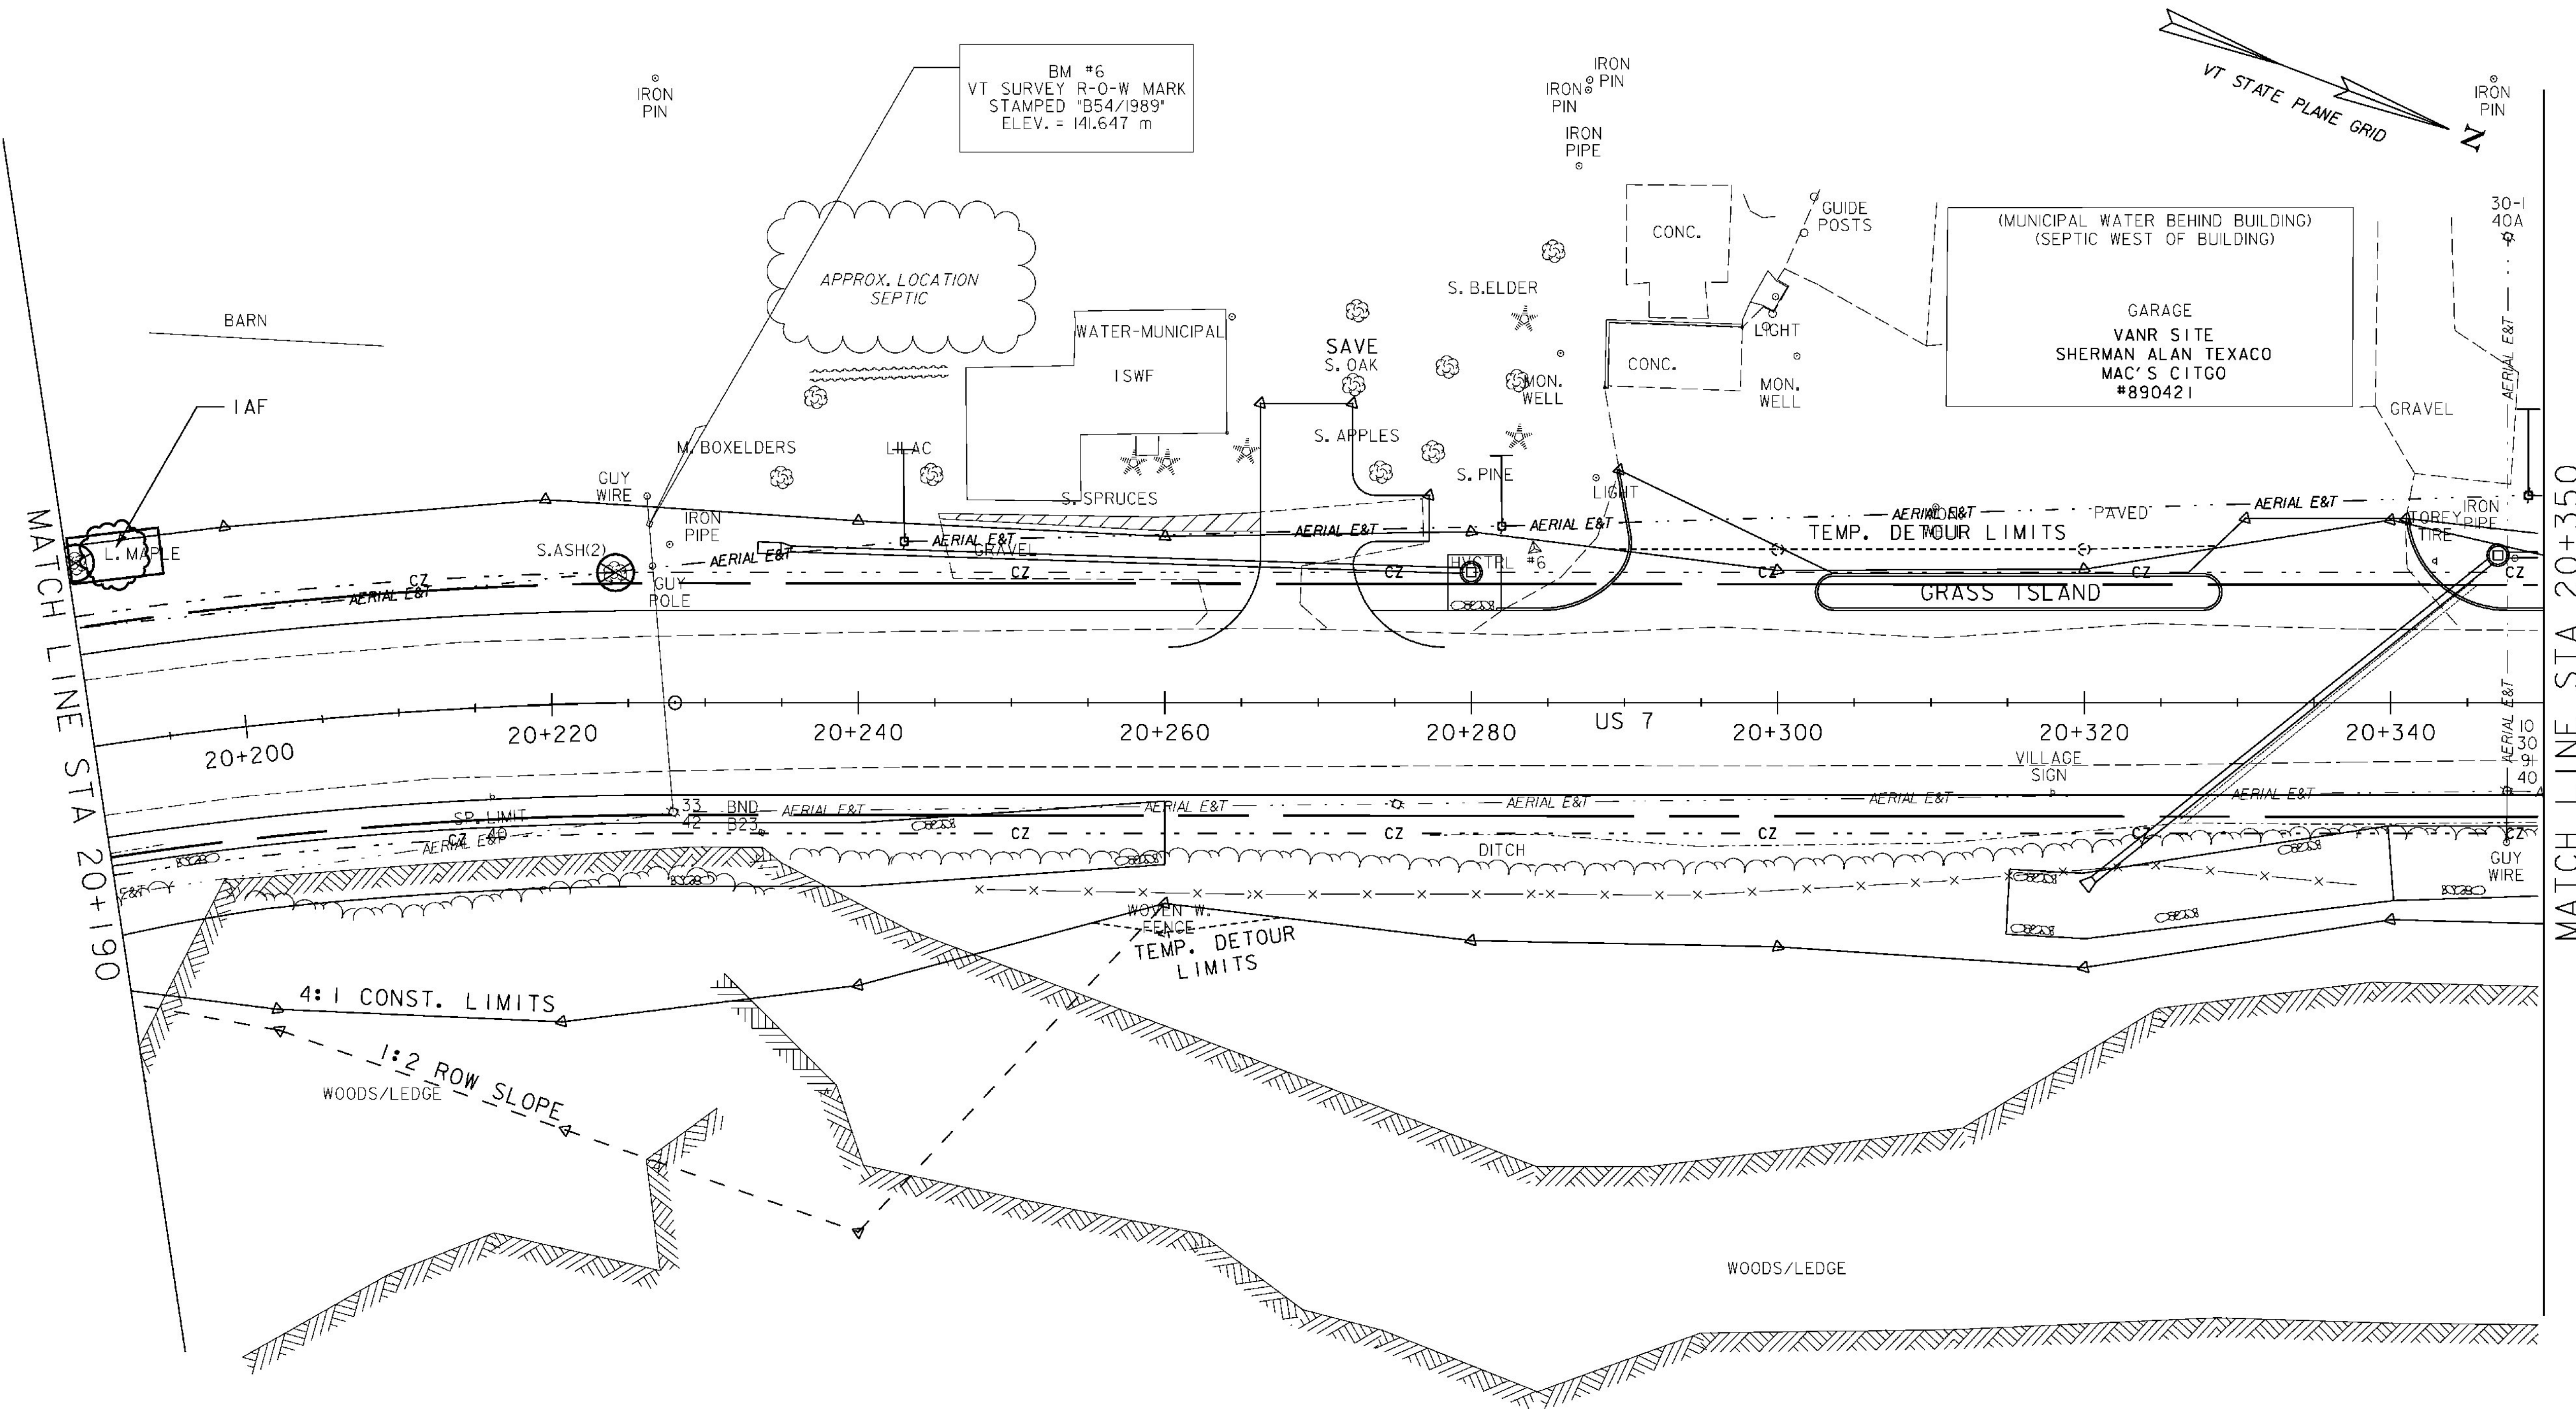

**LEGEND**

- LOWER HEIGHT WOODY SHRUBS
- PROPOSED DECIDUOUS TREE
- PROPOSED CONIFEROUS TREE
- SAVE TREE / TREE PROTECTION ZONE WITH FENCING (TPZ)
- LIMIT OF CUT & FILL / GRASS SEEDING OF DISTURBED AREAS
- LANDSCAPE BACKFILL
- DENOTES TREE OR STUMP REMOVAL



**LANDSCAPE PLAN 25**

PROJECT NAME:	BRANDON	PLOT DATE:	9/3/2009
PROJECT NUMBER:	NH 019-3(495)	DRAWN BY:	JCS
FILE NAME:	zb008s5-ldsc25.dgn	CHECKED BY:	VTRANS
PROJECT LEADER:	VTRANS	SHEET	237 OF 546
DESIGNED BY:	VTRANS		
CLD 02-0149			