


TEMPORARY 100mm WHITE LINE, PAINT
 DURABLE 100mm WHITE LINE, THERMOPLASTIC
 STA 17+170 TO 17+330 SOLID LT & RT

TEMPORARY 100mm YELLOW LINE, PAINT
 DURABLE 100mm YELLOW LINE, THERMOPLASTIC
 STA 17+170 TO 17+330 SOLID LT & RT

REMOVING SIGNS
 AS SHOWN - 2

SIGN LEGEND

R = REMOVE
 S = SALVAGE
 N = NEW
 RET = RETAIN
 T&T = THINNING & TRIMMING
 B-B = BACK TO BACK
 EXISTING
 NEW

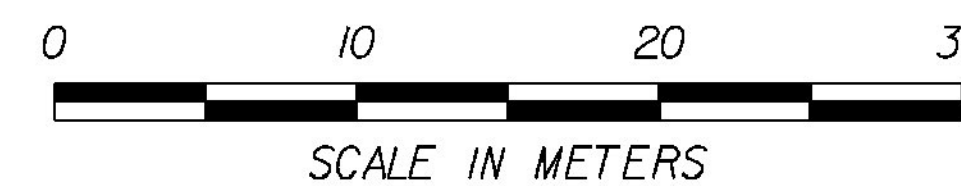

SIGNING & PAVEMENT MARKING 6

PROJECT NAME:	BRANDON	PLOT DATE:	9/3/2009
PROJECT NUMBER:	NH 019-3(495)	DRAWN BY:	HJC
FILE NAME:	zb008s5-+s06.dgn	CHECKED BY:	PTS
PROJECT LEADER:	CRB	SHEET	247 OF 546
DESIGNED BY:	NLL		
CLD 02-0149			