


- SIGN LEGEND**
- R = REMOVE
 - S = SALVAGE
 - N = NEW
 - RET = RETAIN
 - T&T = THINNING & TRIMMING
 - B-B = BACK TO BACK
 - EXISTING = EXISTING
 - NEW = NEW

- TEMPORARY 100mm WHITE LINE, PAINT
DURABLE 100mm WHITE LINE, THERMOPLASTIC
- STA 17+490 TO 17+650 SOLID LT
 - STA 17+490 TO 17+541 SOLID RT
 - STA 17+490 TO 17+545 SOLID RT (LANE LINE)
 - STA 17+564 TO 17+650 SOLID RT
 - STA 1+008 TO 1+068 SOLID LT & RT (McCONNELL ROAD)
- TEMPORARY 100mm YELLOW LINE, PAINT
DURABLE 100mm YELLOW LINE, THERMOPLASTIC
- STA 17+490 TO 17+550 SOLID LT & RT
 - STA 17+562 TO 17+650 SOLID LT & RT
 - STA 1+007 TO 1+068 SOLID LT & RT (McCONNELL ROAD)
 - STA 1+034 TO 1+048 SOLID LT & RT (McCONNELL ROAD)
- DURABLE 200mm YELLOW LINE, THERMOPLASTIC
- STA 1+034 TO 1+048 SOLID (DIAG LINES)

- TEMPORARY 600mm STOP BAR, PAINT
DURABLE 600mm STOP BAR, THERMOPLASTIC
- STA 1+008 LT (McCONNELL ROAD)
- LIMIT OF WORK**
STA 1+068.000
- DURABLE LETTER OR SYMBOL, THERMOPLASTIC
- STA 17+505 RT - "ONLY"
 - STA 17+525 RT - RIGHT TURN ARROW
 - STA 1+011 LT - "STOP" (McCONNELL ROAD)
- TEMPORARY LETTER OR SYMBOL, PAINT
- STA 17+525 RT - RIGHT TURN ARROW
 - STA 1+011 LT - "STOP" (McCONNELL ROAD)
- PAINTED CURB
- STA 1+007 - 1+016 LT & RT (McCONNELL ROAD)

- REMOVING SIGNS
AS SHOWN - 14
- ERECTING SALVAGED SIGNS
AS SHOWN - 3
- SETTING SALVAGED POSTS
AS SHOWN - 1

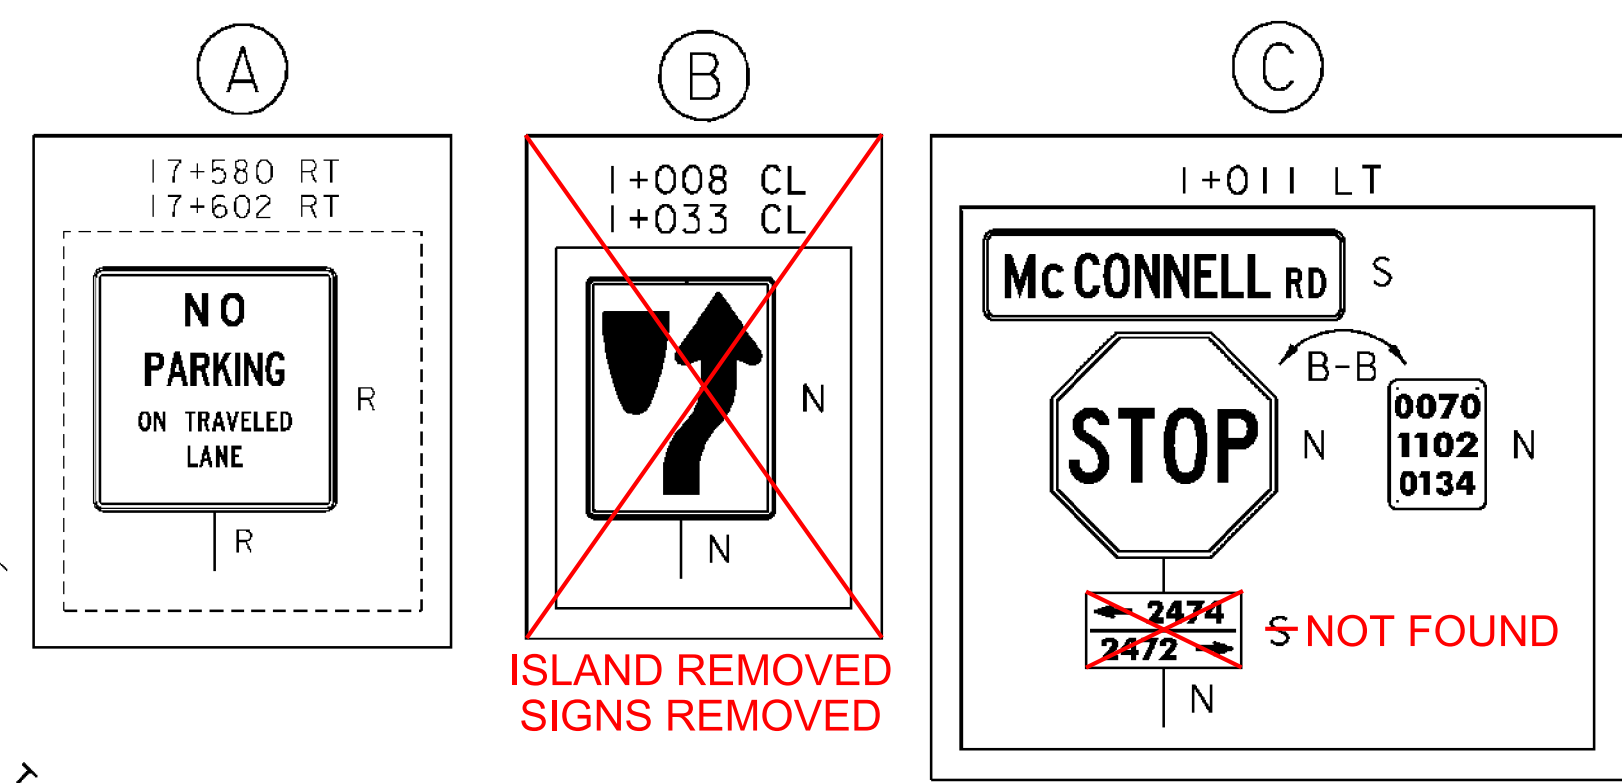

SIGNING & PAVEMENT MARKING 8

PROJECT NAME:	BRANDON	PLOT DATE:	9/3/2009
PROJECT NUMBER:	NH 019-3(495)	DRAWN BY:	HJC
FILE NAME:	zb008s5-ts08.dgn	DESIGNED BY:	NLL
PROJECT LEADER:	CRB	CHECKED BY:	PTS
CLD 02-049		SHEET	249 OF 546