

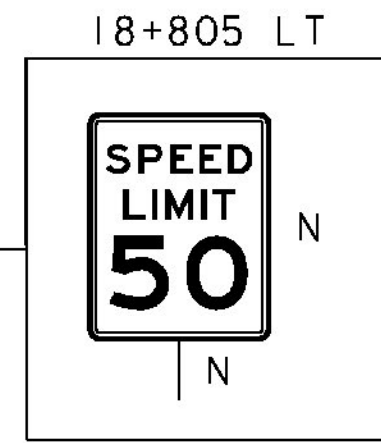


TEMPORARY 100mm WHITE LINE, PAINT
 DURABLE 100mm WHITE LINE, THERMOPLASTIC
 STA 18+750 TO 18+910 SOLID LT & RT

TEMPORARY 100mm YELLOW LINE, PAINT
 DURABLE 100mm YELLOW LINE, THERMOPLASTIC
 STA 18+750 TO 18+865 DASHED LT, SOLID RT
 STA 18+865 TO 18+910 SOLID LT & RT

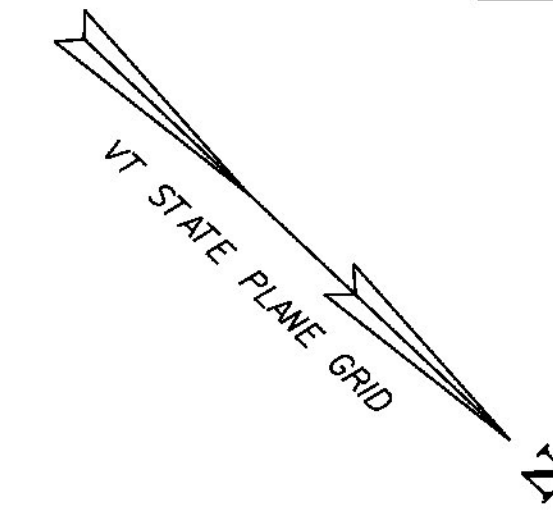

STA 18+856.000
 STOP FULL DEPTH
 CONSTRUCTION
 BEGIN COLD PLANE
 & OVERLAY

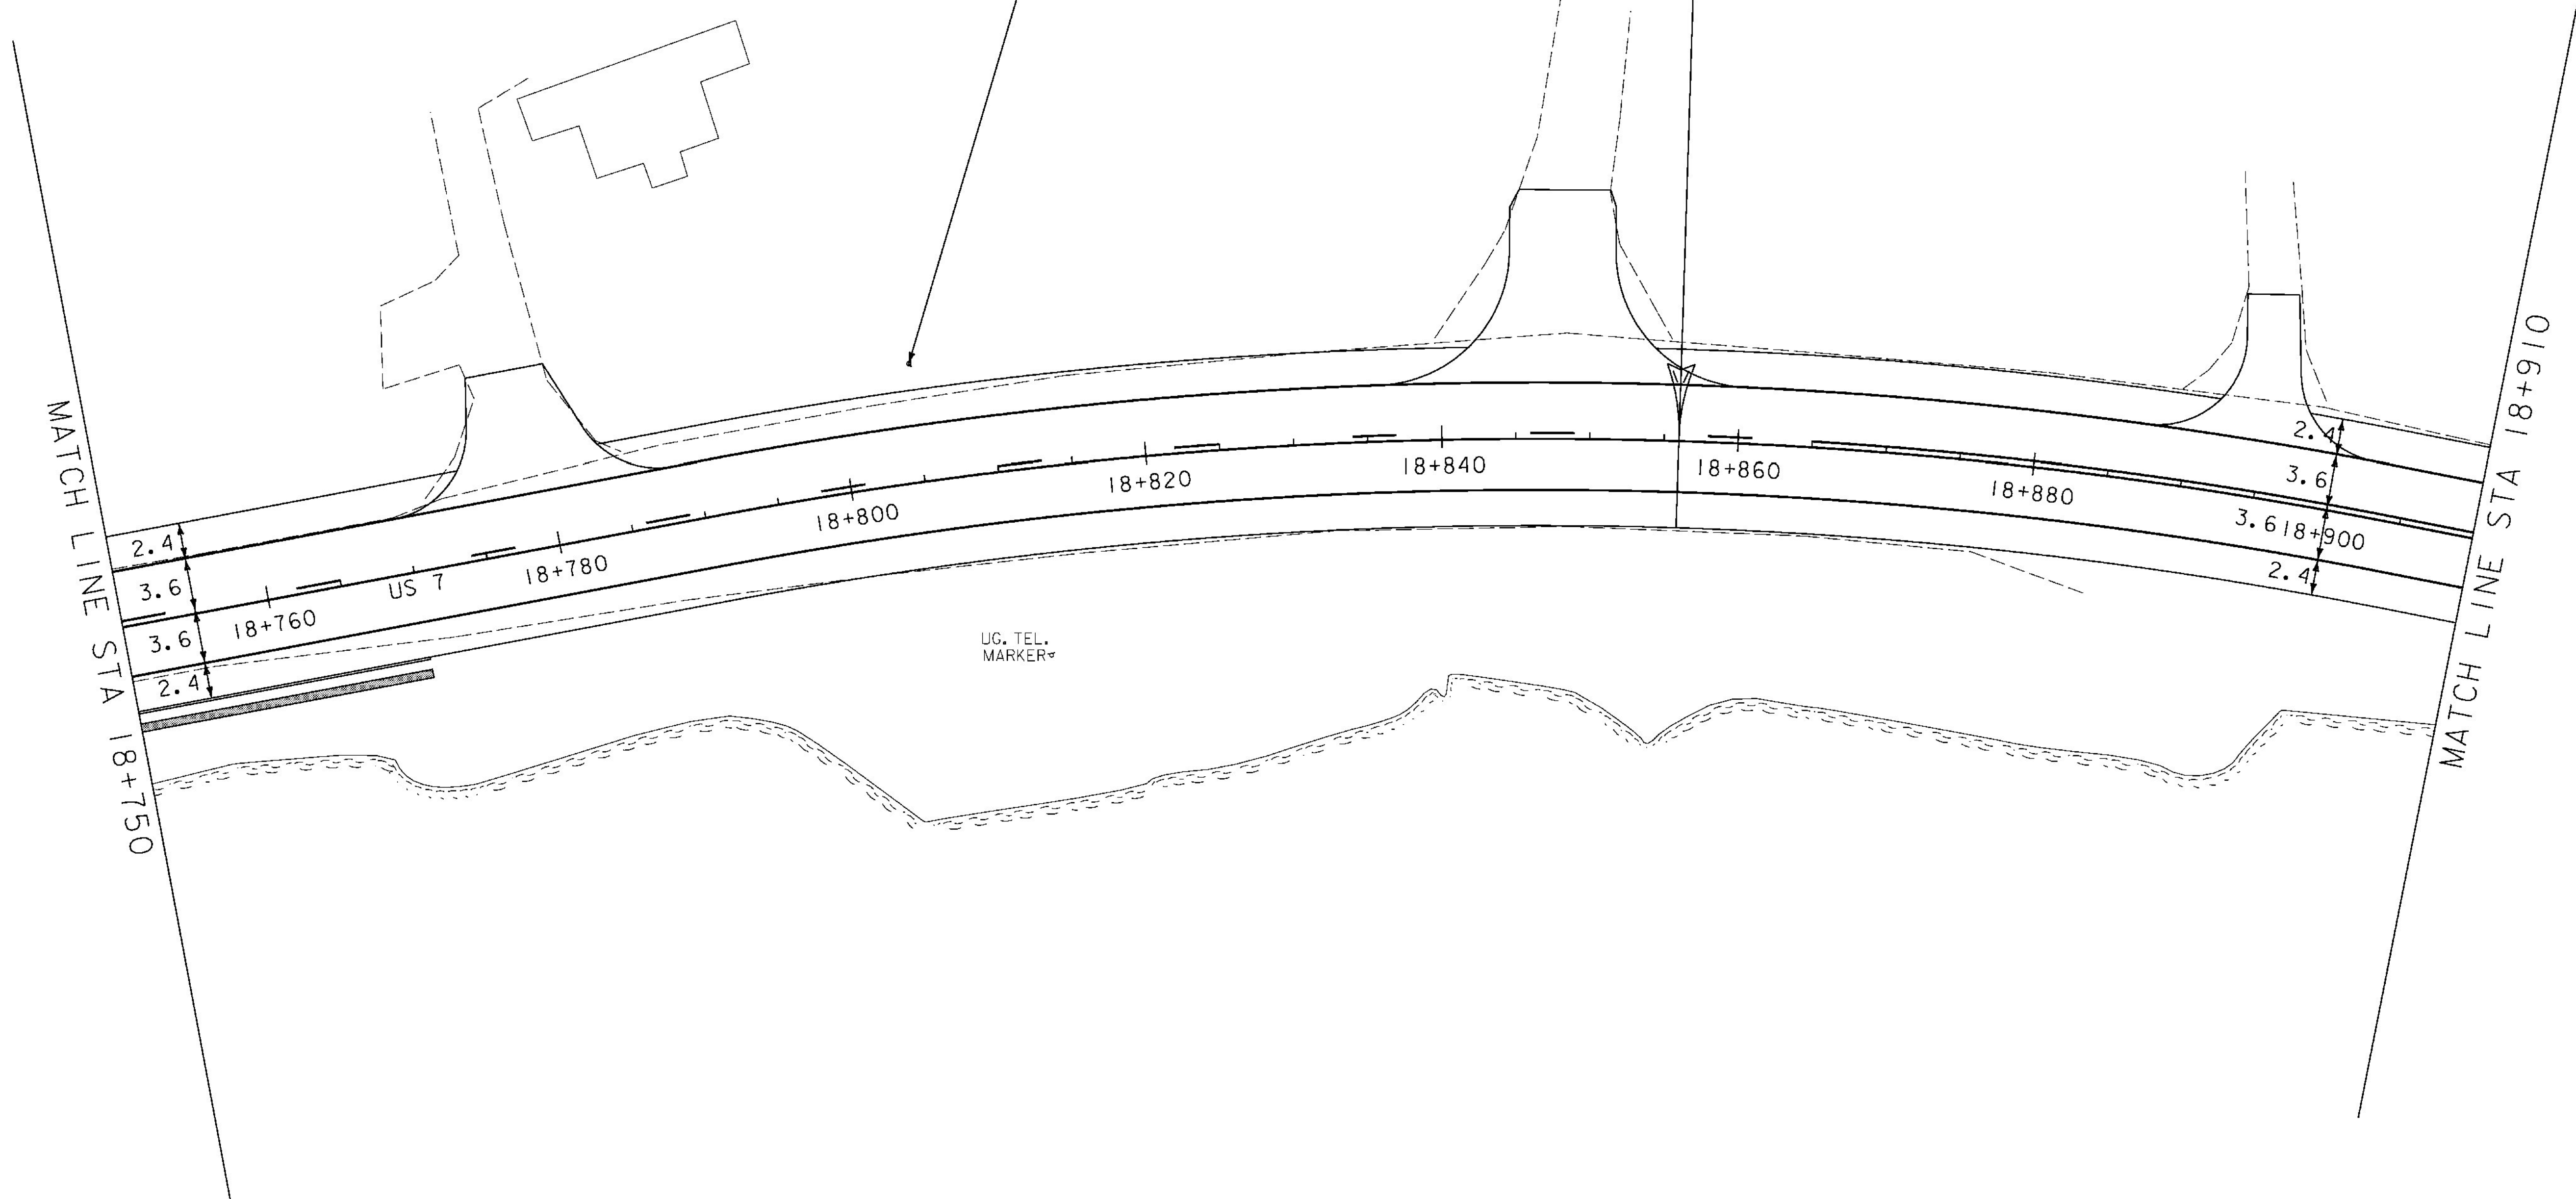

SIGN LEGEND

- R = REMOVE
- S = SALVAGE
- N = NEW
- RET = RETAIN
- T&T = THINNING & TRIMMING
- B-B = BACK TO BACK
- EXISTING -----
- NEW _____



SIGNING & PAVEMENT MARKING 16

PROJECT NAME: BRANDON	PLOT DATE: 9/3/2009
PROJECT NUMBER: NH 019-3(495)	DRAWN BY: HJC
FILE NAME: zb008s5-+sl6.dgn	CHECKED BY: PTS
PROJECT LEADER: CRB	SHEET 257 OF 546
DESIGNED BY: NULL	
CLD 02-0149	