



TEMPORARY 100mm WHITE LINE, PAINT
 DURABLE 100mm WHITE LINE, THERMOPLASTIC
 STA 19+230 TO 19+390 SOLID LT & RT

TEMPORARY 100mm YELLOW LINE, PAINT
 DURABLE 100mm YELLOW LINE, THERMOPLASTIC
 STA 19+230 TO 19+290 SOLID LT & RT
 STA 19+290 TO 19+390 SOLID LT, DASHED RT

REMOVING SIGNS
 AS SHOWN - I

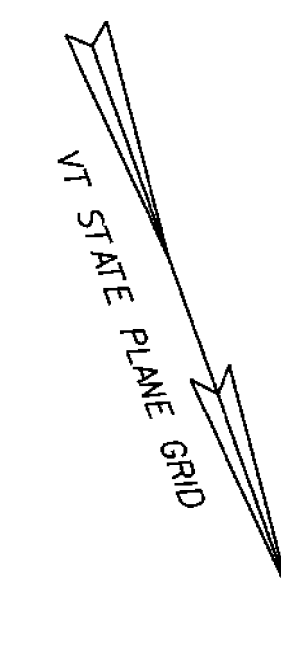

STA 19+234.000
END COLD PLANE
& OVERLAY
RESUME FULL DEPTH
CONSTRUCTION

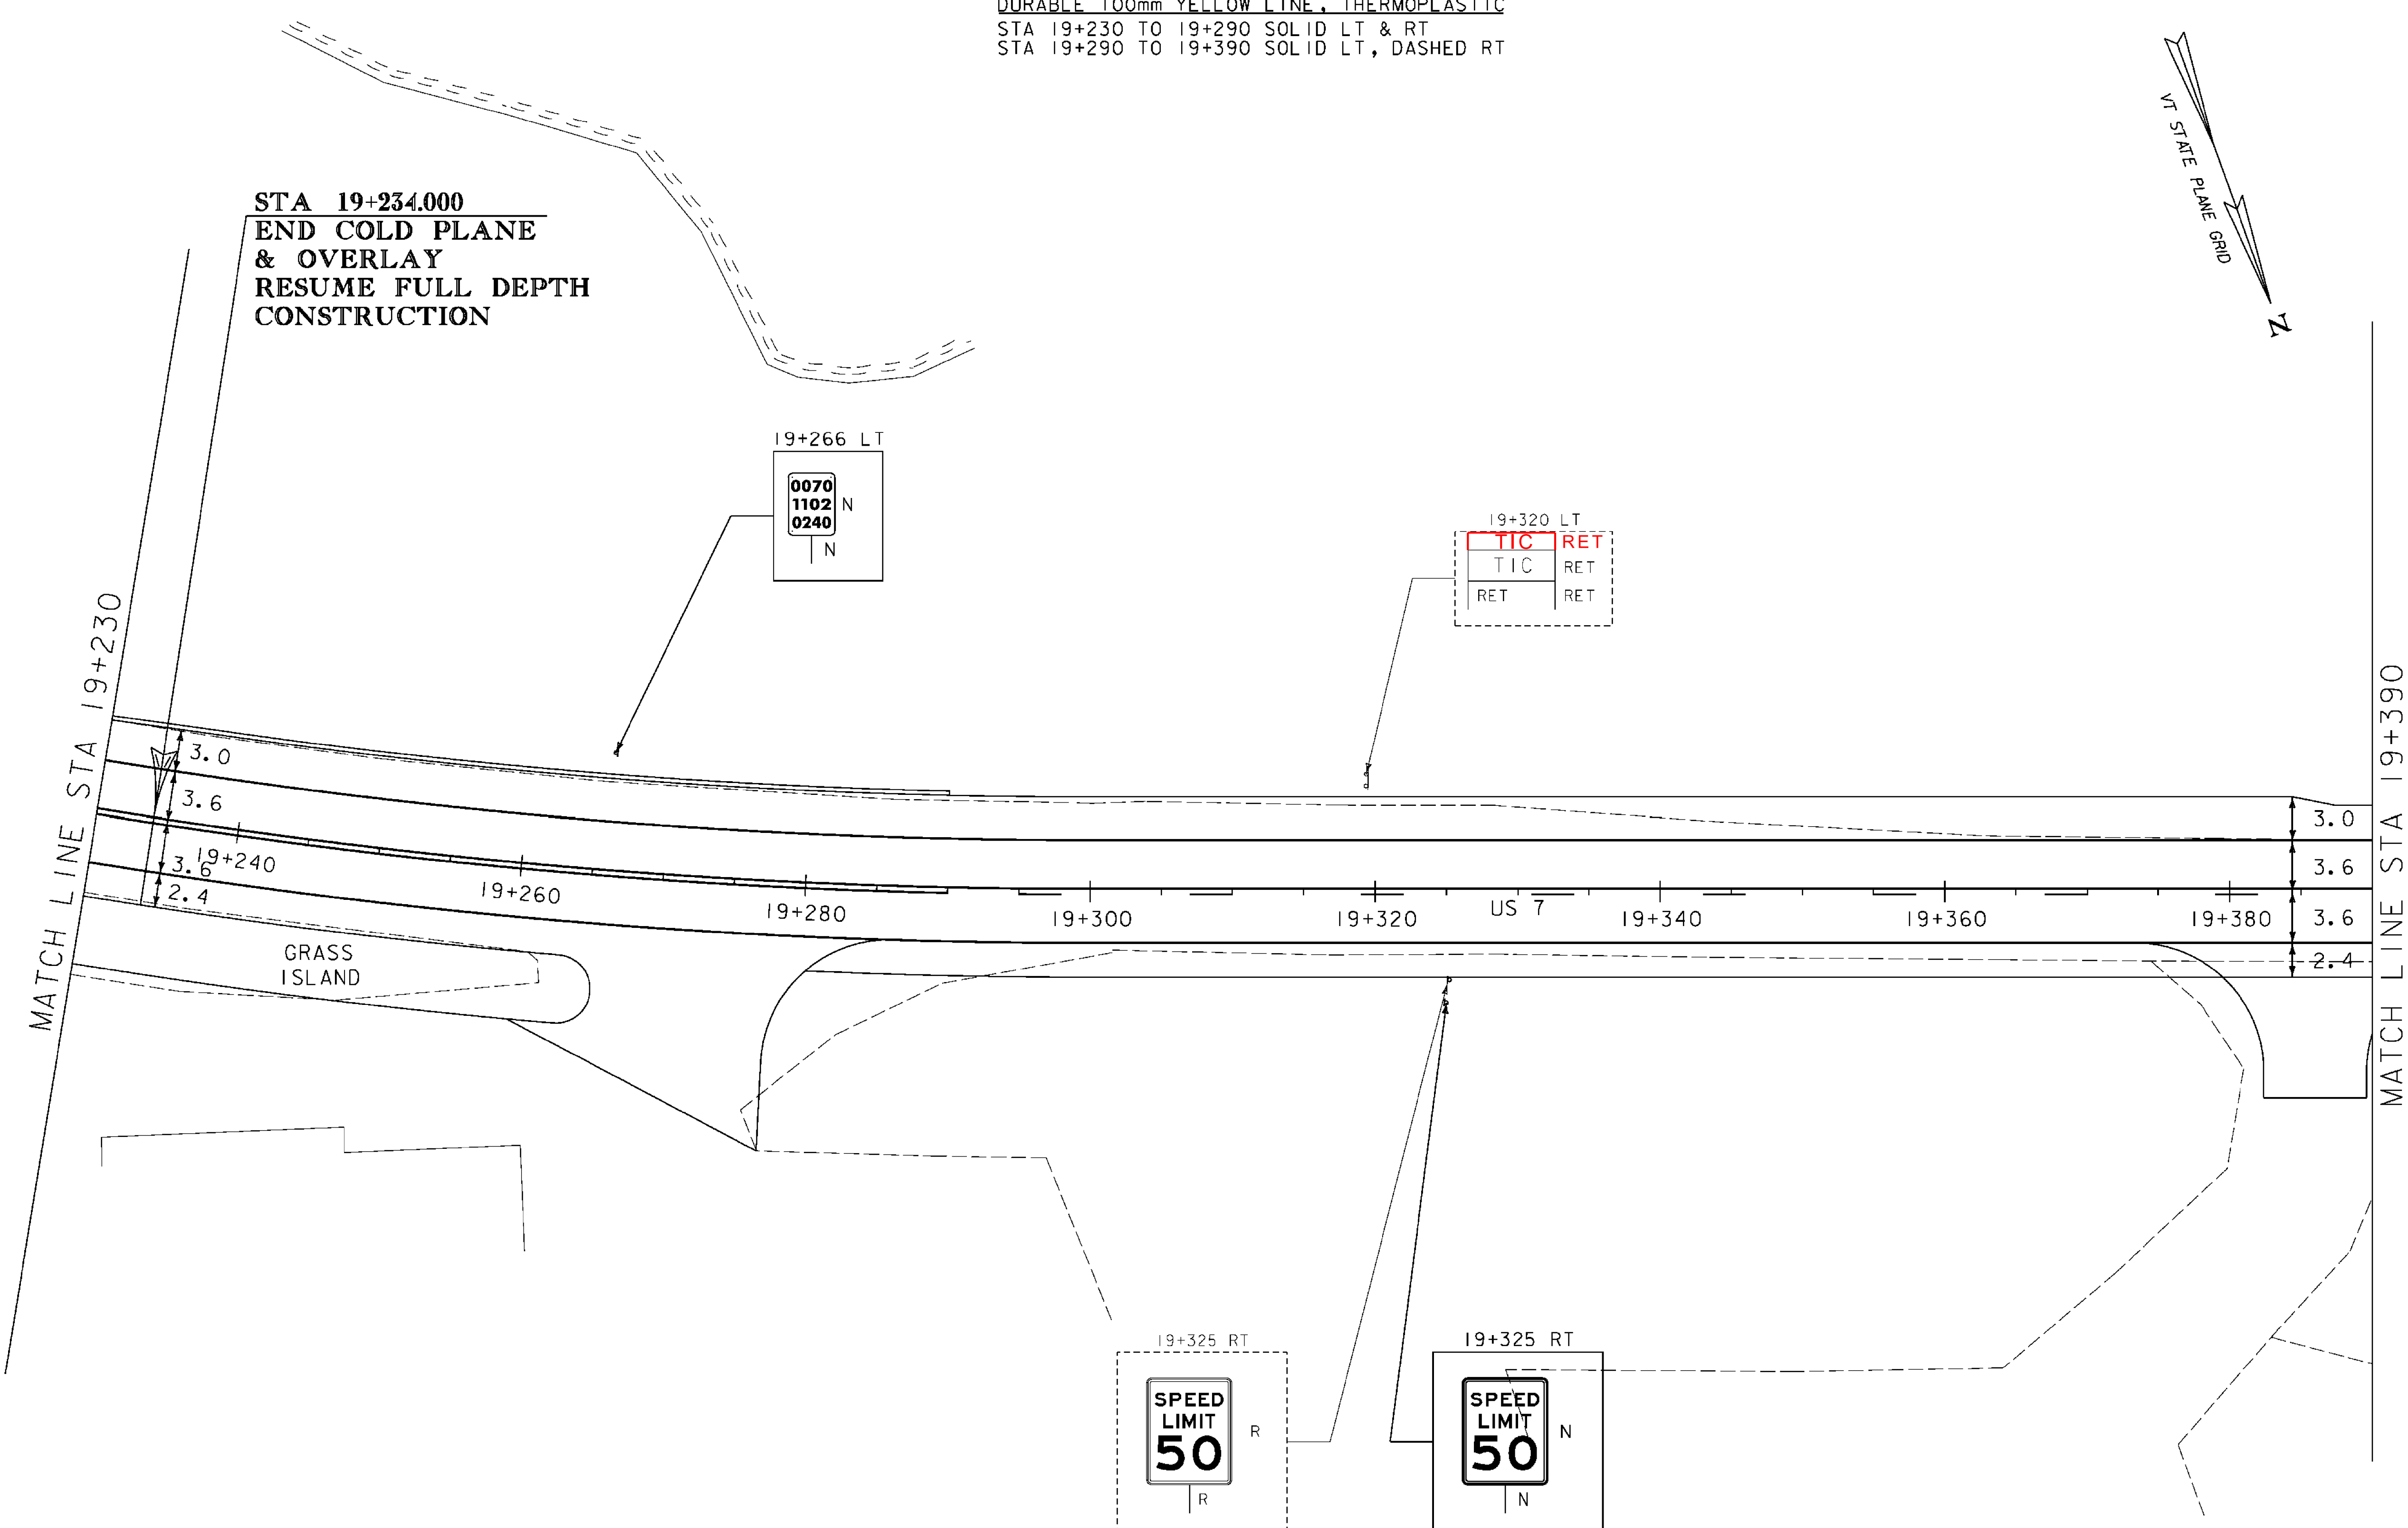

SIGN LEGEND

R = REMOVE
 S = SALVAGE
 N = NEW
 RET = RETAIN
 T&T = THINNING & TRIMMING
 B-B = BACK TO BACK
 EXISTING - - - - -
 NEW _____



SIGNING & PAVEMENT MARKING 19

PROJECT NAME: BRANDON
 PROJECT NUMBER: NH 019-3(495)

FILE NAME: zb008s5-tsl9.dgn
 PROJECT LEADER: CRB
 DESIGNED BY: NULL
 CLD 02-019

PLOT DATE: 9/3/2009
 DRAWN BY: HJC
 CHECKED BY: PTS
 SHEET 260 OF 546