
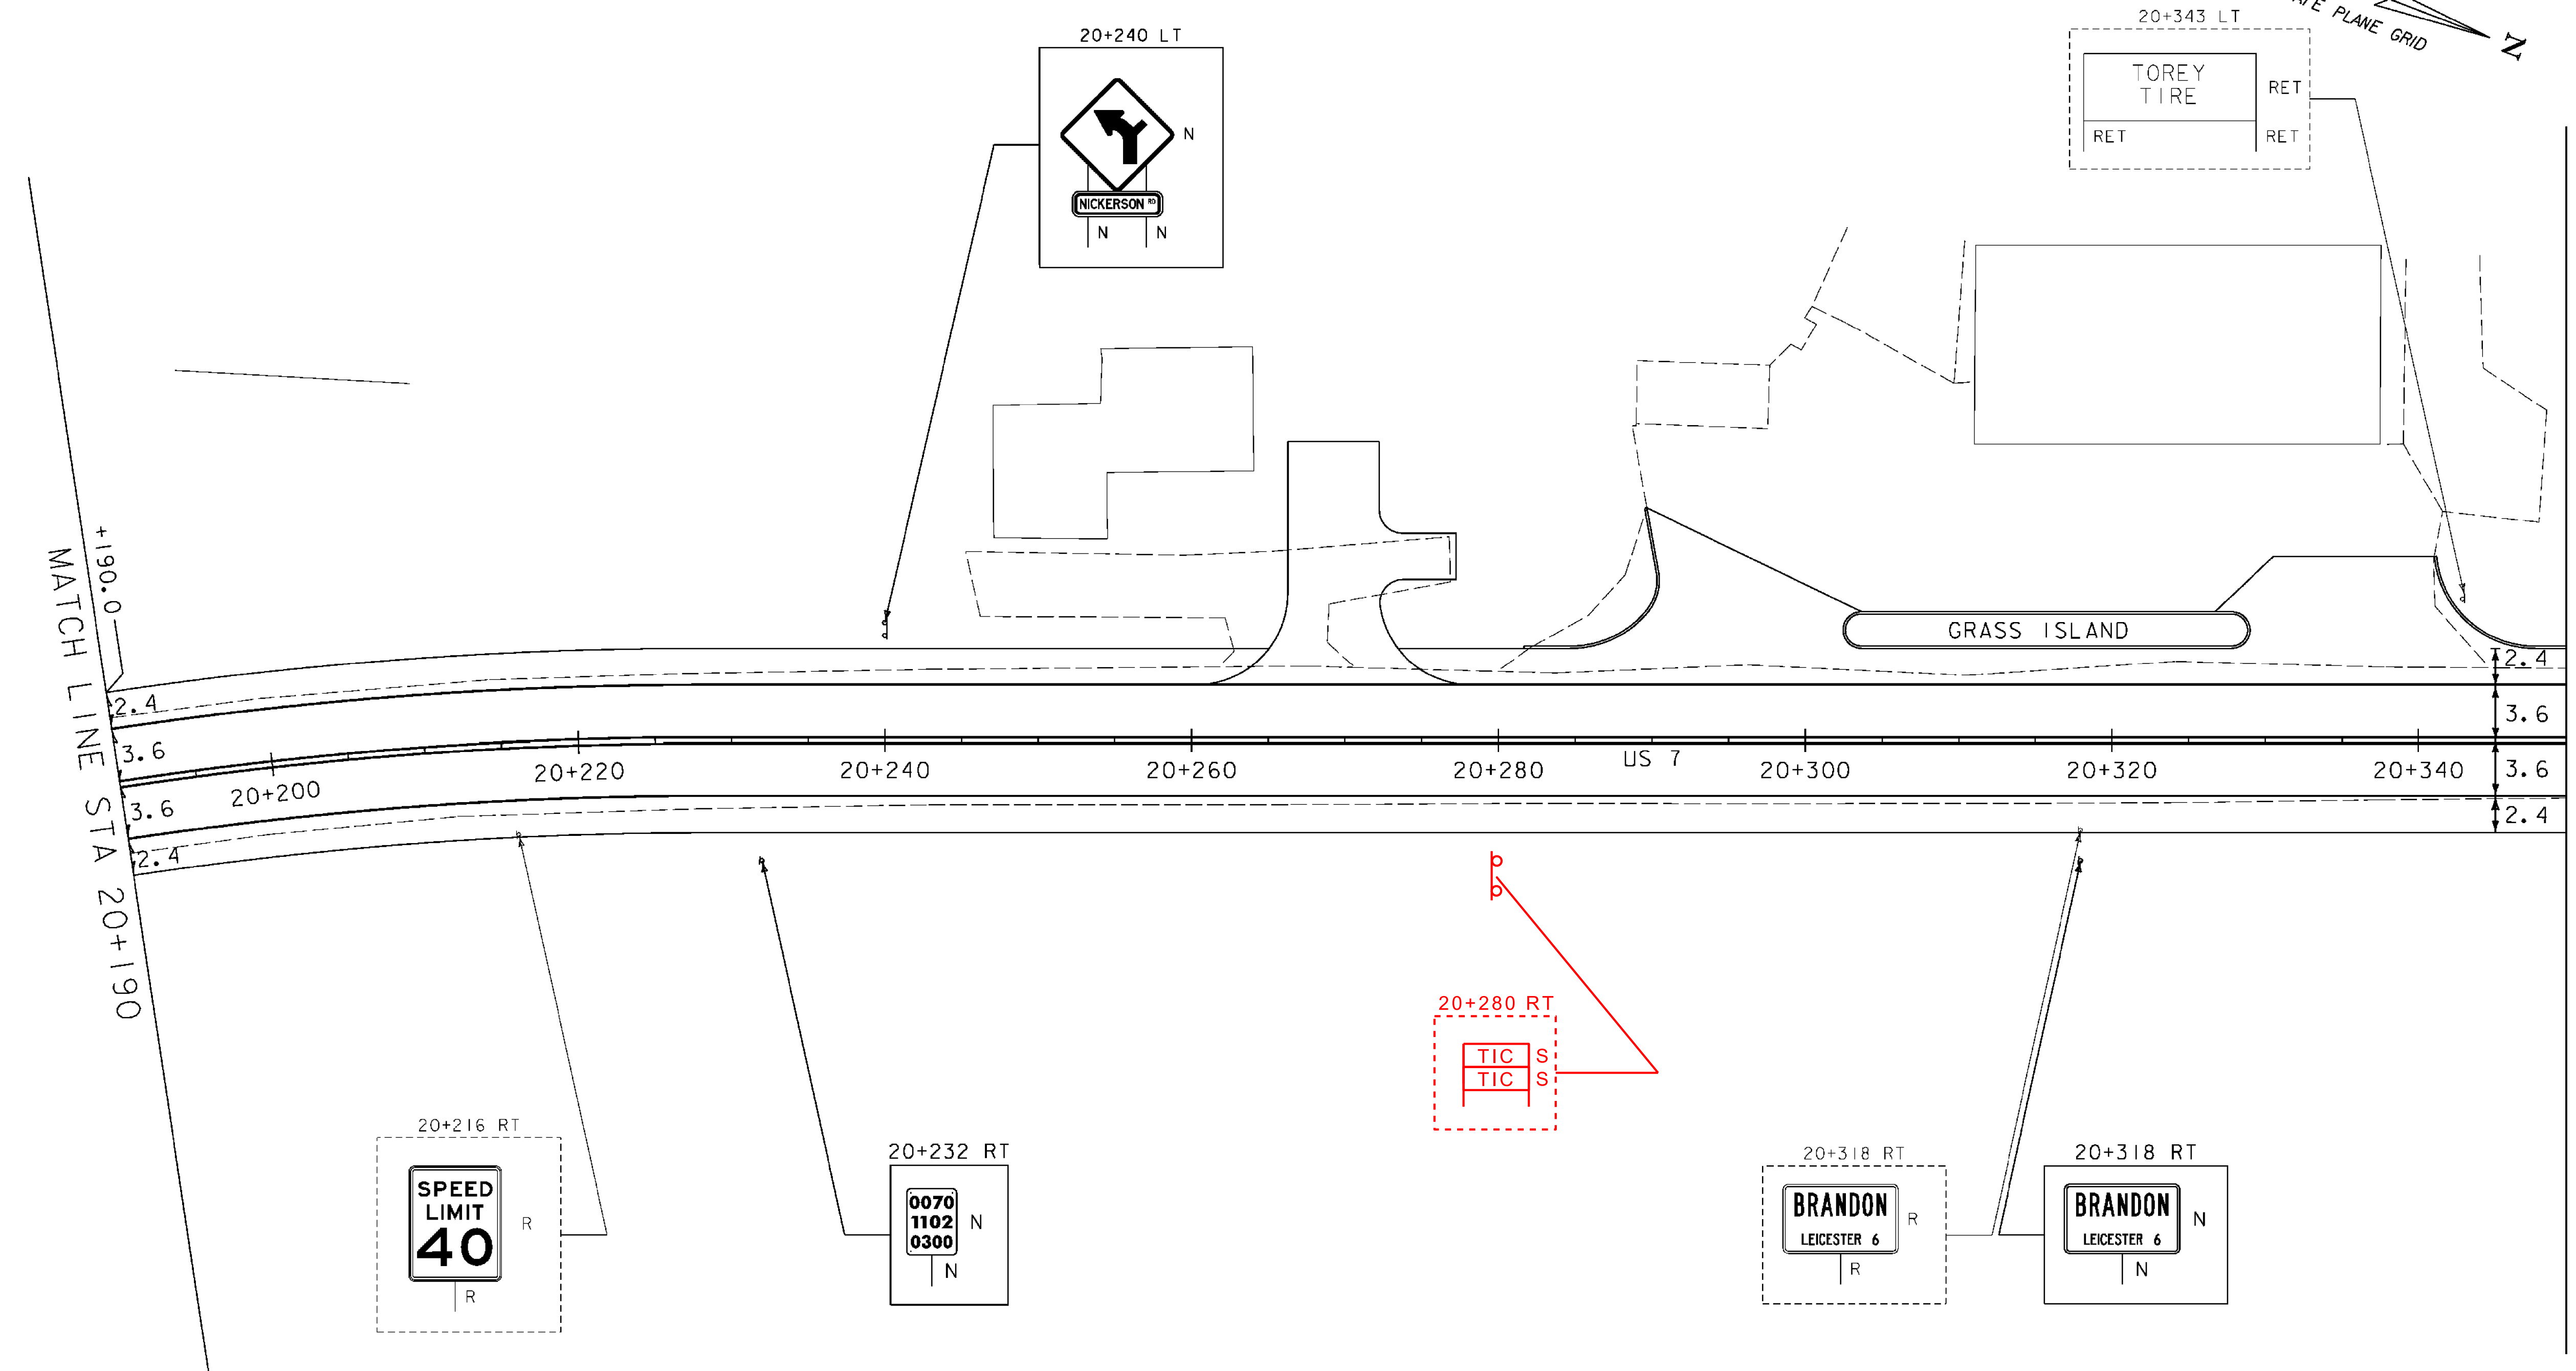


TEMPORARY 100mm WHITE LINE, PAINT
 DURABLE 100mm WHITE LINE, THERMOPLASTIC
 STA 20+190 TO 20+350 SOLID LT & RT

REMOVING SIGNS
 AS SHOWN - 2

TEMPORARY 100mm YELLOW LINE, PAINT
 DURABLE 100mm YELLOW LINE, THERMOPLASTIC
 STA 20+190 TO 20+350 SOLID LT & RT

SALVAGE T.I.C.
 AS SHOWN - 2

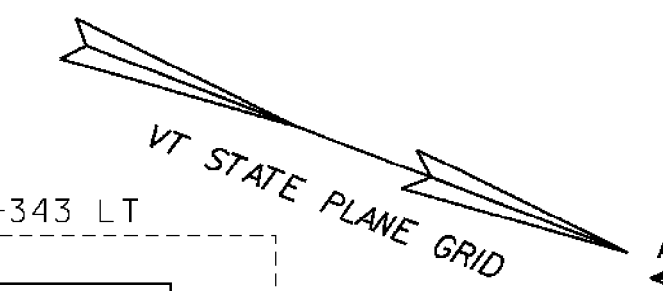

SIGN LEGEND

R	= REMOVE
S	= SALVAGE
N	= NEW
RET	= RETAIN
T&T	= THINNING & TRIMMING
B-B	= BACK TO BACK
EXISTING	-----
NEW	_____



SIGNING & PAVEMENT MARKING 25

PROJECT NAME: BRANDON	PLOT DATE: 9/3/2009
PROJECT NUMBER: NH 019-3(495)	DRAWN BY: HJC
FILE NAME: zb008s5-ts25.dgn	CHECKED BY: PTS
PROJECT LEADER: CRB	SHEET 266 OF 546
DESIGNED BY: NULL	
CLD 02-0149	